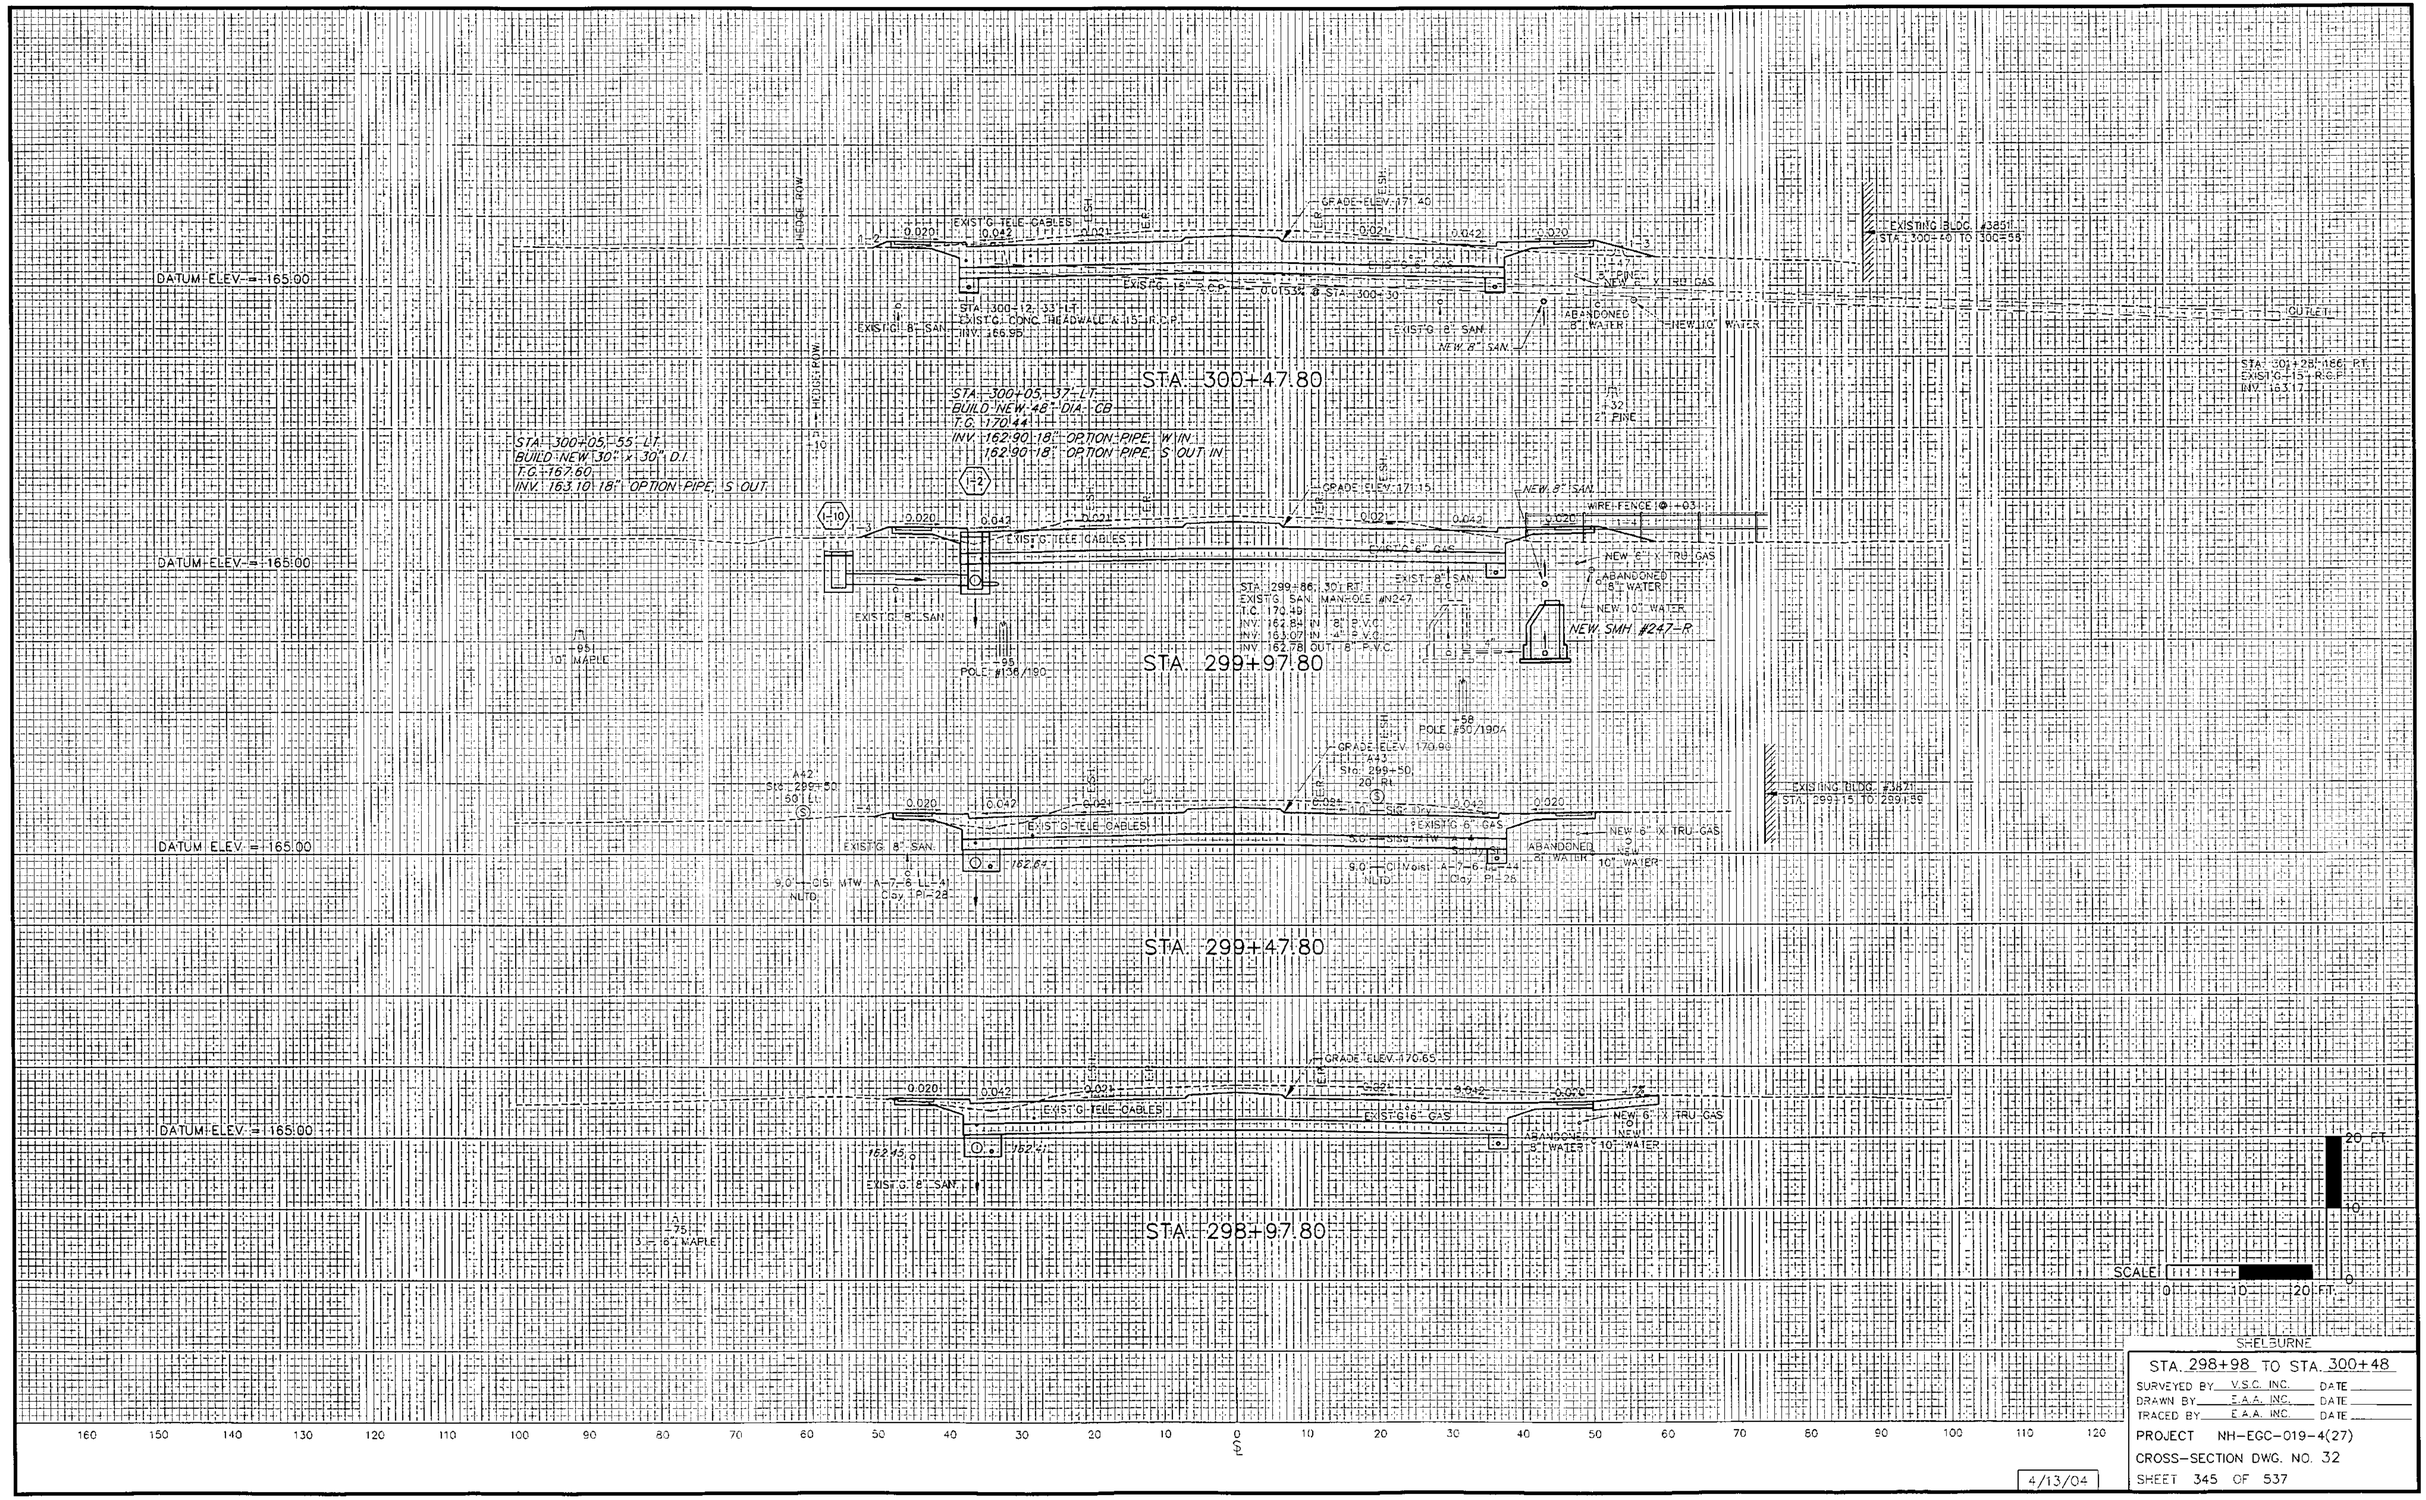
DATUM ELEV. = 165.00
EXIST'G TELE CABLES
GRADE ELEV. 171.40
EXIST'G 15" R.C.P.
STA. 300+12.33 LT.
EXIST'G CONC. HEADWALL & 15" R.C.P.
INV. 166.95
EXIST'G 8" SAN.
EXISTING BLDG. #3851
STA. 300+40 TO 300+55
NEW 6" X TRU. GAS
ABANDONED 8" WATER
NEW 10" WATER
OUTLET
STA. 300+47.80
STA. 300+05.37 LT.
BUILD NEW 48" DIA. CB
T.G. 170.44
INV. 162.90 18" OPTION PIPE, W IN
162.90 18" OPTION PIPE, S OUT IN
STA. 300+05.55 LT.
BUILD NEW 30" x 30" D.I.
T.G. 167.60
INV. 163.10 18" OPTION PIPE, S OUT
STA. 301+28.86 RT.
EXIST'G 15" R.C.P.
INV. 163.17
GRADE ELEV. 171.15
NEW 8" SAN.
WIRE FENCE
EXIST'G 6" GAS
STA. 299+86.30 RT.
EXIST'G SAN. MANHOLE #N247
T.G. 170.45
INV. 162.84 IN 8" P.V.C.
INV. 163.07 IN 4" P.V.C.
INV. 162.78 OUT 8" P.V.C.
NEW SMH #247-R
STA. 299+97.80
POLE #50/190A
GRADE ELEV. 170.90
STA. 299+50 20' Rt.
STA. 299+50 50' Lt.
EXISTING BLDG. #3871
STA. 299+15 TO 299+38
STA. 299+47.80
GRADE ELEV. 170.65
STA. 298+97.80
SCALE
SHELBURNE
STA. 298+98 TO STA. 300+48
SURVEYED BY V.S.C. INC. DATE
DRAWN BY E.A.A. INC. DATE
TRACED BY E.A.A. INC. DATE
PROJECT NH-EGC-019-4(27)
CROSS-SECTION DWG. NO. 32
SHEET 345 OF 537
4/13/04