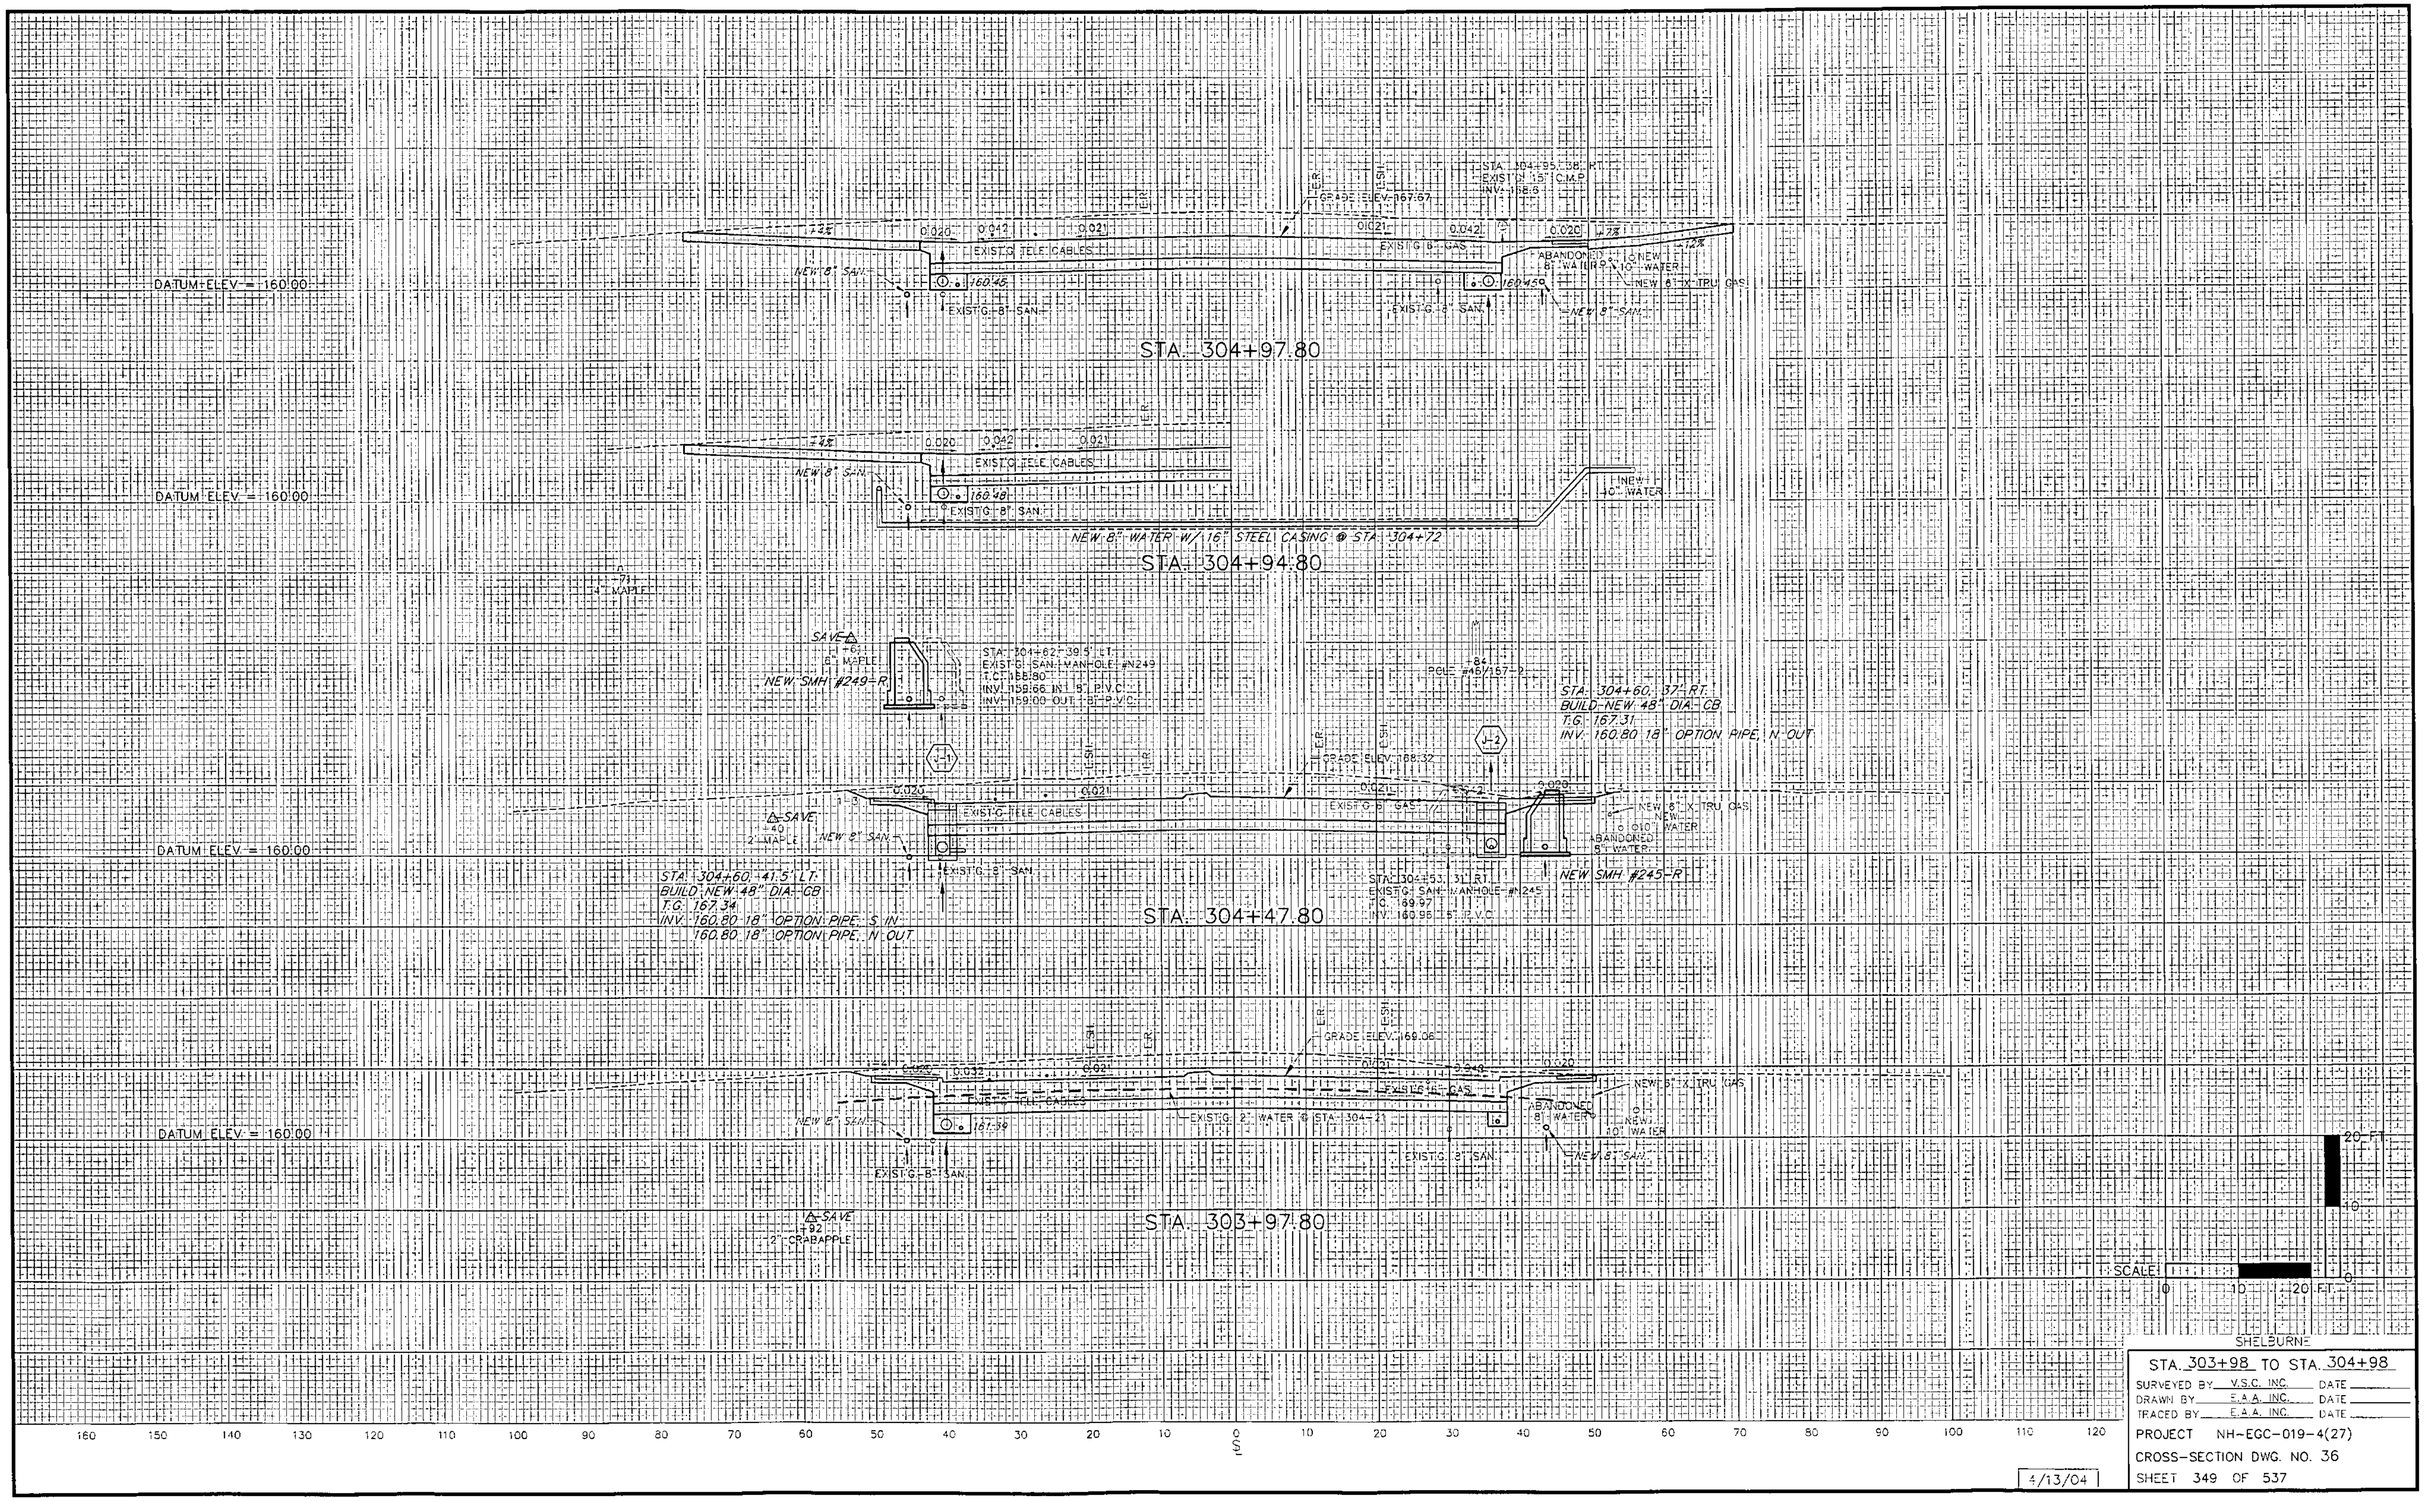
STA. 304+95.58, RT.
EXIST. 15" C.M.P.
INV. 158.6
GRADE ELEV. 167.67
EXIST. TELE. CABLES
EXIST. GAS
ABANDON 8" WATER
NEW 10" WATER
NEW 8" X TRU GAS
NEW 8" SAN.
EXIST. 8" SAN.
DATUM ELEV. = 160.00
STA. 304+97.80
NEW 8" WATER W/ 16" STEEL CASING @ STA. 304+72
STA. 304+94.80
6" MAPLE
SAVE
NEW SMH #249-R
STA. 304+62.39.5' LT.
EXIST. SAN. MANHOLE #249
T.C. 168.80
INV. 159.66 IN 8" P.V.C.
INV. 159.00 OUT 8" P.V.C.
STA. 304+60.37' RT.
BUILD NEW 48" DIA. CB
T.G. 167.31
INV. 160.80 18" OPTION PIPE N OUT
GRADE ELEV. 168.32
2" MAPLE
STA. 304+60.41.5' LT.
BUILD NEW 48" DIA. CB
T.G. 167.34
INV. 160.80 18" OPTION PIPE S IN
160.80 18" OPTION PIPE N OUT
STA. 304+47.80
STA. 304+53.31' RT.
EXIST. SAN. MANHOLE #245
T.C. 169.97
INV. 160.96 15" P.V.C.
NEW SMH #245-R
GRADE ELEV. 169.06
EXIST. 2" WATER @ STA. 304+21
STA. 303+97.80
2" CRABAPPLE
SCALE: 0 10 20 FT.
160 150 140 130 120 110 100 90 80 70 60 50 40 30 20 10 0 10 20 30 40 50 60 70 80 90 100 110 120
4/13/04
SHELBURNE
STA. 303+98 TO STA. 304+98
SURVEYED BY V.S.C. INC. DATE
DRAWN BY E.A.A. INC. DATE
TRACED BY E.A.A. INC. DATE
PROJECT NH-EGC-019-4(27)
CROSS-SECTION DWG. NO. 36
SHEET 349 OF 537