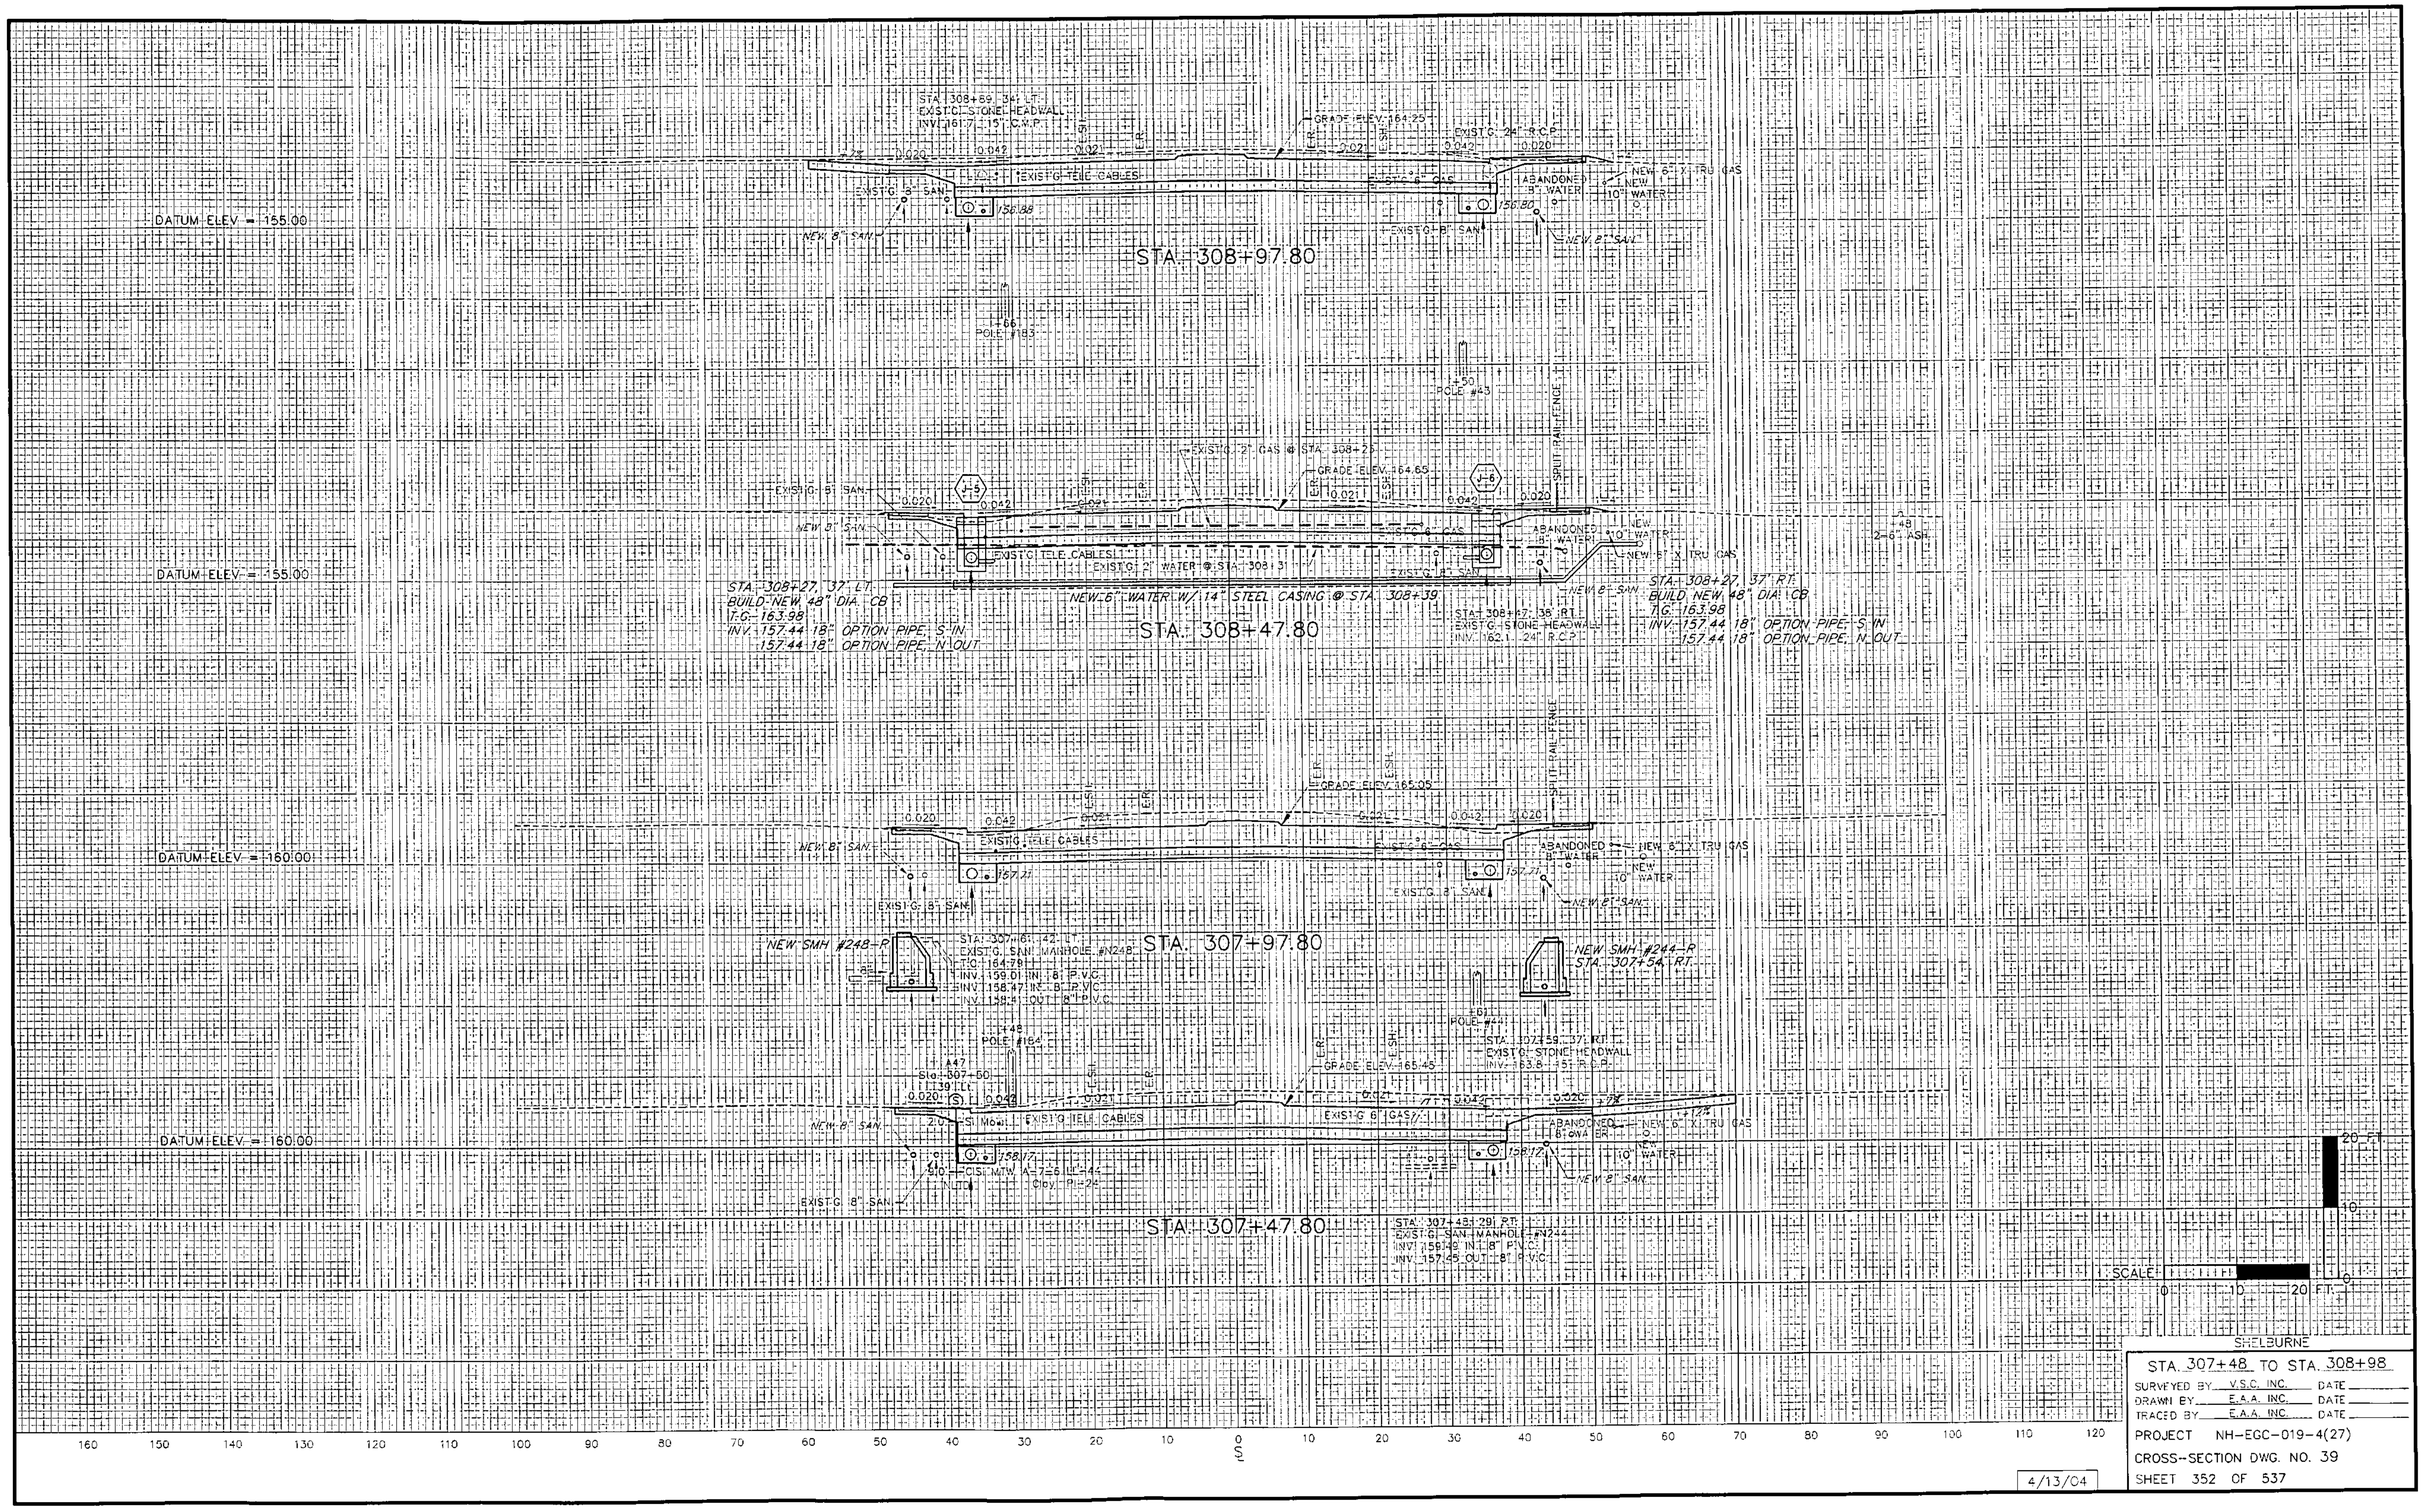

SHELBURNE

STA. 307+48 TO STA. 308+98

SURVEYED BY V.S.C. INC. DATE
DRAWN BY E.A.A. INC. DATE
TRACED BY E.A.A. INC. DATE

PROJECT NH-EGC-019-4(27)

CROSS-SECTION DWG. NO. 39

SHEET 352 OF 537