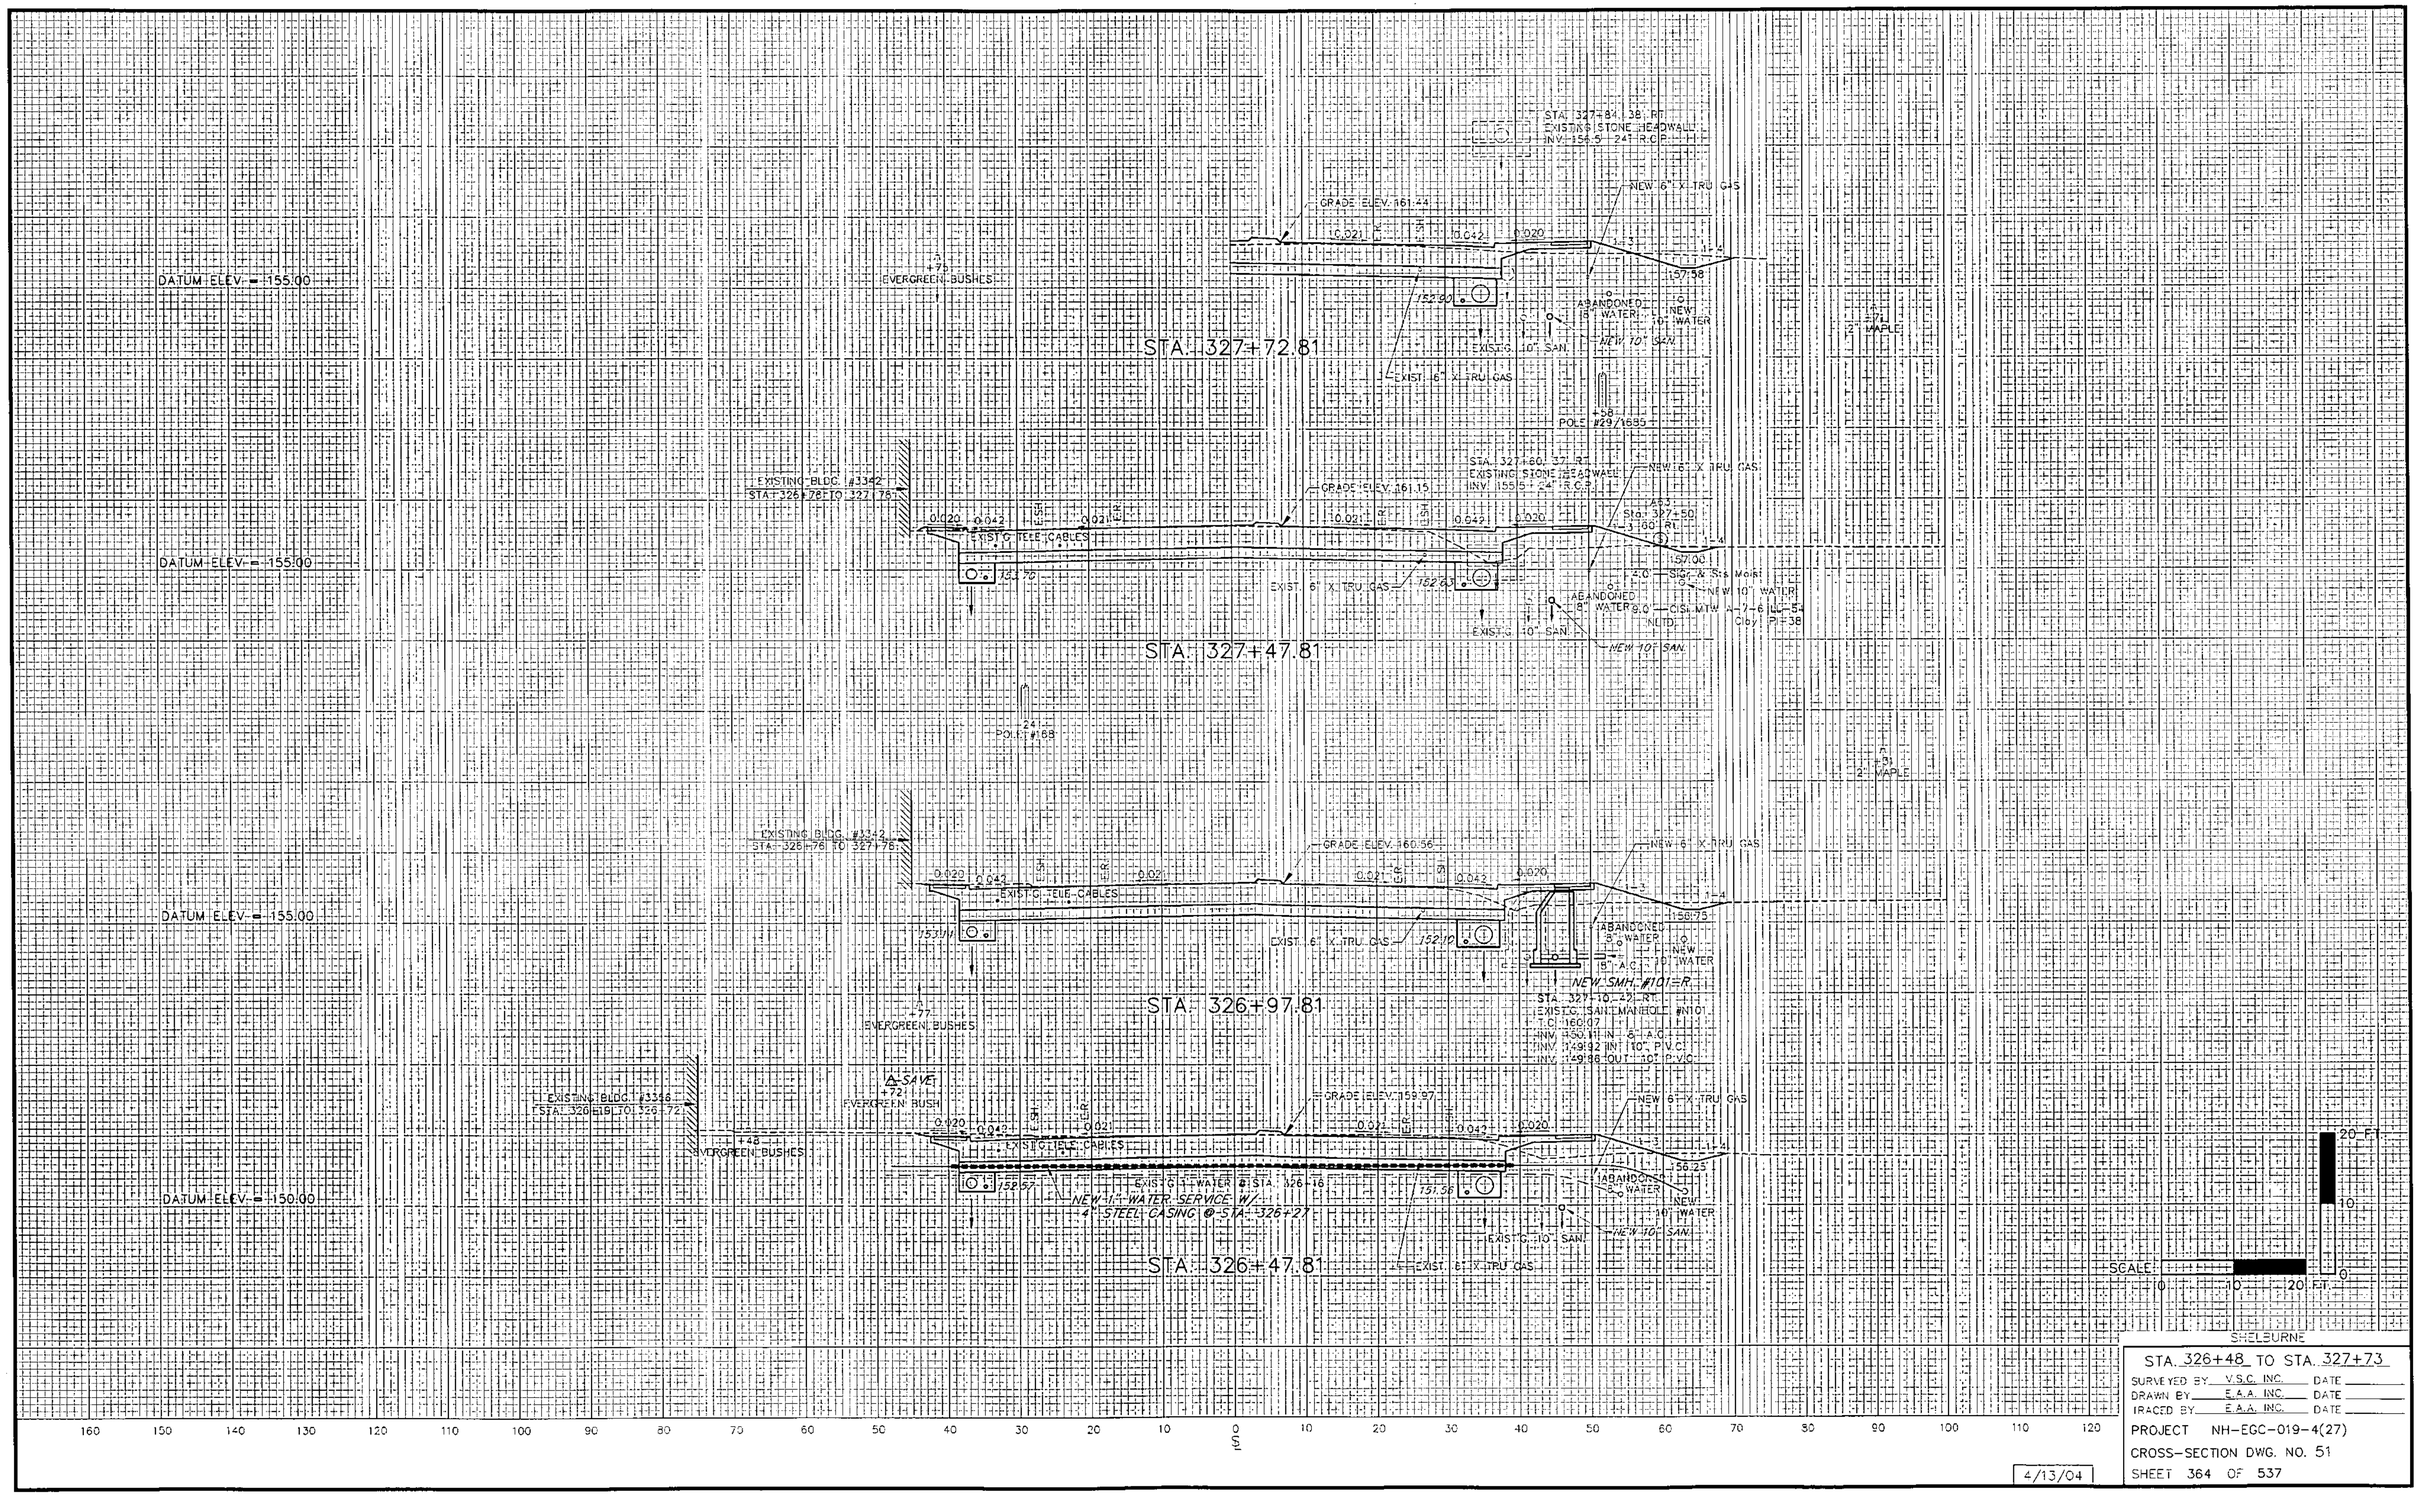

SHELBURNE

STA. 326+48 TO STA. 327+73

SURVEYED BY V.S.C. INC. DATE
DRAWN BY E.A.A. INC. DATE
TRACED BY E.A.A. INC. DATE

PROJECT NH-EGC-019-4(27)

CROSS-SECTION DWG. NO. 51

SHEET 364 OF 537

4/13/04