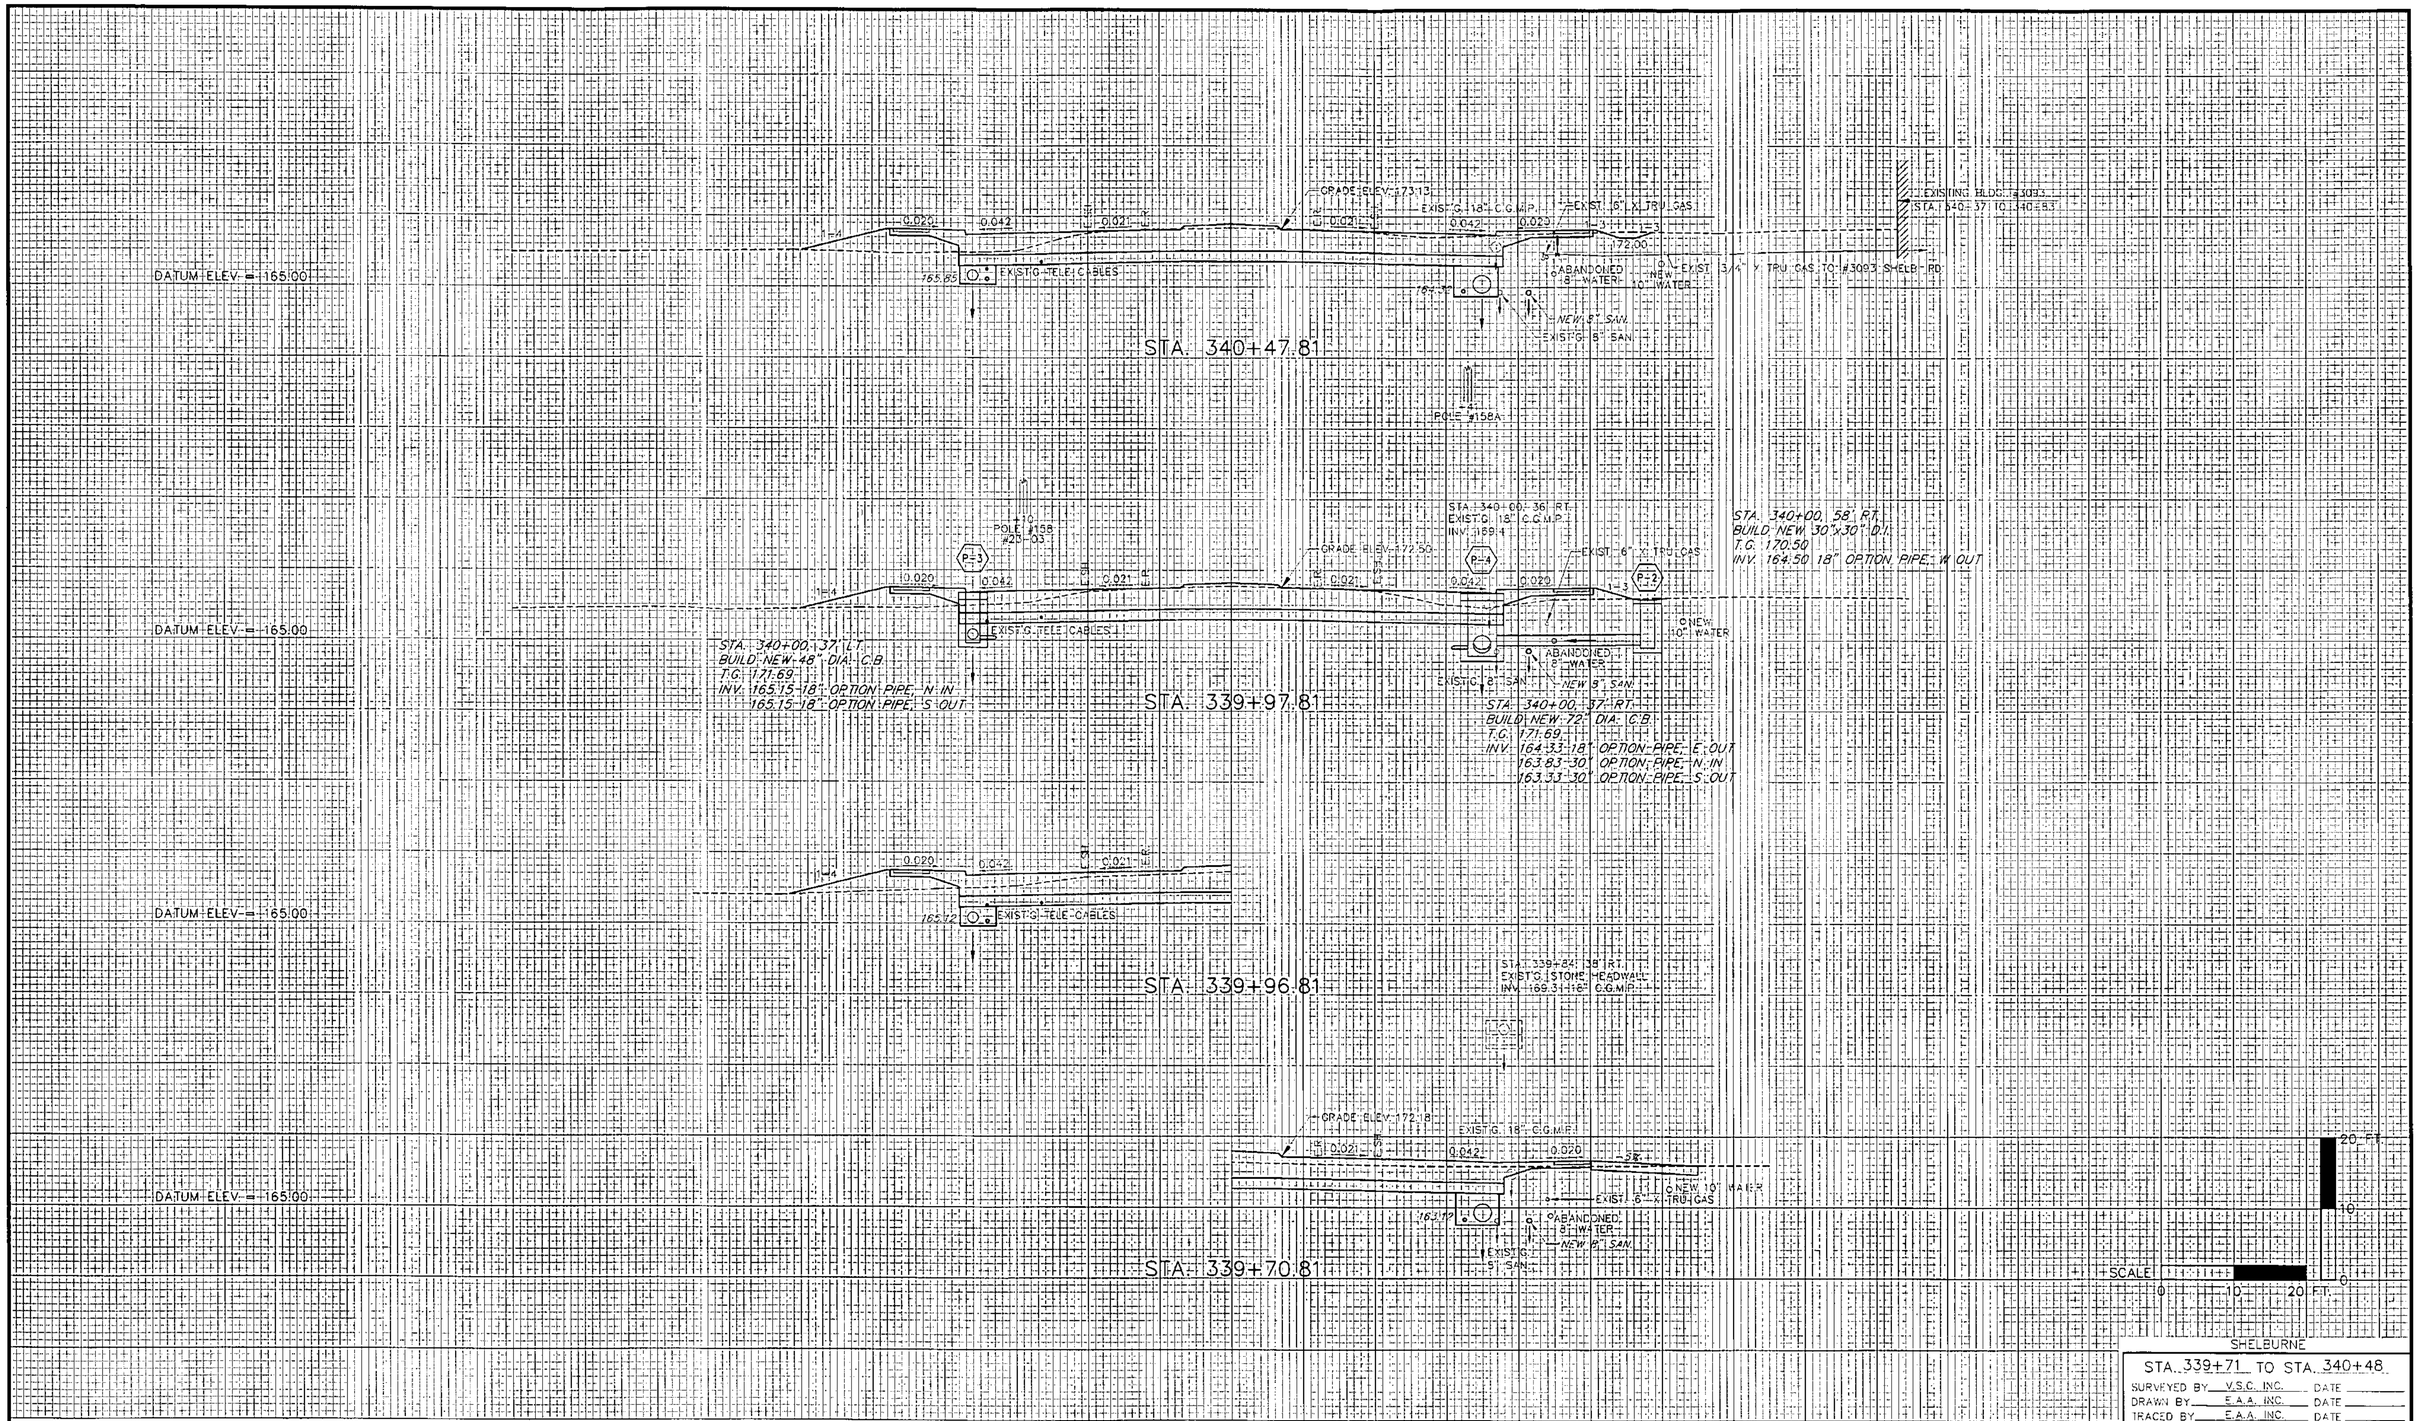
DATUM ELEV. = 165.00
GRADE ELEV. 173.13
EXIST. 18" C.G.M.P.
EXIST. 6" X TRU. GAS
EXISTING BLDG. #3093
STA. 340+37.10 340+83
172.00
ABANDONED 8" WATER
NEW 10" WATER
EXIST. 3/4" Y TRU. GAS TO #3093 SHELB. RD.
NEW 8" SAN.
EXIST. 8" SAN.
STA. 340+47.81
POLE #158A
POLE #158
#21-03
STA. 340+00.36' RT.
EXIST. 18" C.G.M.P.
INV. 169.4
GRADE ELEV. 172.50
STA. 340+00.58' RT.
BUILD NEW 30"x30" D.I.
T.G. 170.50
INV. 164.50 18" OPTION PIPE W OUT
EXIST. TELE. CABLES
STA. 340+00.37' LT.
BUILD NEW 48" DIA. C.B.
T.G. 171.69
INV. 165.15 18" OPTION PIPE N IN
165.15 18" OPTION PIPE S OUT
STA. 339+97.81
STA. 340+00.37' RT.
BUILD NEW 72" DIA. C.B.
T.G. 171.69
INV. 164.33 18" OPTION PIPE E OUT
163.83 30" OPTION PIPE N IN
163.33 30" OPTION PIPE S OUT
STA. 339+96.81
STA. 339+84.38' RT.
EXIST. STONE HEADWALL
INV. 169.34 18" C.G.M.P.
GRADE ELEV. 172.18
STA. 339+70.81
SCALE
20 FT.
10
0
SHELBURNE
STA. 339+71 TO STA. 340+48
SURVEYED BY V.S.C. INC. DATE
DRAWN BY E.A.A. INC. DATE
TRACED BY E.A.A. INC. DATE
PROJECT NH-EGC-019-4(27)
CROSS-SECTION DWG. NO. 60
SHEET 373 OF 537
4/13/04