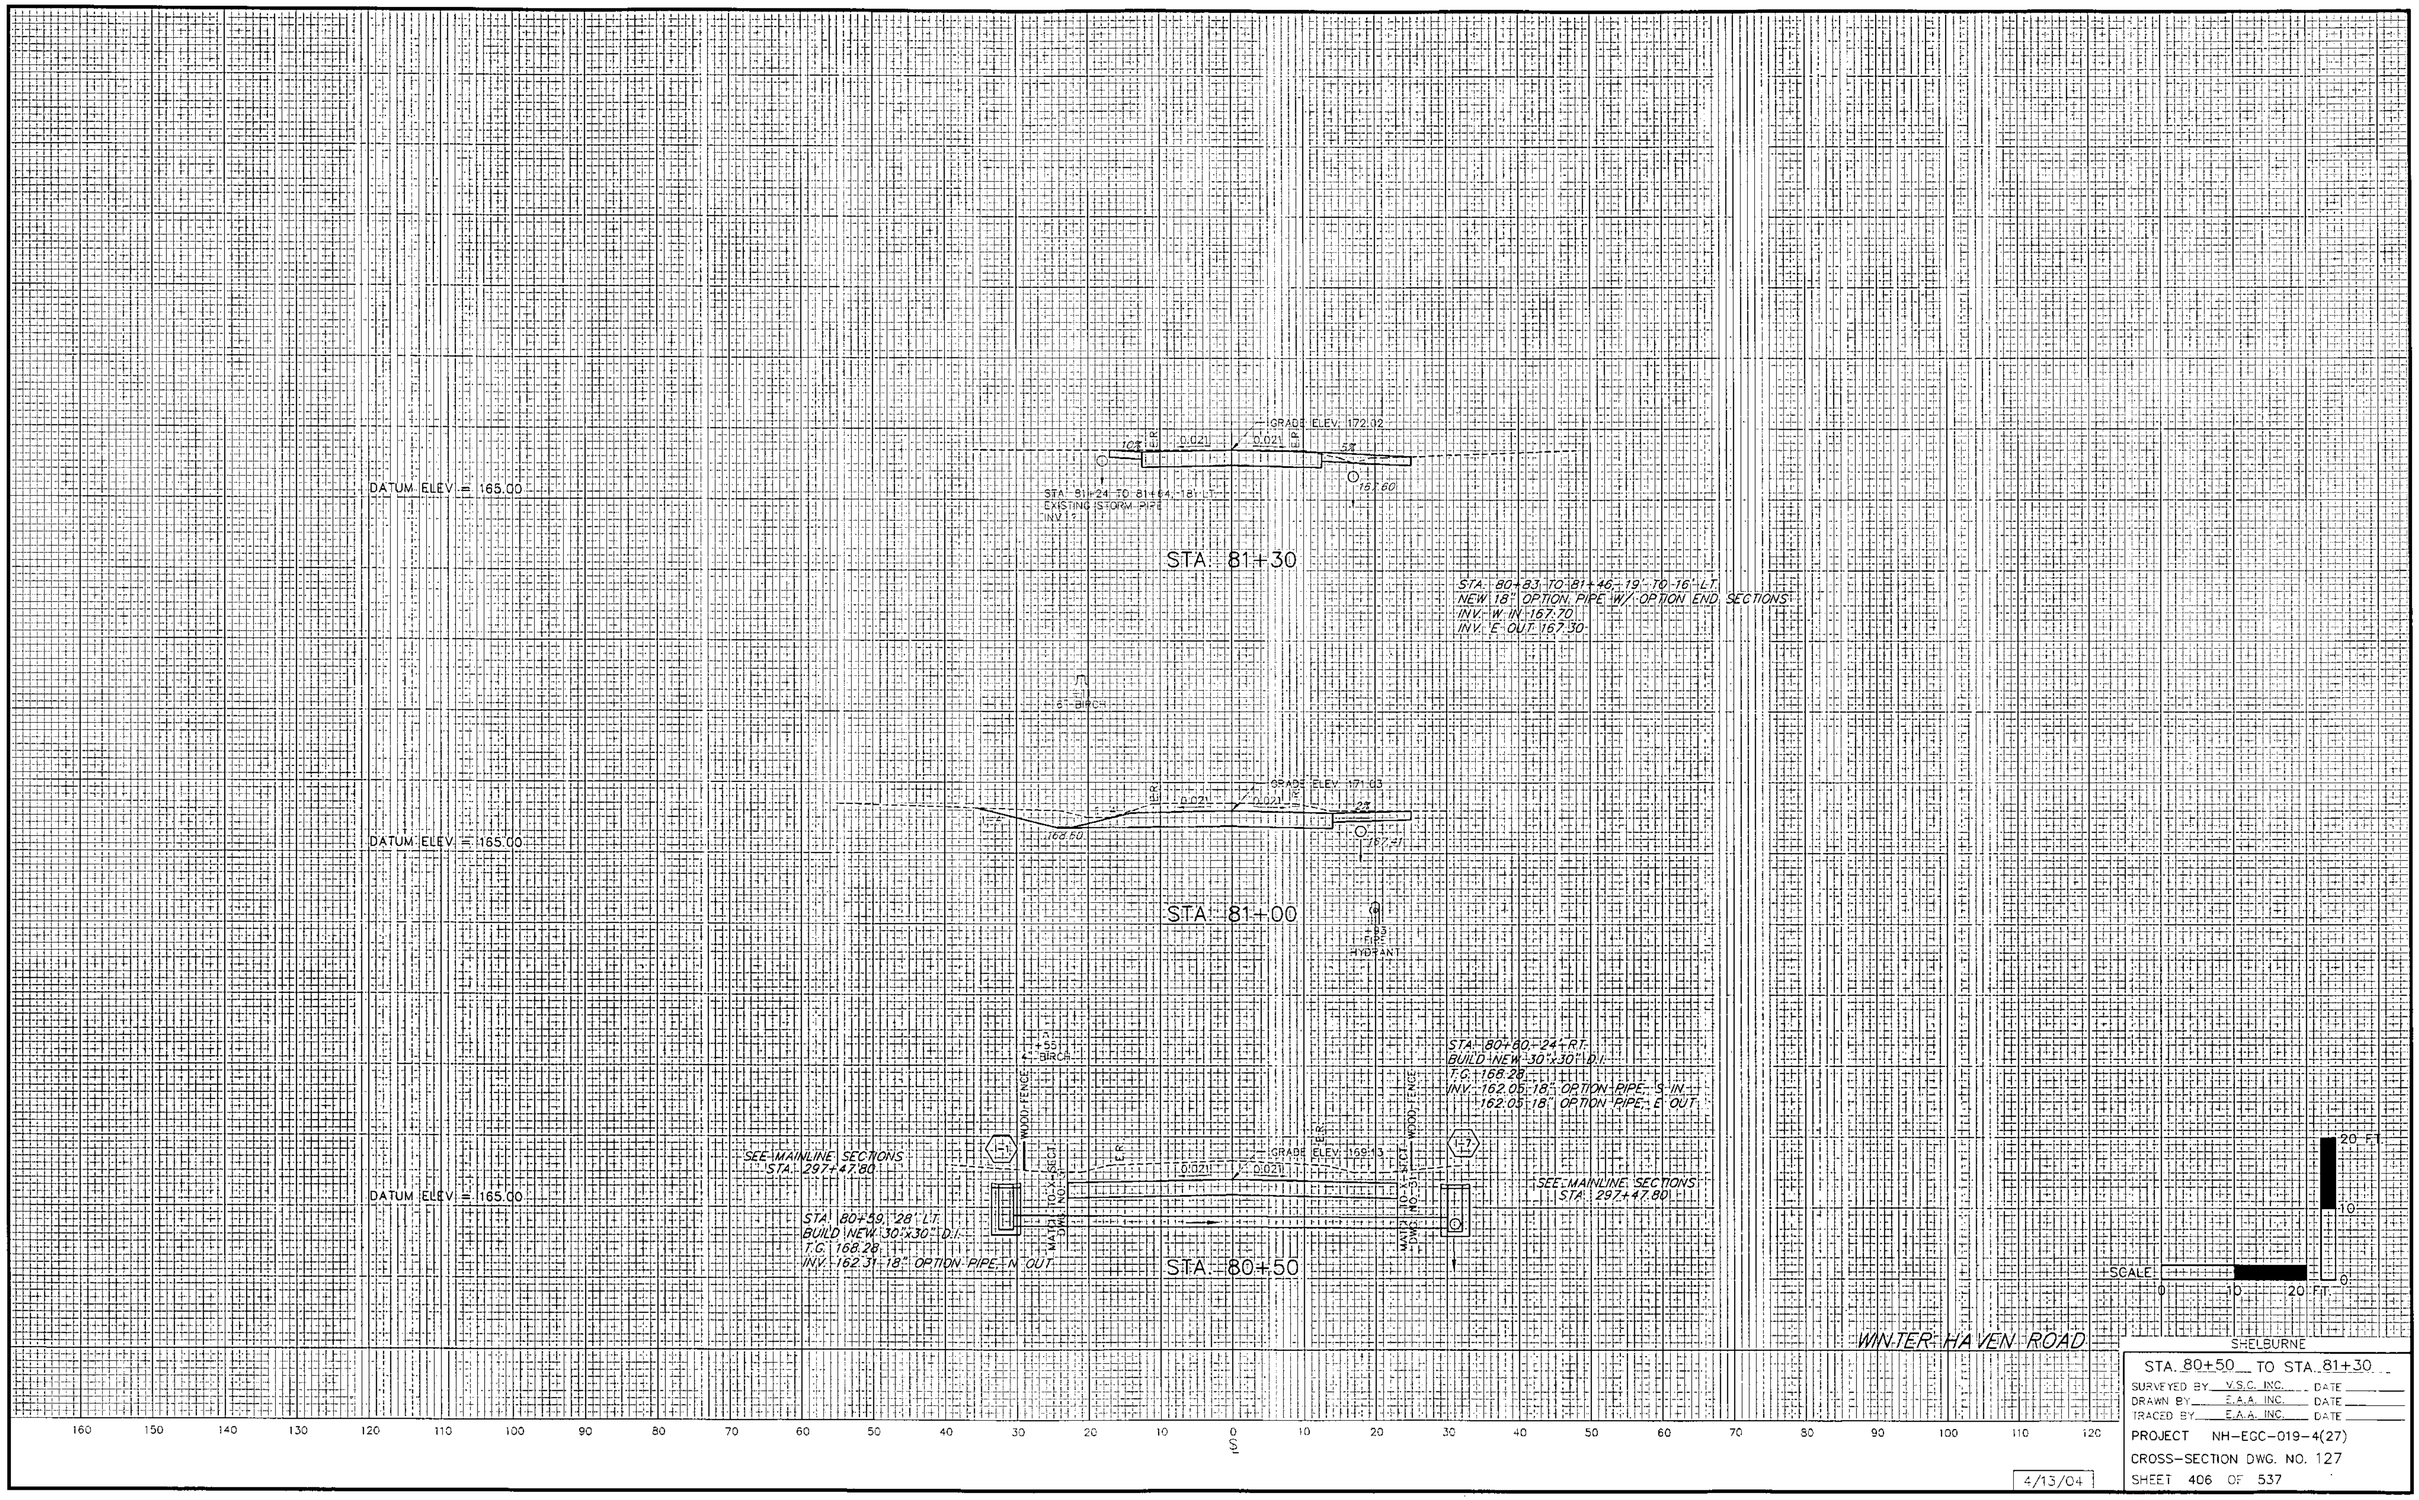
DATUM ELEV. = 165.00
STA. 81+24 TO 81+64, 18" LT.
EXISTING STORM PIPE
INV. 1
10%
0.021
GRADE ELEV. 172.92
0.021
5%
157.60
STA. 81+30
STA. 80+83 TO 81+46, 19" TO 76" LT.
NEW 18" OPTION PIPE W/ OPTION END SECTIONS
INV. W IN 167.70
INV. E OUT 167.30
6" BIRCH
GRADE ELEV. 171.03
0.021
0.021
23
168.60
167.41
DATUM ELEV. = 165.00
STA. 81+00
FIRE HYDRANT
STA. 80+60, 24' RT.
BUILD NEW 30"x30" D.I.
T.G. 168.28
INV. 162.05 18" OPTION PIPE S IN
162.05 18" OPTION PIPE E OUT
WOOD FENCE
30" BIRCH
SEE MAINLINE SECTIONS
STA. 297+47.80
GRADE ELEV. 169.13
0.021
0.021
SEE MAINLINE SECTIONS
STA. 297+47.80
DATUM ELEV. = 165.00
STA. 80+59, 28' LT.
BUILD NEW 30"x30" D.I.
T.G. 168.28
INV. 162.31 18" OPTION PIPE N OUT
STA. 80+50
WINTER HAVEN ROAD
20 FT.
10
0
SCALE
0
10
20 FT.
160 150 140 130 120 110 100 90 80 70 60 50 40 30 20 10 0 10 20 30 40 50 60 70 80 90 100 110 120
(S)
4/13/04
SHELBURNE
STA. 80+50 TO STA. 81+30
SURVEYED BY V.S.C. INC. DATE
DRAWN BY E.A.A. INC. DATE
TRACED BY E.A.A. INC. DATE
PROJECT NH-EGC-019-4(27)
CROSS-SECTION DWG. NO. 127
SHEET 406 OF 537