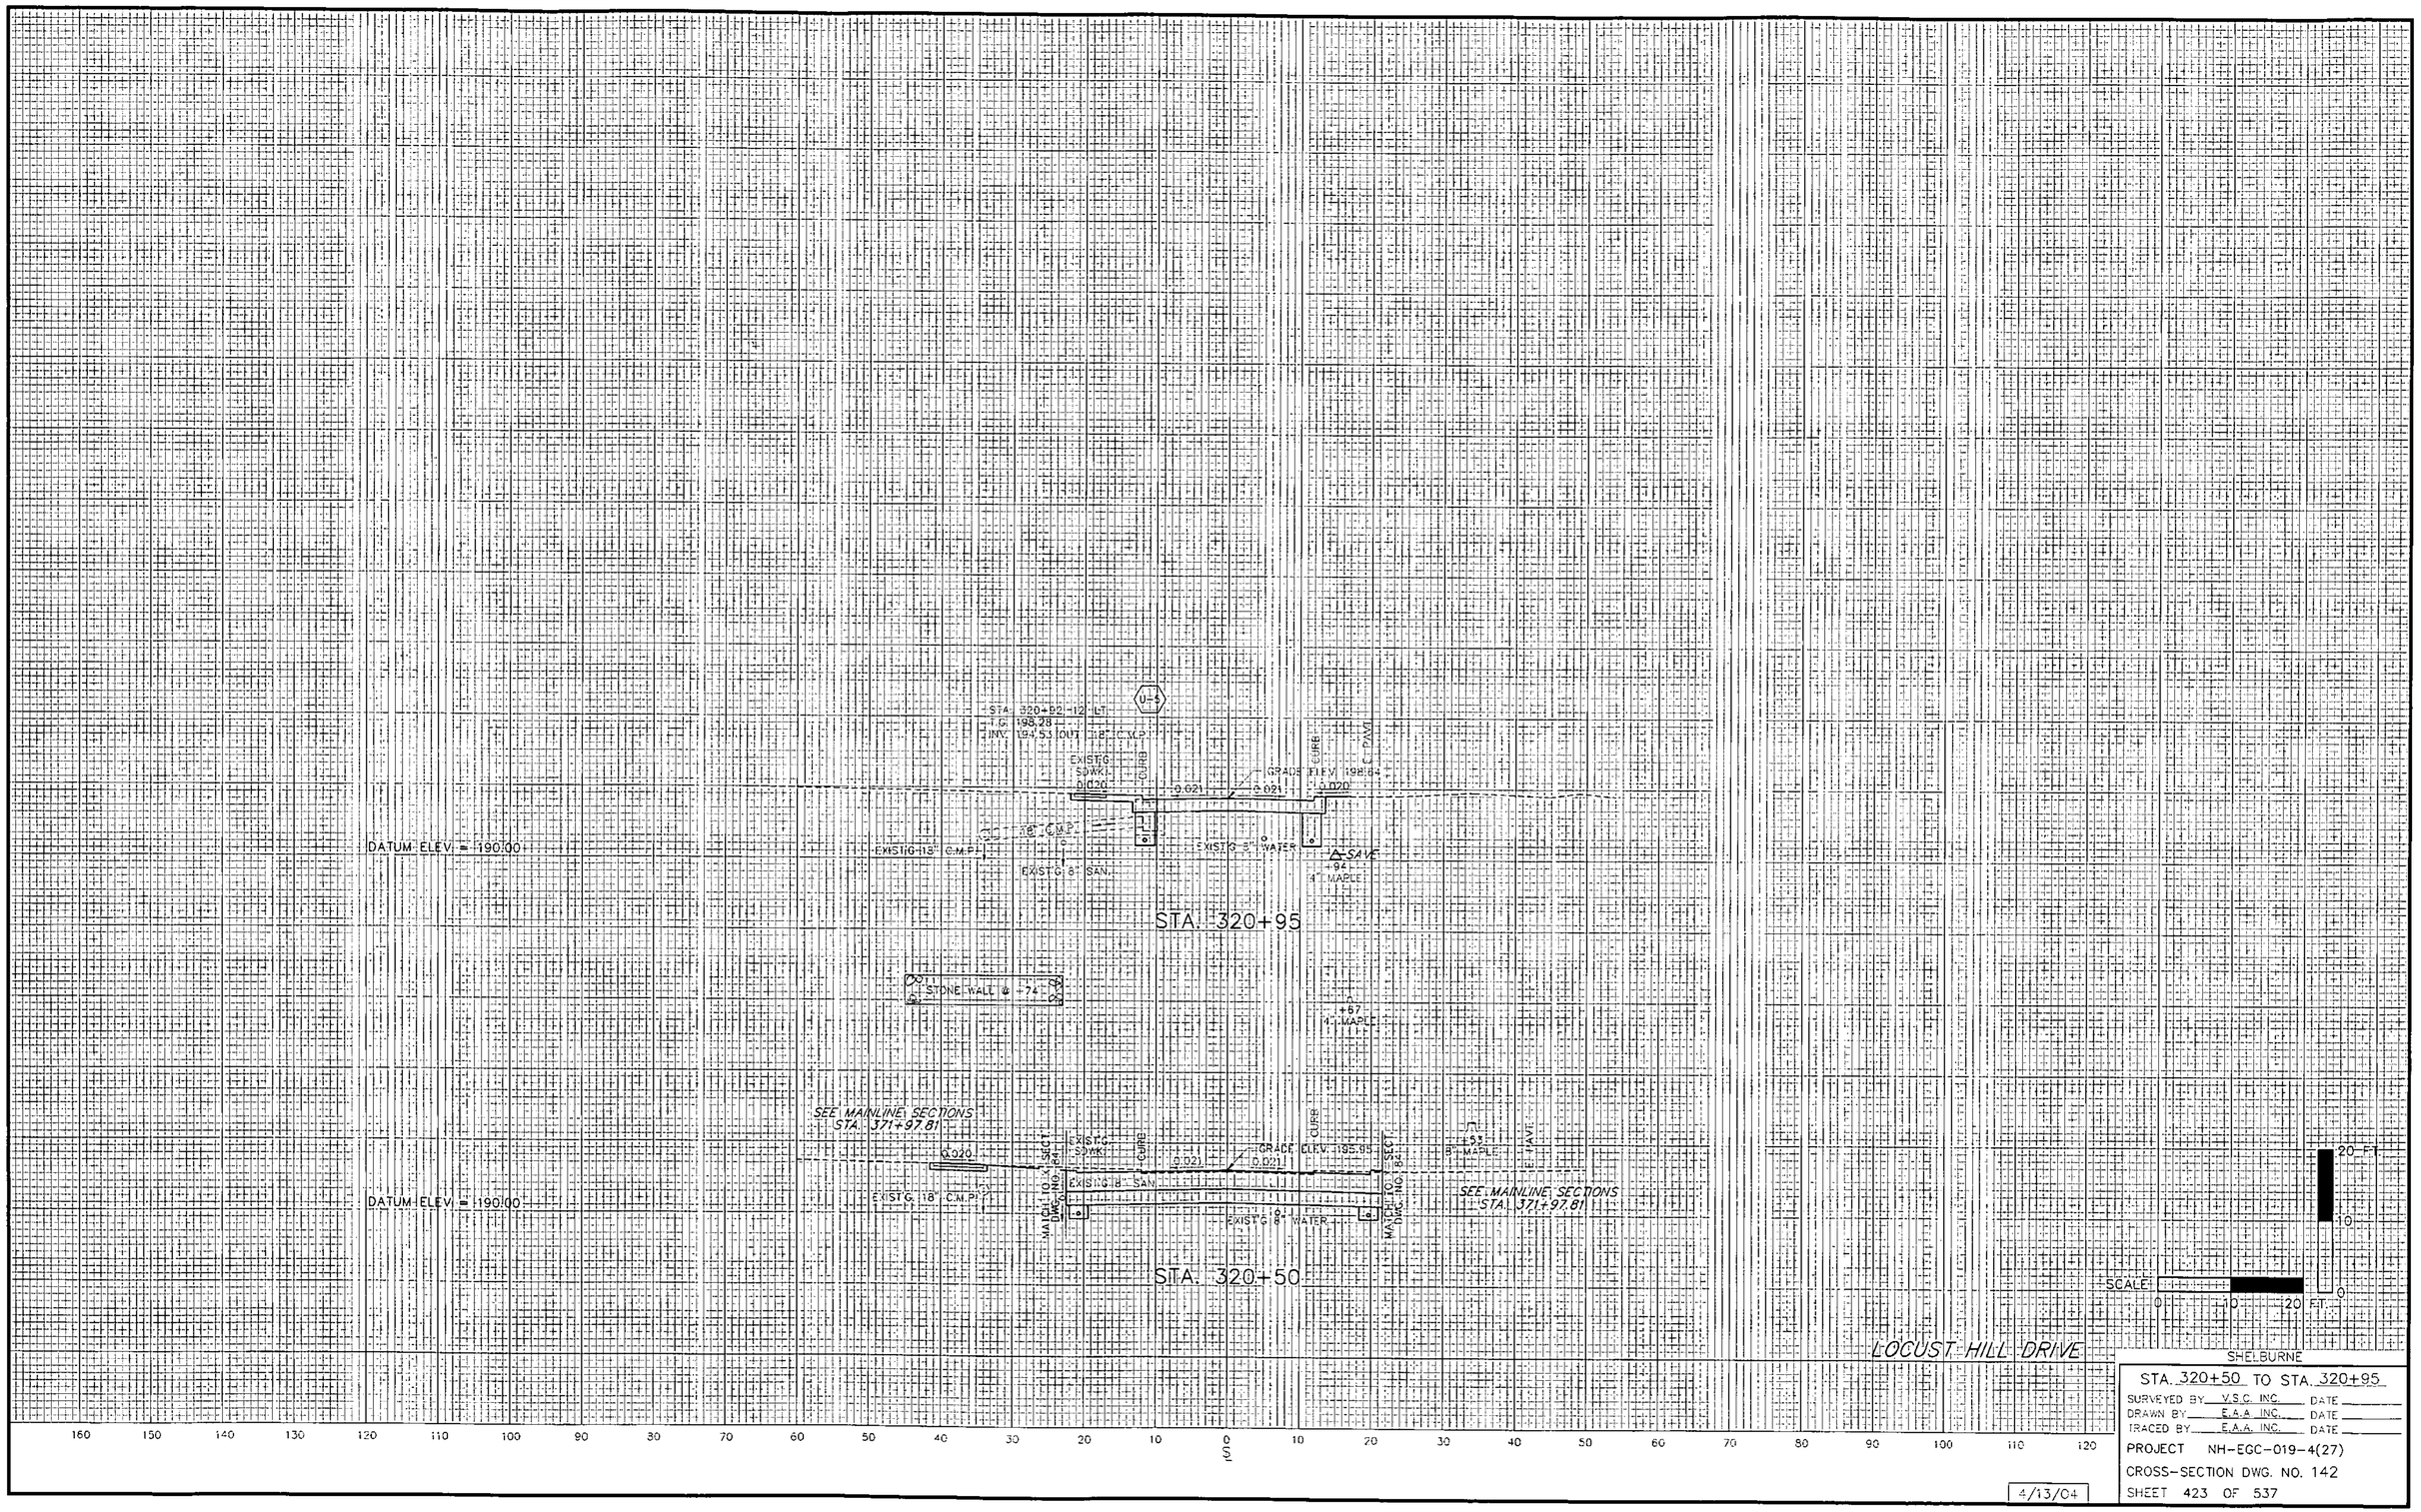

4/13/04

SHELBURNE

STA. 320+50 TO STA. 320+95

SURVEYED BY V.S.C. INC. DATE

DRAWN BY E.A.A. INC. DATE

TRACED BY E.A.A. INC. DATE

PROJECT NH-EGC-019-4(27)

CROSS-SECTION DWG. NO. 142

SHEET 423 OF 537