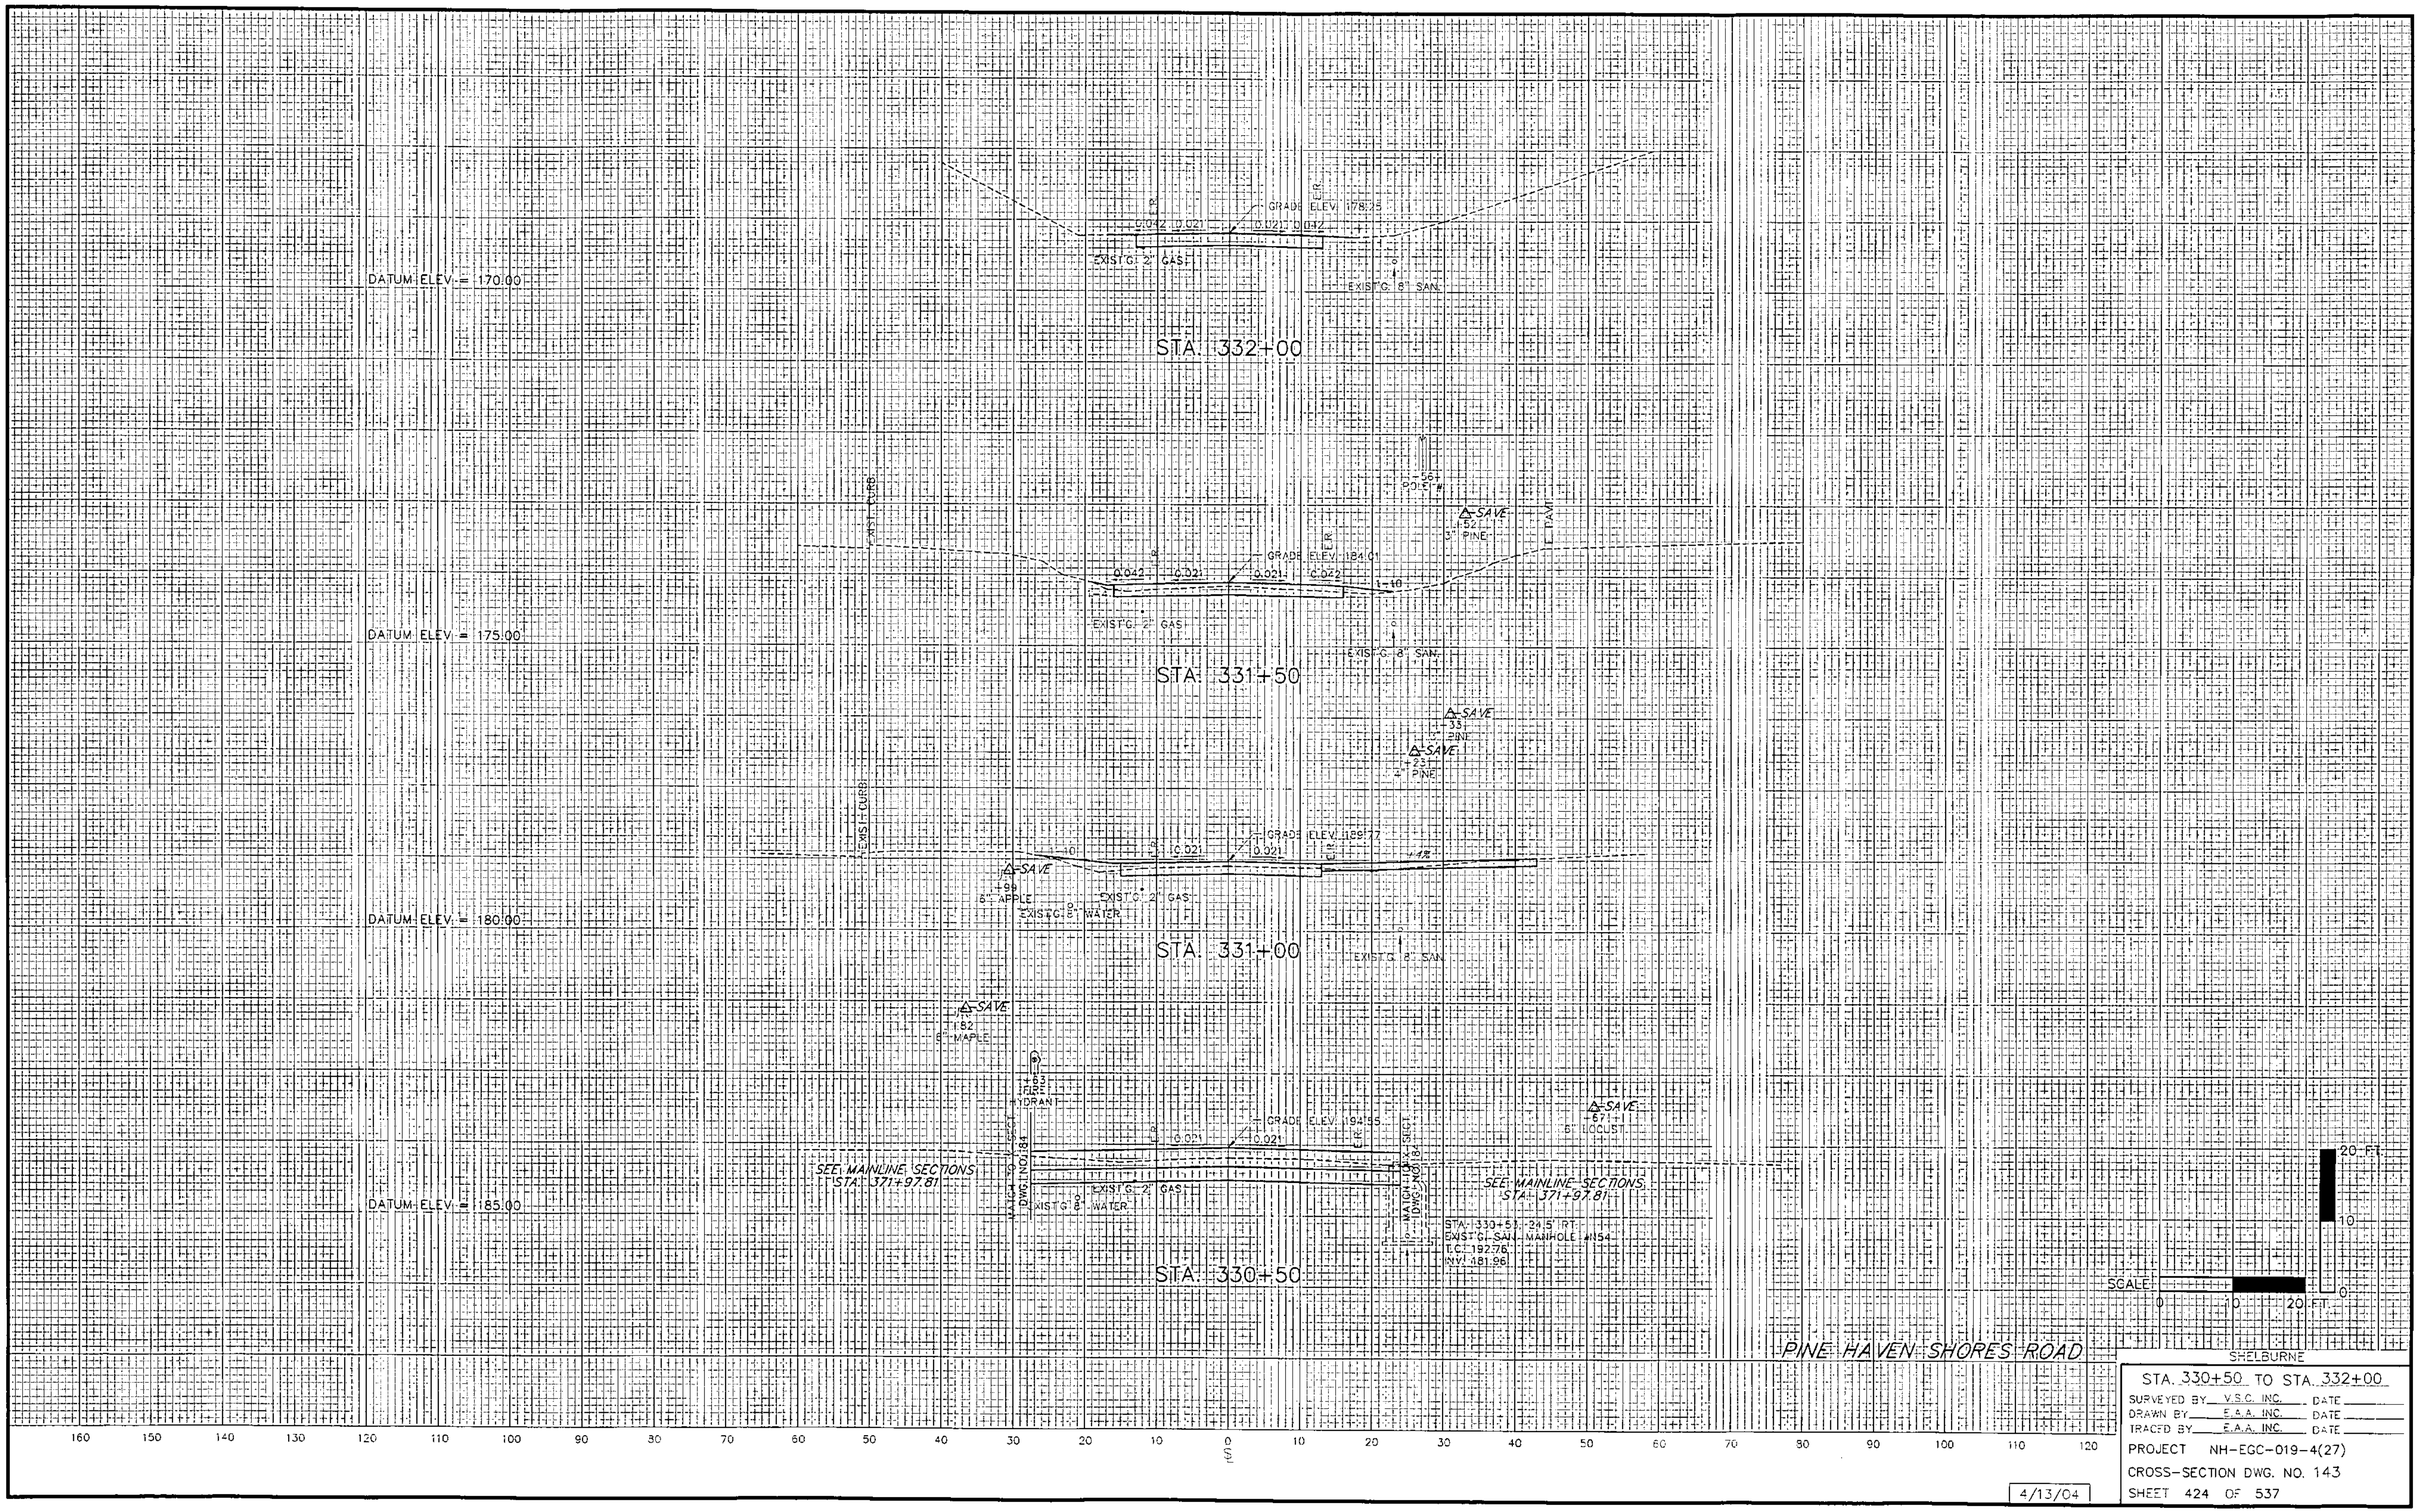
DATUM ELEV. = 170.00
STA. 332+00
GRADE ELEV. 178.25
0.042
0.021
EXIST'G. 2" GAS
EXIST'G. 8" SAN.
DATUM ELEV. = 175.00
STA. 331+50
GRADE ELEV. 184.61
1.40
SAVE
52
3" PINE
POLE #
EXIST. CURB
DATUM ELEV. = 180.00
STA. 331+00
GRADE ELEV. 189.77
SAVE
99
6" APPLE
EXIST'G. 8" WATER
SAVE
33
PINE
SAVE
25
4" PINE
SAVE
82
6" MAPLE
FIRE HYDRANT
DATUM ELEV. = 185.00
STA. 330+50
GRADE ELEV. 194.55
SAVE
67
6" LOCUST
SEE MAINLINE SECTIONS STA. 371+97.81
MAIN LINE SECT. DWG. NO. 184
STA. 330+51.24.5' RT.
EXIST'G. SAN. MANHOLE #154
T.C. 192.76
INV. 181.96
PINE HAVEN SHORES ROAD
SCALE
20 FT.
10
0
20 FT.
SHELBURNE
STA. 330+50 TO STA. 332+00
SURVEYED BY V.S.C. INC. DATE
DRAWN BY E.A.A. INC. DATE
TRACED BY E.A.A. INC. DATE
PROJECT NH-EGC-019-4(27)
CROSS-SECTION DWG. NO. 143
SHEET 424 OF 537
4/13/04