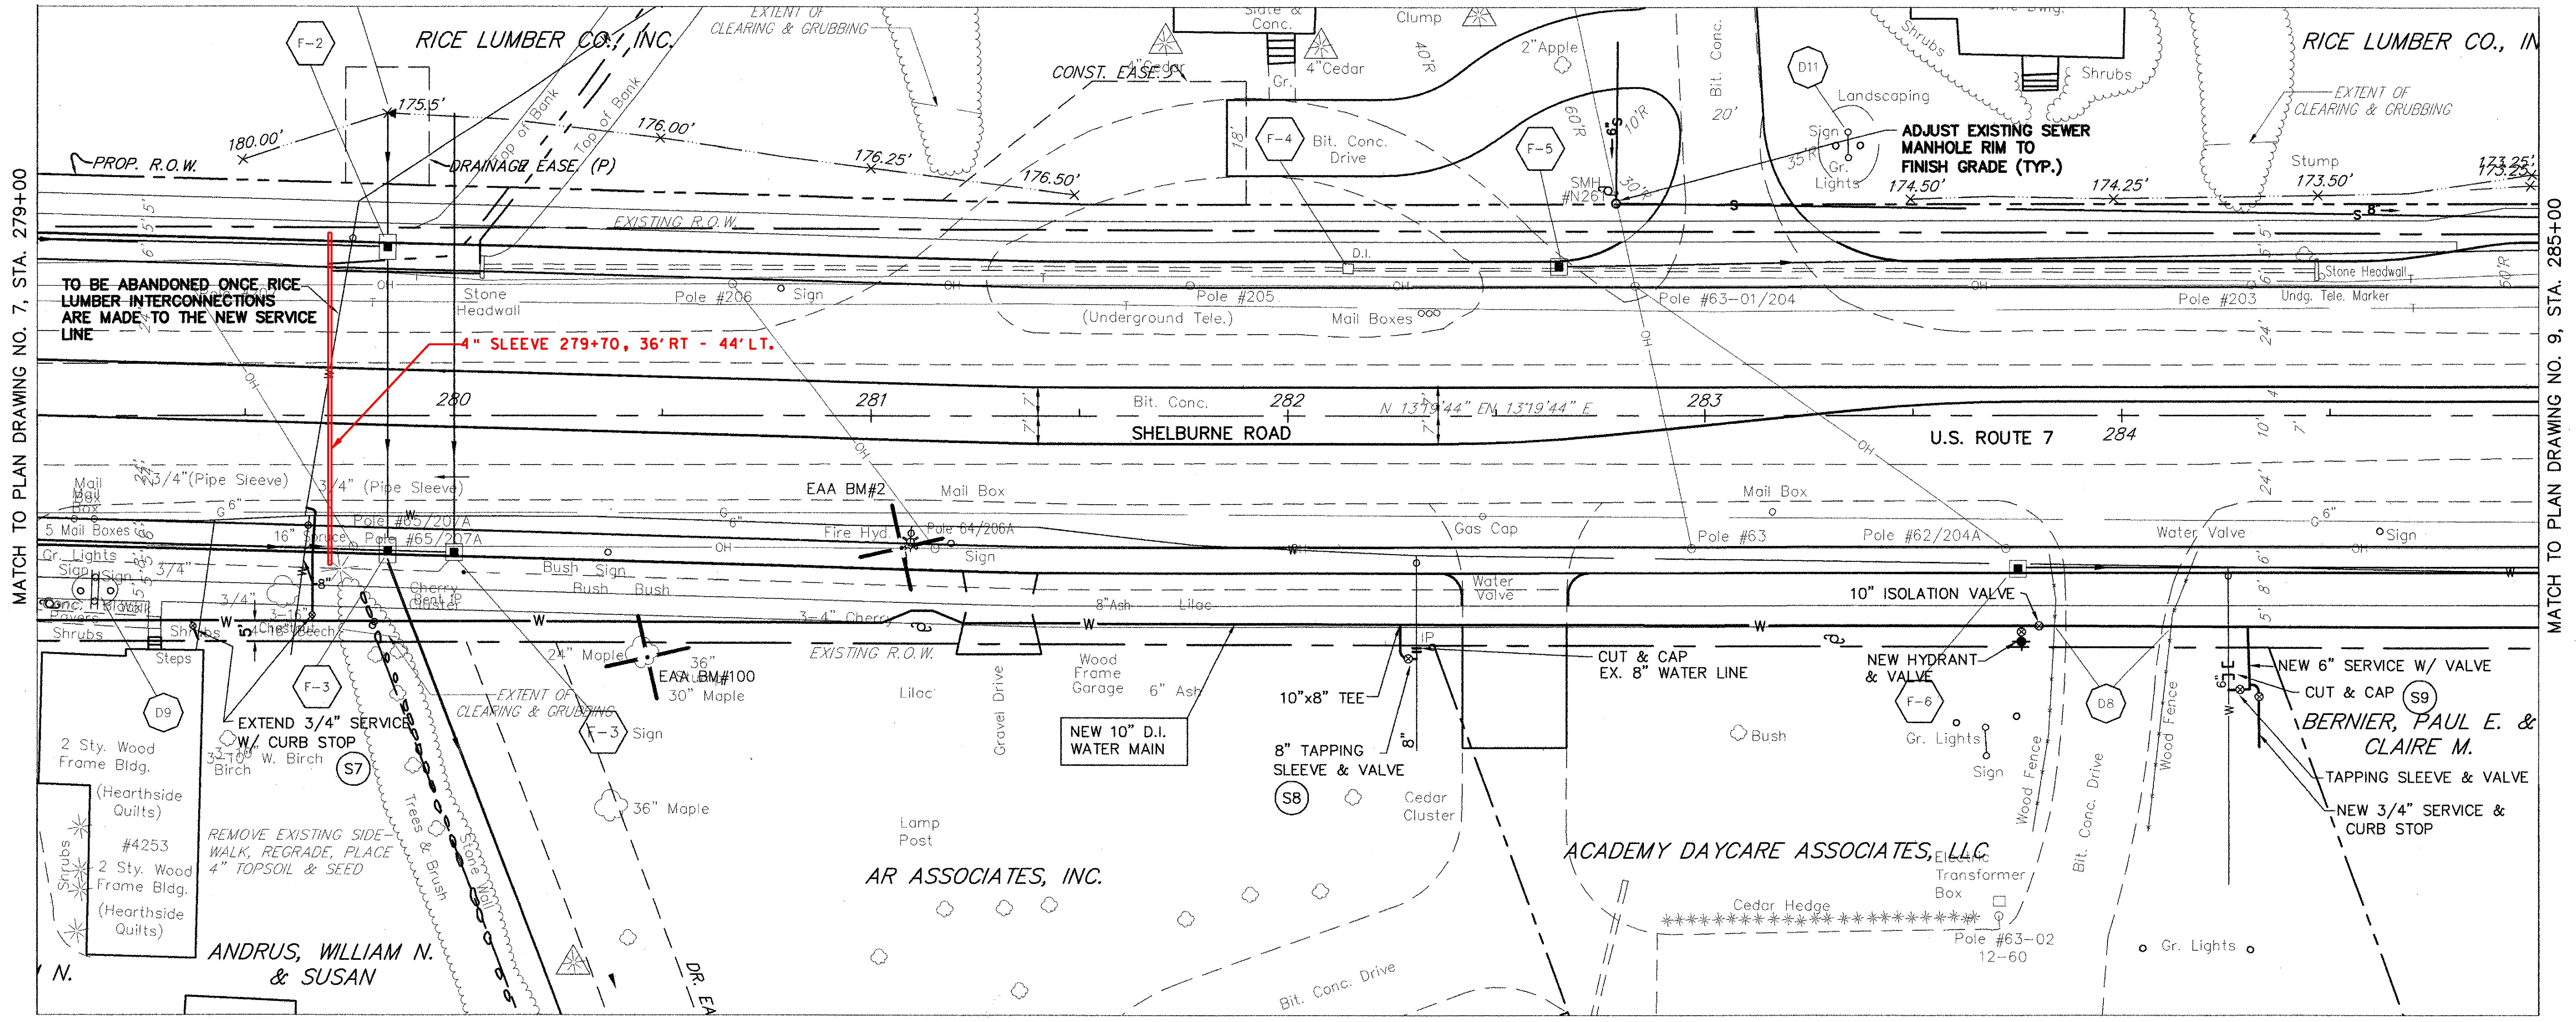
MATCH TO PLAN DRAWING NO. 7, STA. 279+00
MATCH TO PLAN DRAWING NO. 9, STA. 285+00
RICE LUMBER CO., INC.
PROP. R.O.W.
EXISTING R.O.W.
DRAINAGE EASE. (P)
CONST. EASE.
EXTENT OF CLEARING & GRUBBING
TO BE ABANDONED ONCE RICE LUMBER INTERCONNECTIONS ARE MADE TO THE NEW SERVICE LINE
4" SLEEVE 279+70, 36'RT - 44'LT.
SHELBURNE ROAD
U.S. ROUTE 7
N 13°19'44" E
280
281
282
283
284
EAA BM#2
EAA BM#100
EXTEND 3/4" SERVICE W/ CURB STOP
REMOVE EXISTING SIDEWALK, REGRADE, PLACE 4" TOPSOIL & SEED
ANDRUS, WILLIAM N. & SUSAN
AR ASSOCIATES, INC.
ACADEMY DAYCARE ASSOCIATES, LLC
BERNIER, PAUL E. & CLAIRE M.
NEW 10" D.I. WATER MAIN
10"x8" TEE
8" TAPPING SLEEVE & VALVE
CUT & CAP EX. 8" WATER LINE
10" ISOLATION VALVE
NEW HYDRANT & VALVE
NEW 6" SERVICE W/ VALVE
CUT & CAP
TAPPING SLEEVE & VALVE
NEW 3/4" SERVICE & CURB STOP
ADJUST EXISTING SEWER MANHOLE RIM TO FINISH GRADE (TYP.)
SMH #N261
S7
S8
S9
F-2
F-3
F-4
F-5
F-6
D8
D9
D11
VT. STATE PLANE GRID

PLAN

1" = 20'


EX. MH #N261
RIM=178.2
STA. 282+81
NEW RIM=176.7±
INV. IN=172.2
INV. OUT=172.0
EXISTING GRADE
FINISH GRADE
INSTALL 2" RIGID INSULATION OVER EXISTING SEWER LINE WHERE COVER IS LESS THAN 5'.
EX. 8" SEWER LINE
184
182
180
178
176
174
172
170
168
166
164
162
279+00
280+00
281+00
282+00
283+00
284+00

PROFILE

1" = 4' VERTICAL
1" = 20' HORIZONTAL

RECORD DRAWING REVISIONS

NO.	DATE	DESCRIPTION
1.	11/10/09	FIELD MARK UPS ADDED TO THE PLANS

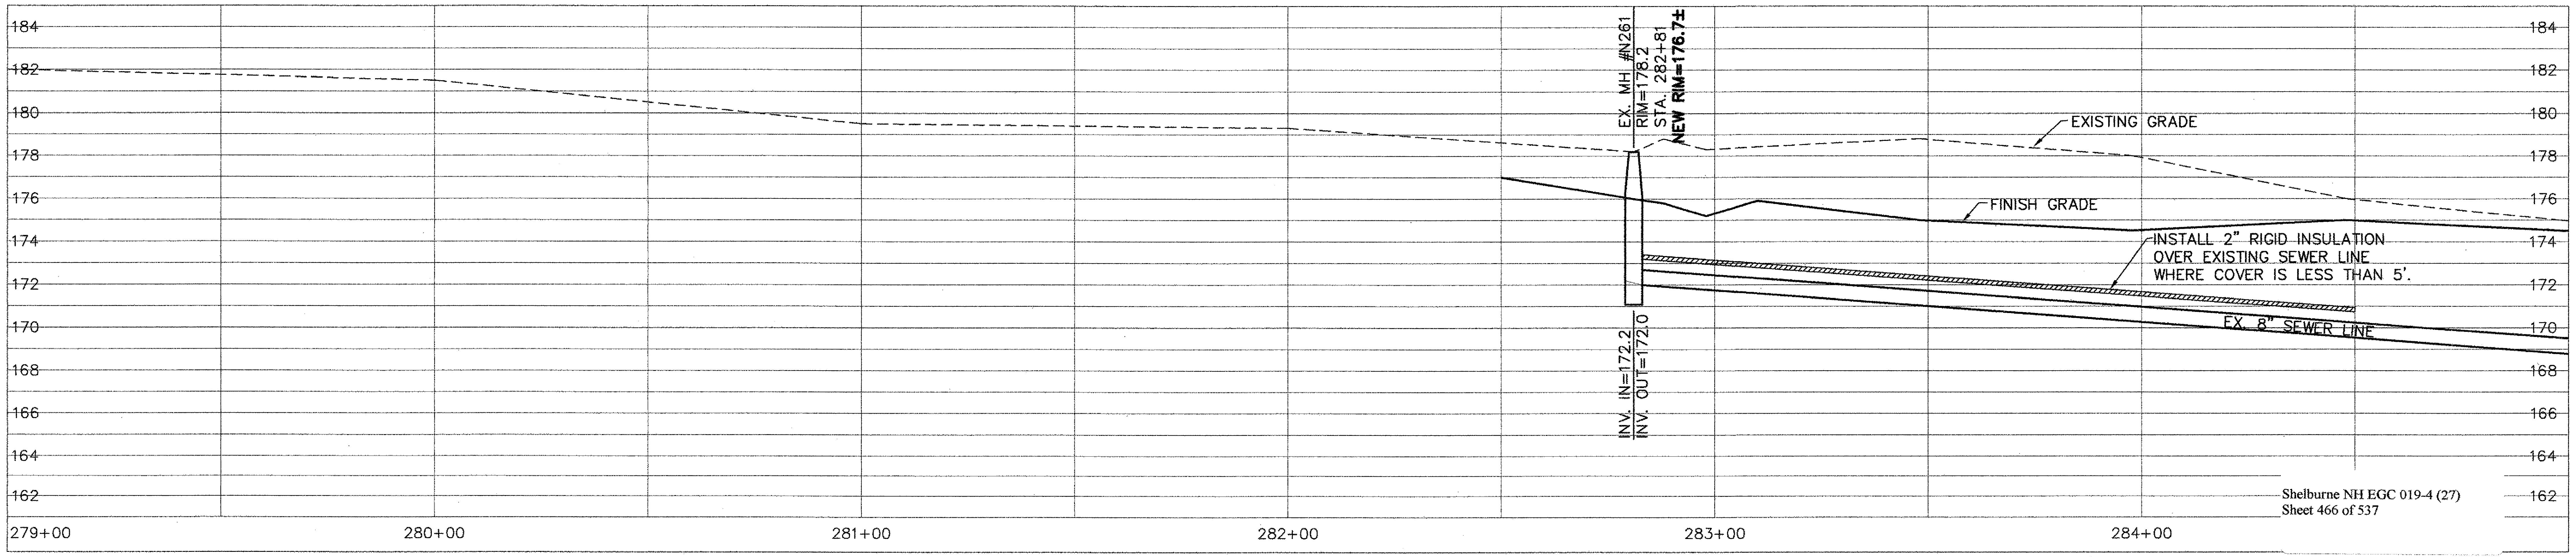STEPHEN A. VOCK
No. 5226

Date	Ch'k'd	Revision
1-5-04	SAV/ACL	REV'D WATER SYSTEM AS PER "AS BUILT" INFORMATION
10-21-03	SAV/ACL	REV'D SEWER & WATER AS PER AOT REVIEW COMMENTS
9-3-03	SAV/ACL	REVISED RIM ELEV. TO ±
7-21-03	SAV/ACL	REVISED

Drawn by	ACL	Date	DEC., 2000
Checked by	SAV	Scale	AS NOTED
Approved by	SAV	Project No.	96111

TOWN OF SHELBURNE
SEWER/WATER RELOCATION (AOT WORK)
PLAN AND PROFILE
STA. 279+00 TO 285+00

SHELBURNE VERMONT

CIVIL ENGINEERING ASSOCIATES, INC.
SHELBURNE, VERMONT

SHEET
C-8

P:\AutoCADD Projects\1996\96111\ROUTE-7-SEWER.dwg, 01/05/2004 11:26:50 AM