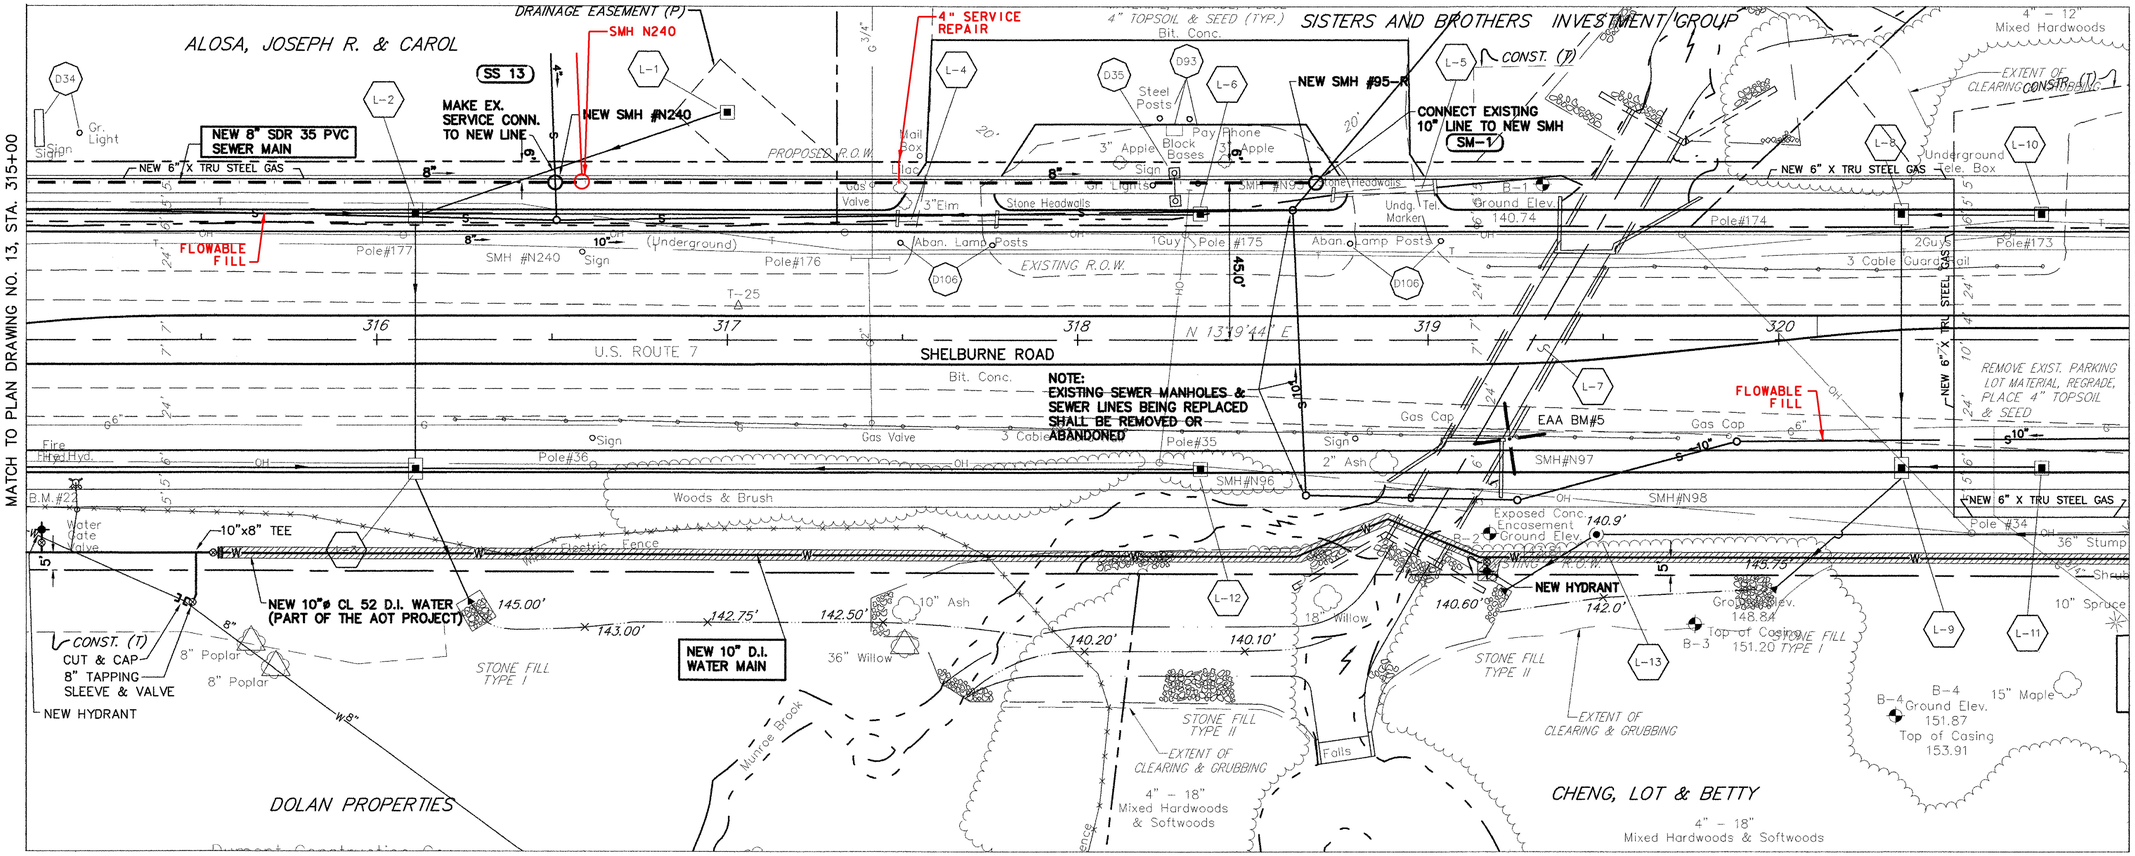

PLAN

1" = 20'

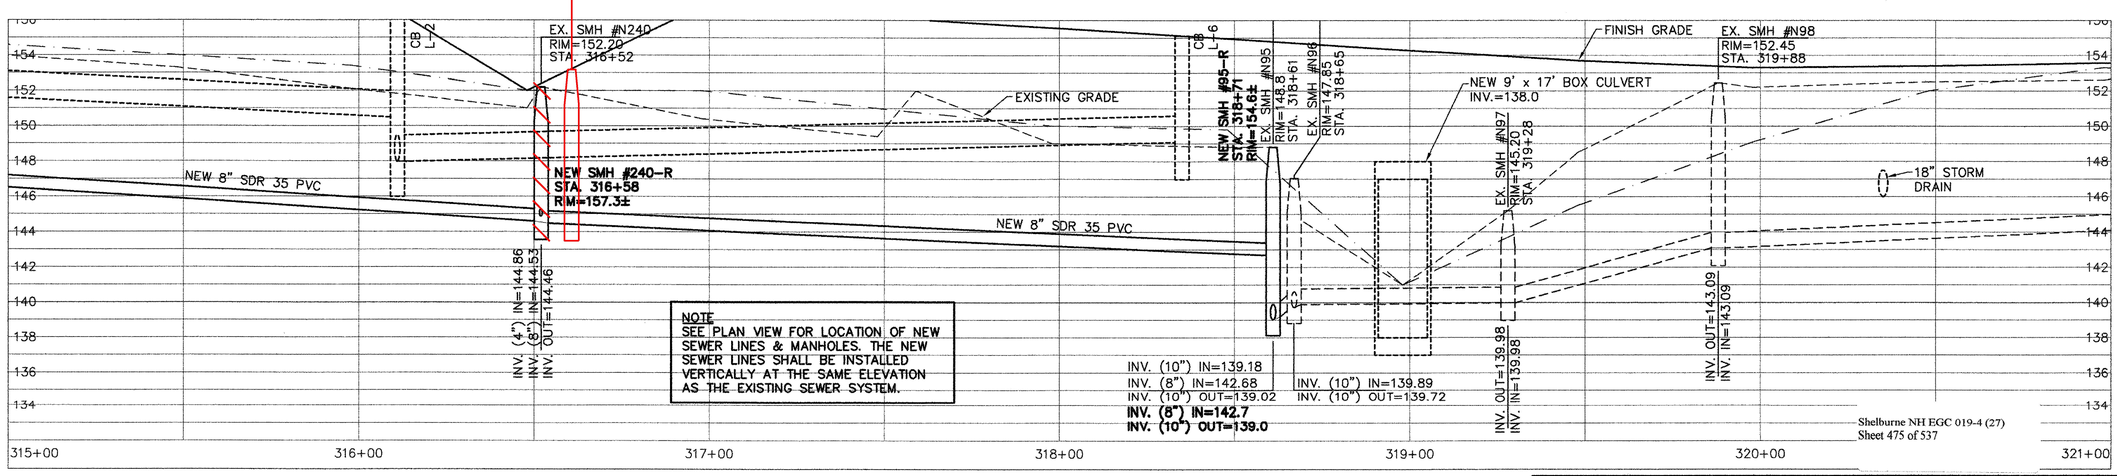

NOTE
SEE PLAN VIEW FOR LOCATION OF NEW SEWER LINES & MANHOLES. THE NEW SEWER LINES SHALL BE INSTALLED VERTICALLY AT THE SAME ELEVATION AS THE EXISTING SEWER SYSTEM.

PROFILE

1" = 4' VERTICAL
1" = 20' HORIZONTAL

RECORD DRAWING REVISIONS

NO	DATE	DESCRIPTION
1.	11/10/09	FIELD MARK UPS ADDED TO THE PLANS

STATE OF VERMONT — JAMES A. VOLKER — No. 5226 — REGISTERED PROFESSIONAL ENGINEER

Date	Ch'k'd	Revision
10-21-03	SAV/ACL	REV'D SEWER & WATER AS PER AOT REVIEW COMMENTS
9-3-03	SAV/ACL	REVISED PER REVIEW COMMENTS
7-21-03	SAV/ACL	REVISED

Drawn by ACL — Date DEC., 2000
Checked by SAV — Scale AS NOTED
Approved by SAV — Project No. 96111

TOWN OF SHELBURNE SEWER/WATER RELOCATION (AOT WORK) PLAN AND PROFILE STA. 315+00 TO 321+00

SHELBURNE VERMONT

CIVIL ENGINEERING ASSOCIATES, INC.
SHELBURNE, VERMONT

SHEET C-14

Shelburne NH EGC 019-4 (27)
Sheet 475 of 537

P:\AutoCADD Projects\1996\96111\ROUTE-7-SEWER.dwg, 01/06/2004 08:34:45 AM