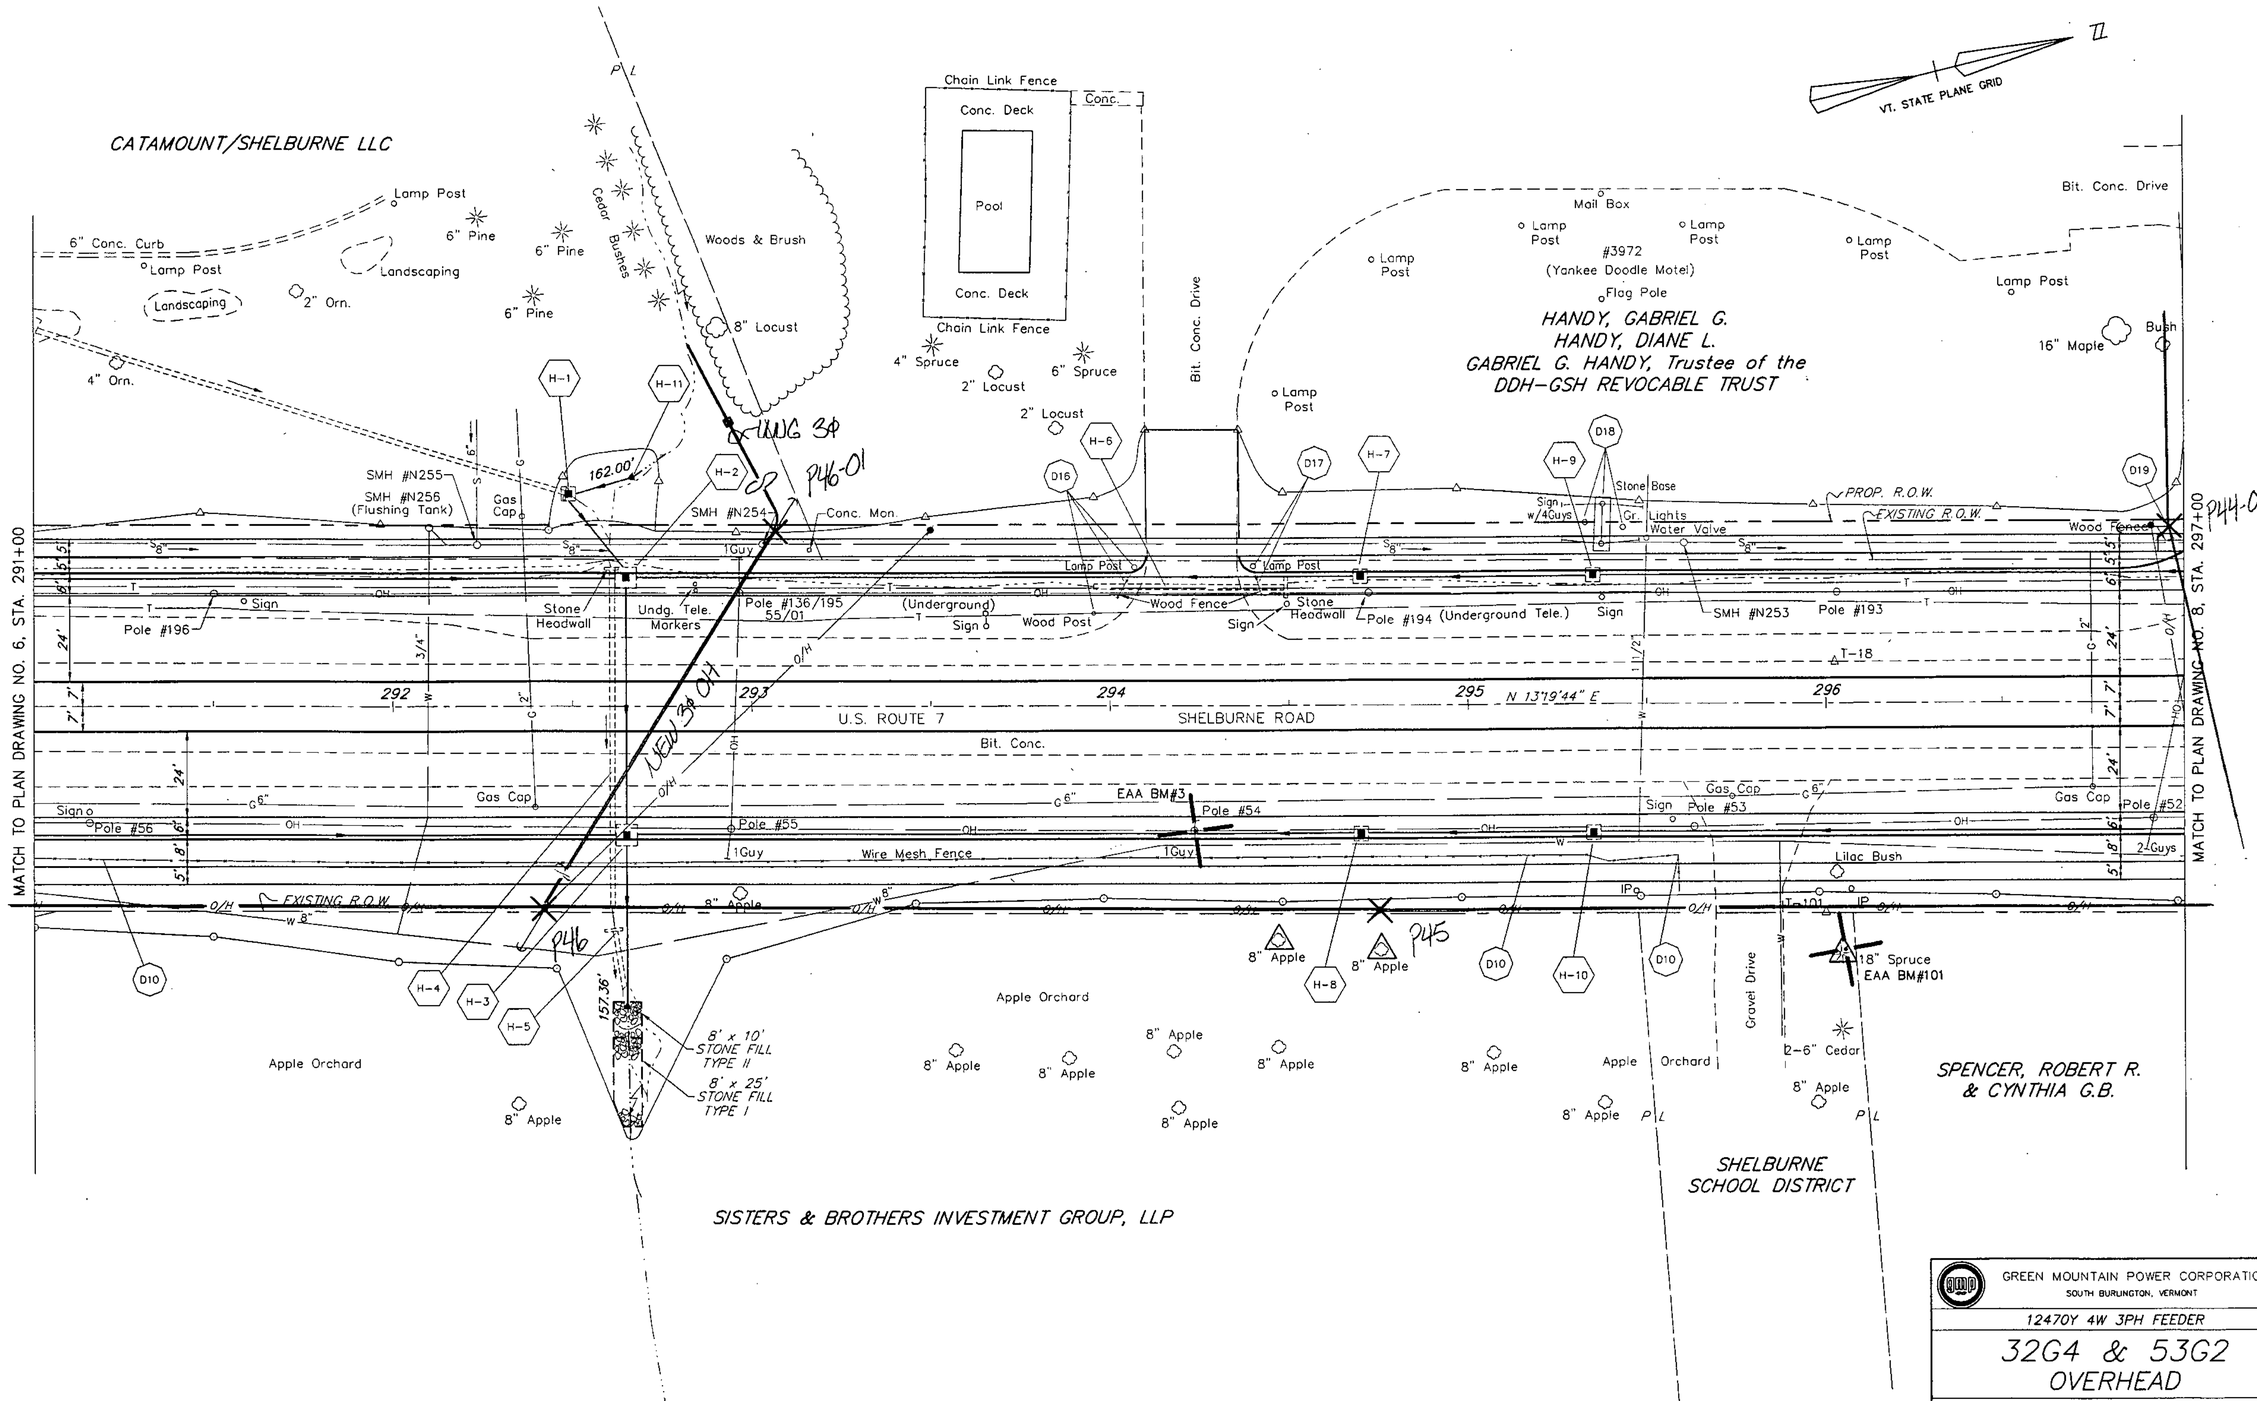

Shelburne NH EGC 019-4 (27)
Sheet 500 of 537

GREEN MOUNTAIN POWER CORPORATION
SOUTH BURLINGTON, VERMONT

12470Y 4W 3PH FEEDER

32G4 & 53G2 OVERHEAD

SHELBURNE ROAD RECONSTRUCTION

DRAWN:	CHECKED:	APPROVED:	SCALE: 1"=20'
DATE:	DRAWING NO. GMP-10_3_07		SHEET: 6