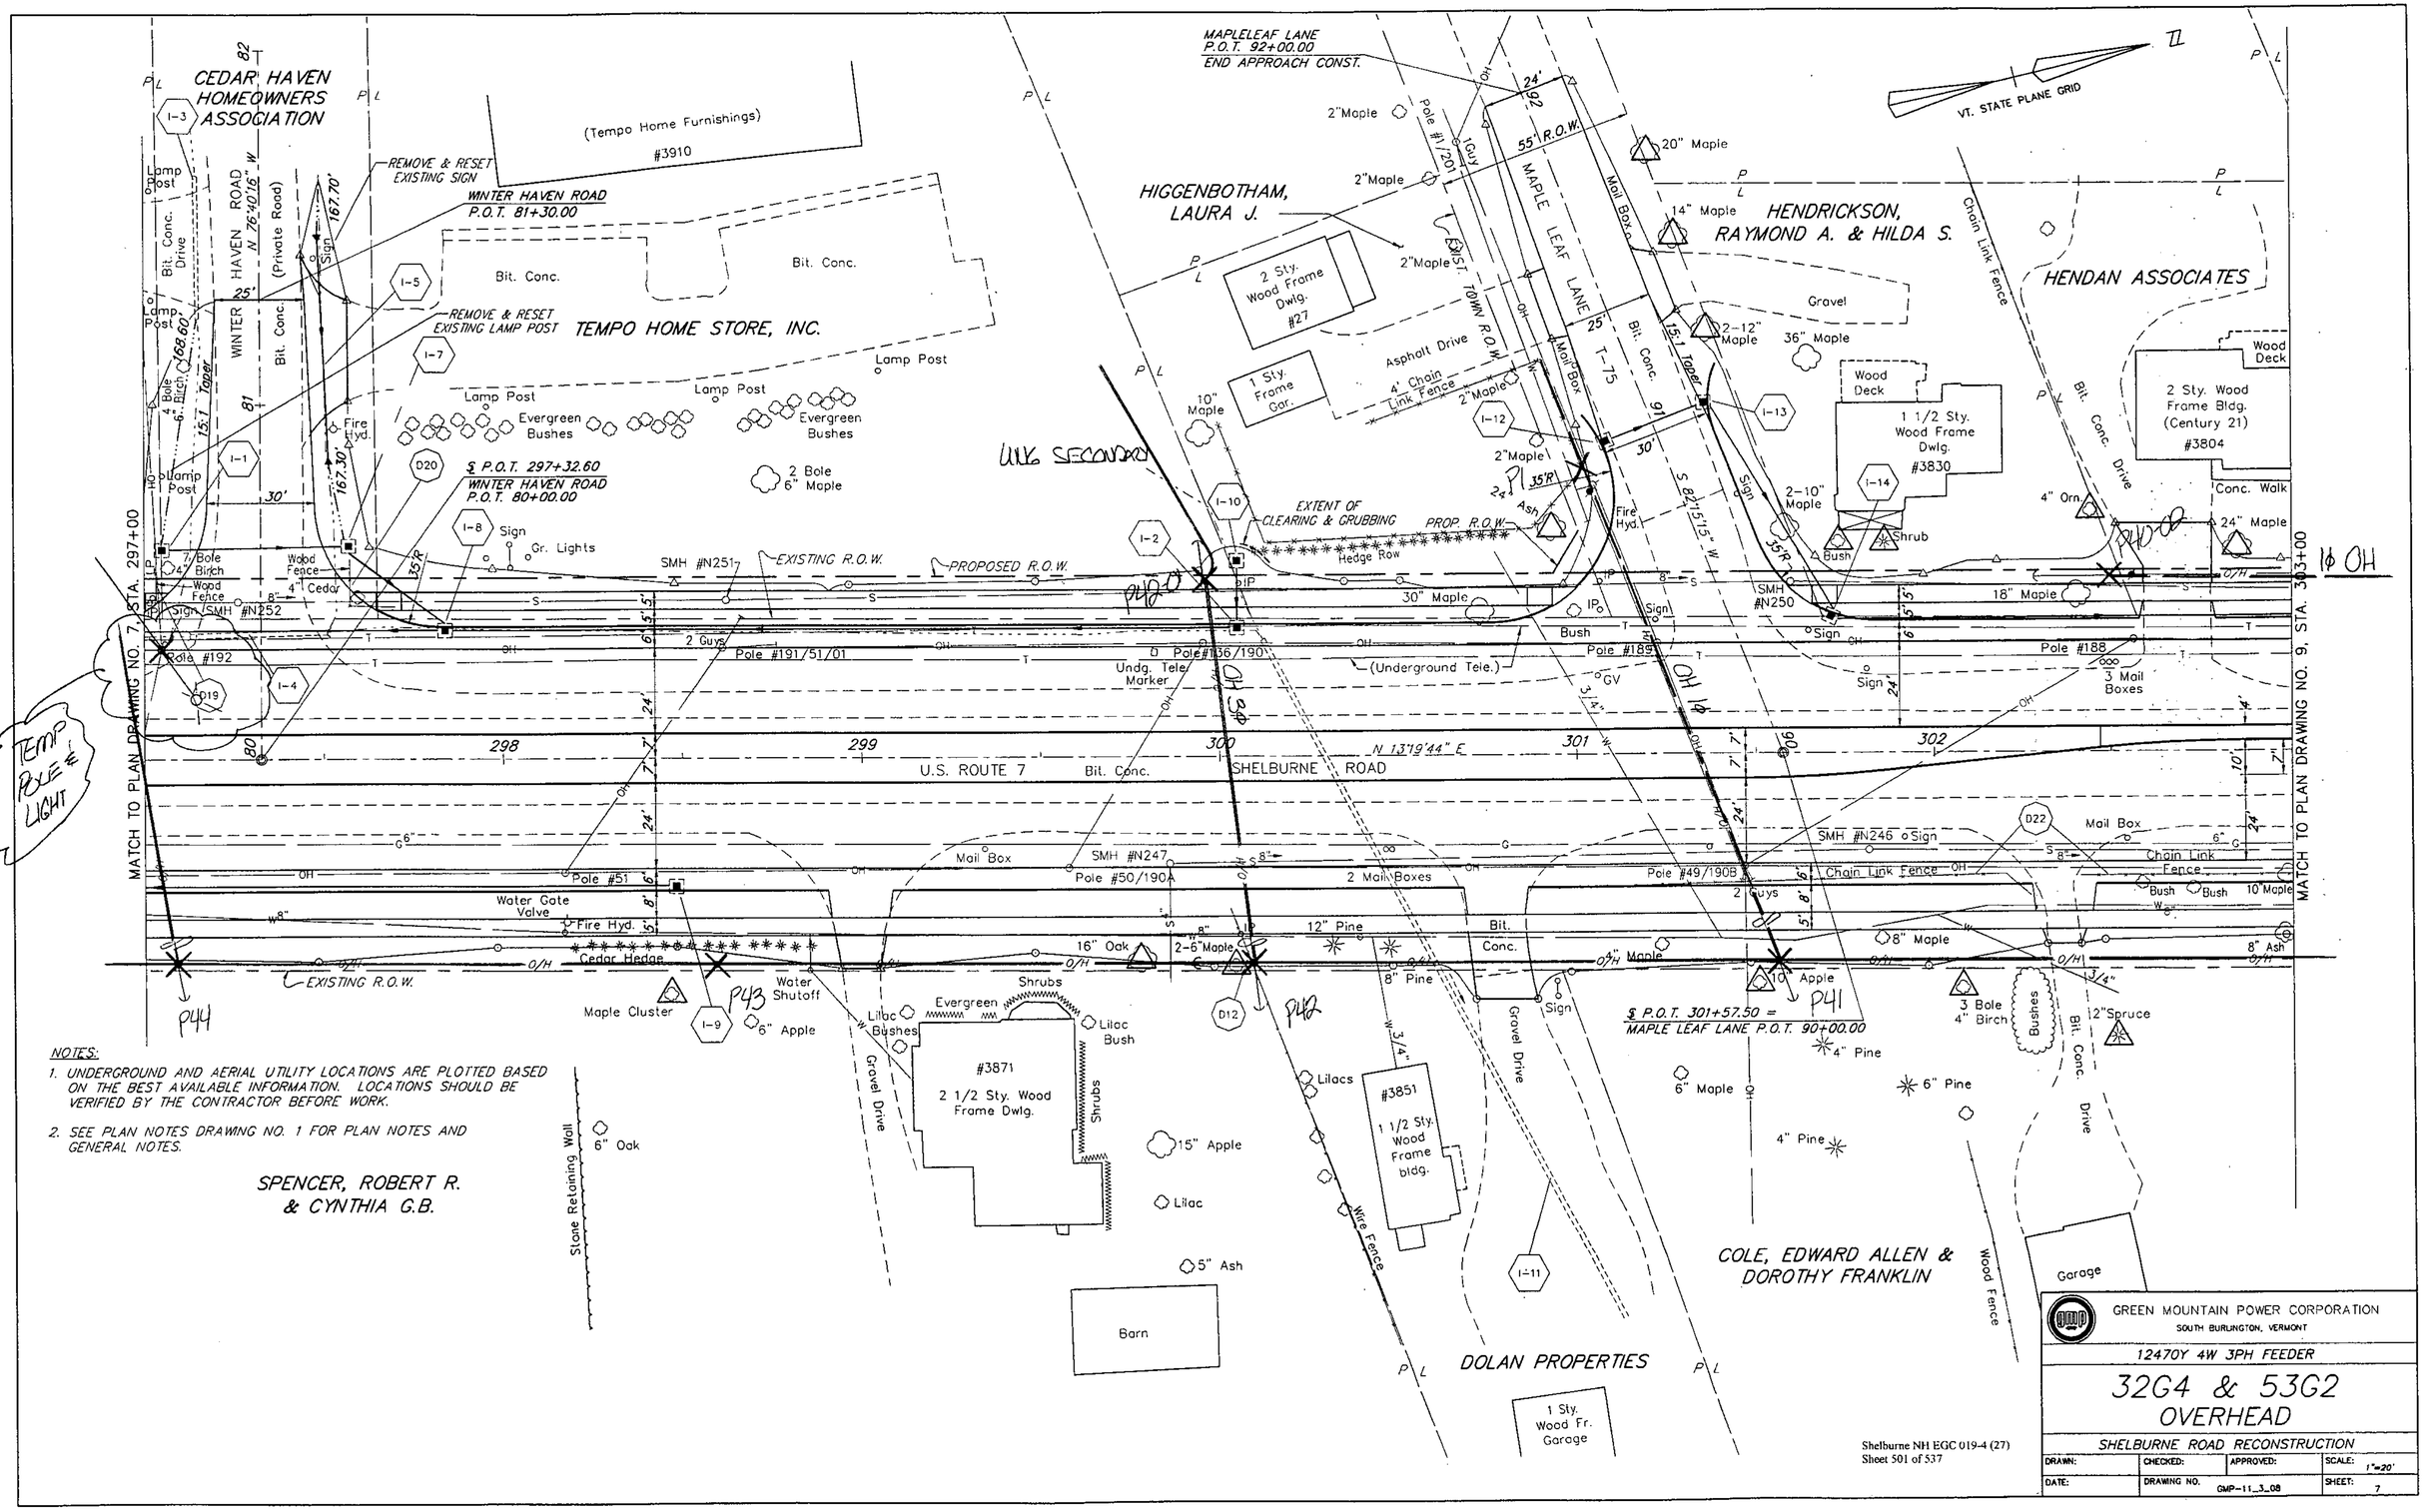

NOTES:

1. UNDERGROUND AND AERIAL UTILITY LOCATIONS ARE PLOTTED BASED ON THE BEST AVAILABLE INFORMATION. LOCATIONS SHOULD BE VERIFIED BY THE CONTRACTOR BEFORE WORK.
2. SEE PLAN NOTES DRAWING NO. 1 FOR PLAN NOTES AND GENERAL NOTES.

GREEN MOUNTAIN POWER CORPORATION
SOUTH BURLINGTON, VERMONT

12470Y 4W 3PH FEEDER

32G4 & 53G2
OVERHEAD

SHELBURNE ROAD RECONSTRUCTION

DRAWN:	CHECKED:	APPROVED:	SCALE: 1"=20'
DATE:	DRAWING NO. GMP-11_3_08		SHEET: 7

Shelburne NH EGC 019-4 (27)
Sheet 501 of 537