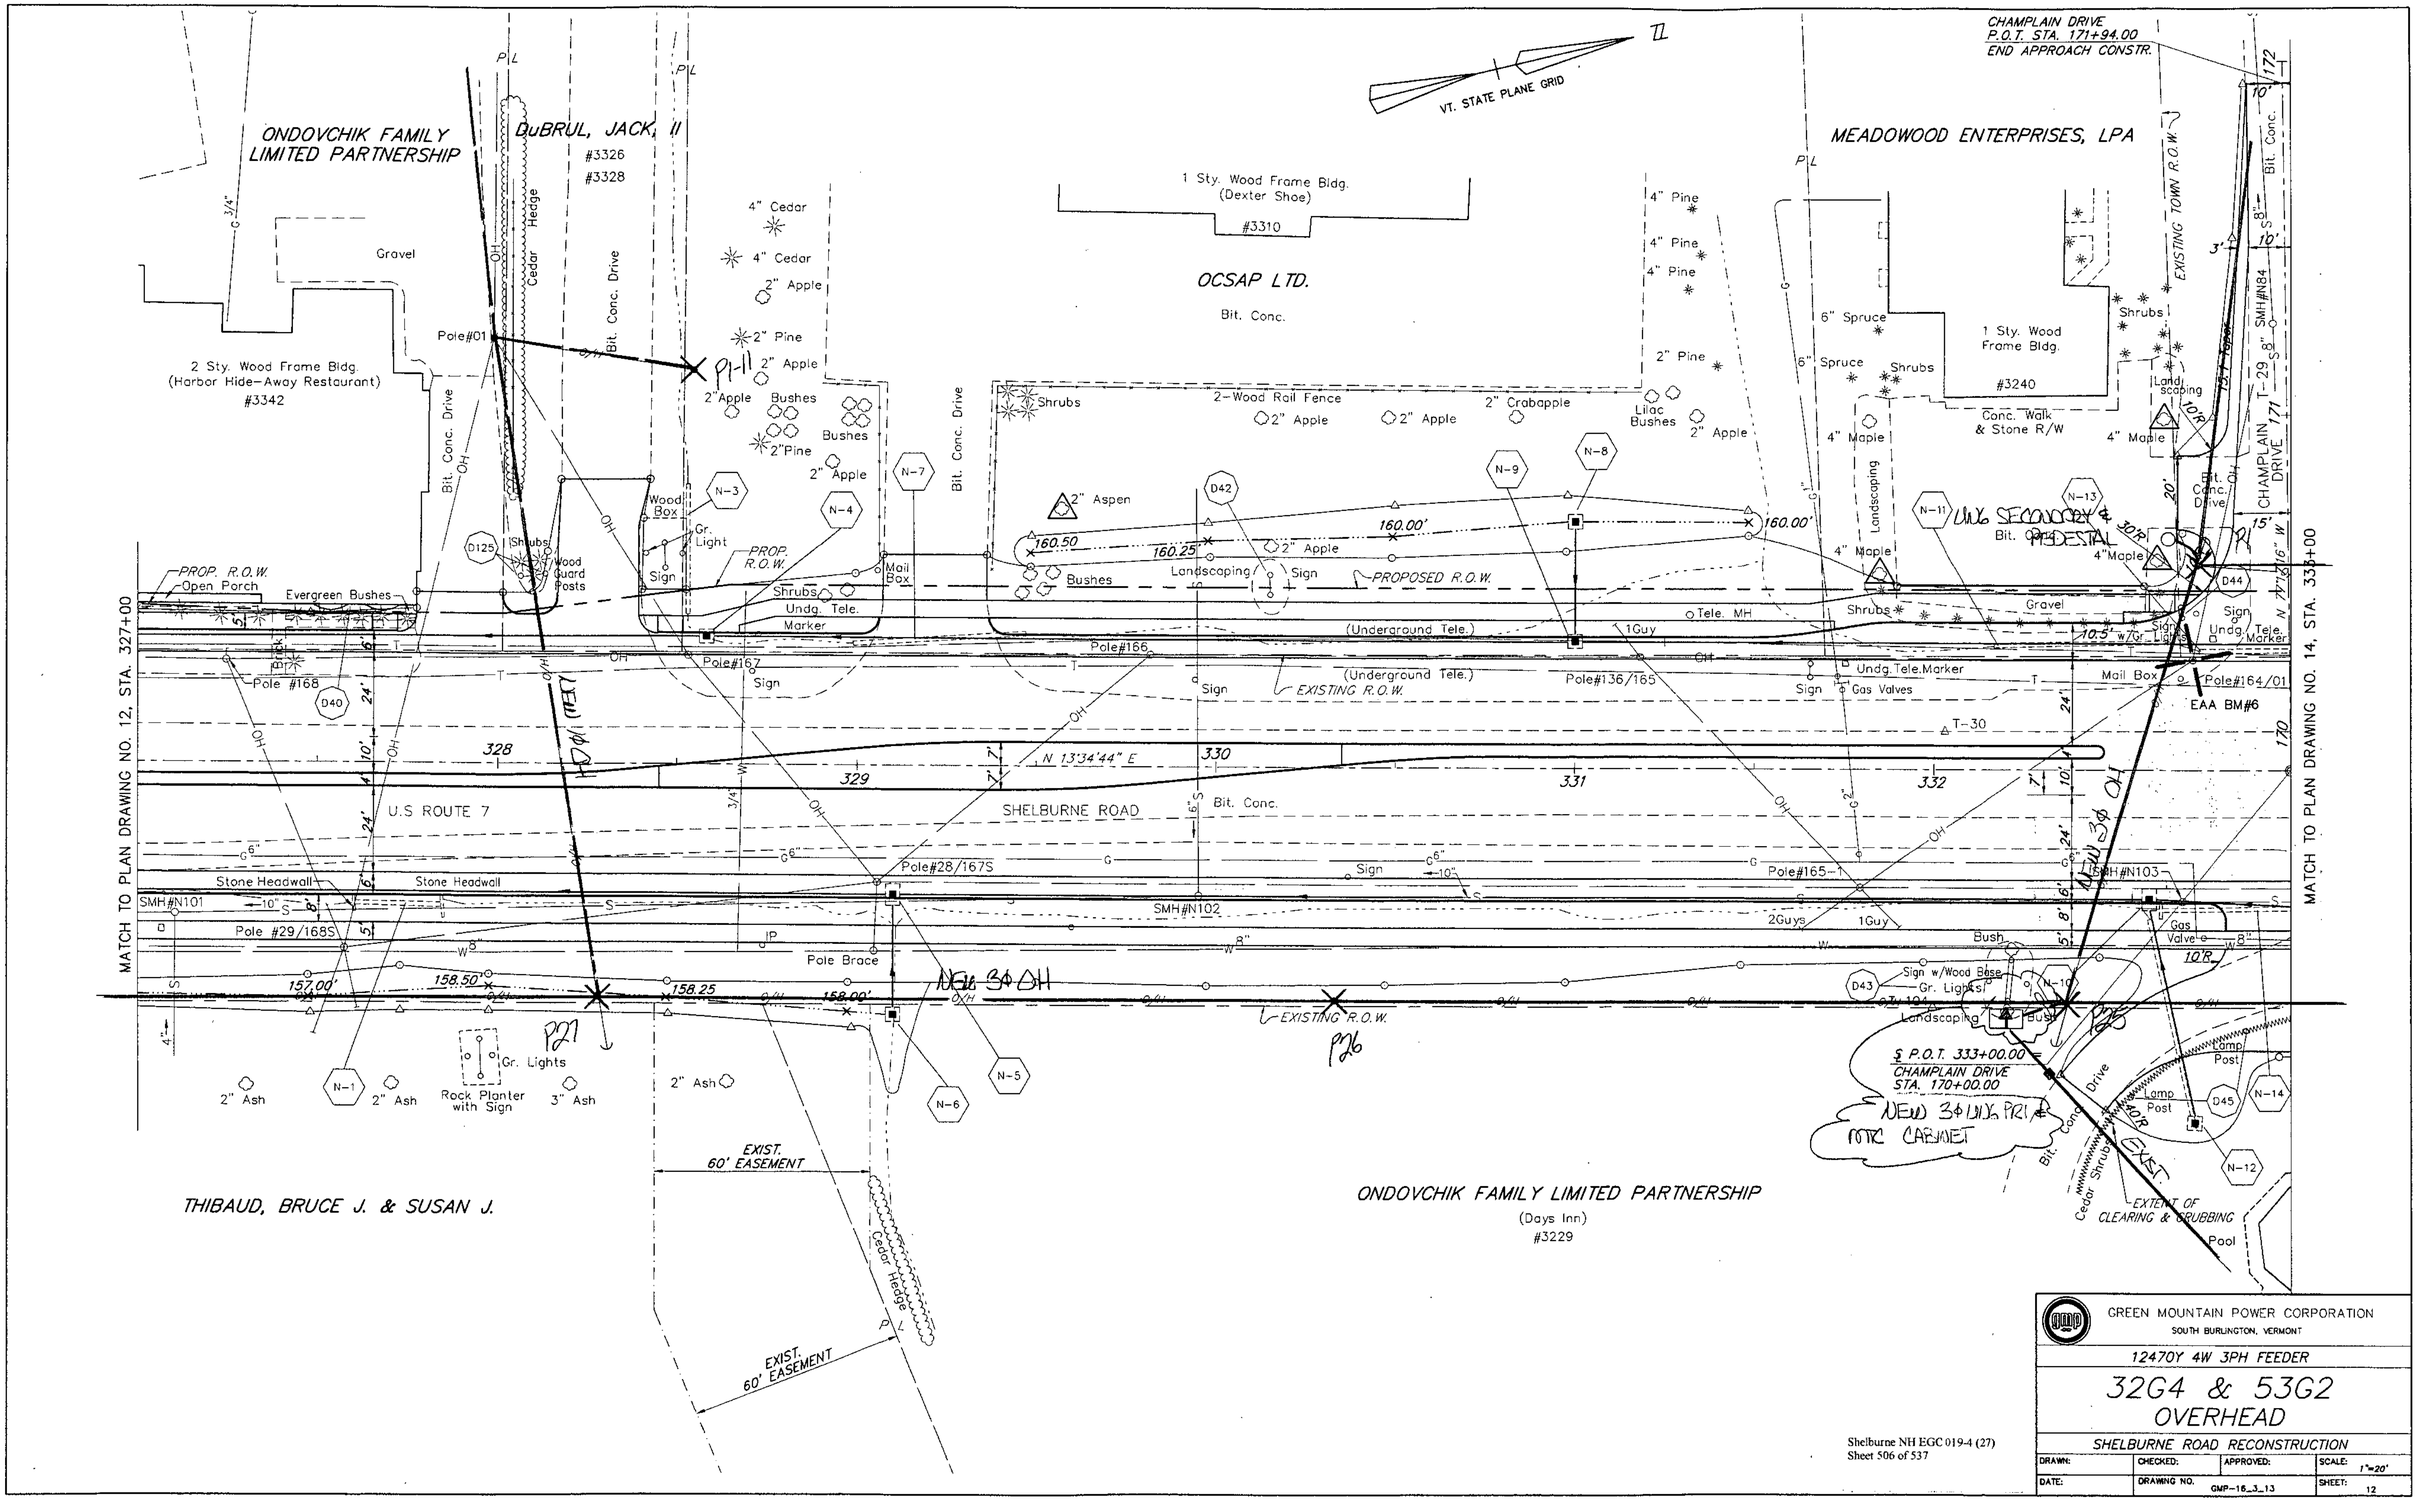

GREEN MOUNTAIN POWER CORPORATION
SOUTH BURLINGTON, VERMONT

12470Y 4W 3PH FEEDER

32G4 & 53G2
OVERHEAD

SHELBURNE ROAD RECONSTRUCTION

DRAWN:	CHECKED:	APPROVED:	SCALE: 1"=20'
DATE:	DRAWING NO. GMP-16_3_13		SHEET: 12

Shelburne NH EGC 019-4 (27)
Sheet 506 of 537