STATE OF VERMONT
AGENCY OF TRANSPORTATION

TRAFFIC SIGN SUMMARY SHEET

VAOT Metric

KILOMETER MARKER, STATION, OR SIGN NUMBER	SIGN LEGEND	SIGN DIMENSIONS EA	WIDTH (mm)	HEIGHT (mm)	NEW & SALVAGED SIGNS "A"	"B"	SALV SIGN	SALV TIS	EXIST POST RETAIN	EXIST POST SALVAGE	NEW SIGN POSTS NO. OF POSTS	FLANGED CHANNEL kg/m 1.7	3.0	4.5	SQUARE STEEL (mm) kg/m 44 3.4	50 3.9	63 5.0	ANCHOR	SLEEVE	TUBULAR ALUMINUM Ø (mm) kg/m 75 1.9	100 2.5	100 MOD 2.5	TUBULAR STEEL Ø (mm) FOUND-ATION	kg/m 75 11.3	89 13.4	100 16.1	125 21.7	W-SHAPE STEEL FTG. SIZE 600 mm	750 mm	WEIGHT	POST SIZE	SIGN FRAME REQUIRED	REMARKS	SIGN DETAIL DETAIL ON SHEET NUMBER	STD. SHEET NUMBER
											OPTION ITEMS																									
INTERCHANGE 4 SIDE LINE 400+614.0, ℄		1	600	750	0.45						1			X		X																			E-144M
		1	450	450	0.20																														E-150M
400+~~635.~~ 586.0, LT		1 1 1	600 600 600	300 300 300	0.18 0.18 0.18						2												2	X							X			E-136AM E-136BM E-136AM
		1 1 1	600 600 600	600 600 600	0.36 0.36 0.36																													E-136AM E-136BM E-136AM
		1 1 1	525 525 525	375 375 375	0.20 0.20 0.20																													E-136AM E-136BM E-136AM
400+640.0, RT		1	600	300	0.18						1			X			X																		E-136BM
		1	600	600	0.36																														E-136BM
400+690.0, LT	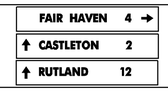	1 1 1	1800 1800 1800	250 250 250	0.45 0.45 0.45						2			X			X																		62 62 62	
400+700.0, RT	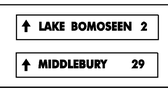	1 1	1800 1800	250 250	0.45 0.45						2			X		X																			62 62	
400+750.0, LT		1	525	375	0.20						1			X			X																			E-136AM
		1	600	600	0.36																														E-136AM
FINAL POST LENGTHS ARE TO BE DETERMINED IN THE FIELD. POST SIZES ARE COMPUTED BASED ON INFORMATION FURNISHED ON THE STANDARD SHEETS AND THE TRAFFIC & SAFETY DIVISION'S "SIGN POST DESIGN GUIDELINE."												m	m	m 32.2	m	m 13.8	m 18.4		EA	kg	kg	kg		kg 39.2	kg	kg	kg							
	TOTALS		m^2 6.22	m^2	EA	m^2						m 32.2			m 32.2					kg			EA 2	kg 39.2				EA	EA	kg				

PROJECT: FAIR HAVEN - RUTLAND	PROJECT NO.: NH 9727(I)S
DESIGN FILE NAME: /pave/96bl54/pbl54.dgn	
IPARM FILE NAME: pbl54t33.1	PLOT DATE: 8/98
SURVEYED BY: N/A	SURVEY DATE: N/A
SQUAD LEADER: T.P.K.	DRAWN BY: C.A.K.
	SHEET: 108 OF 119