PLATE 3-LOOP CROSS SECTION-LOOP LINE
HIGHWAY LEGEND NO SHEET
MINIMUM REQUIRED
PRINTED IN U.S.A.

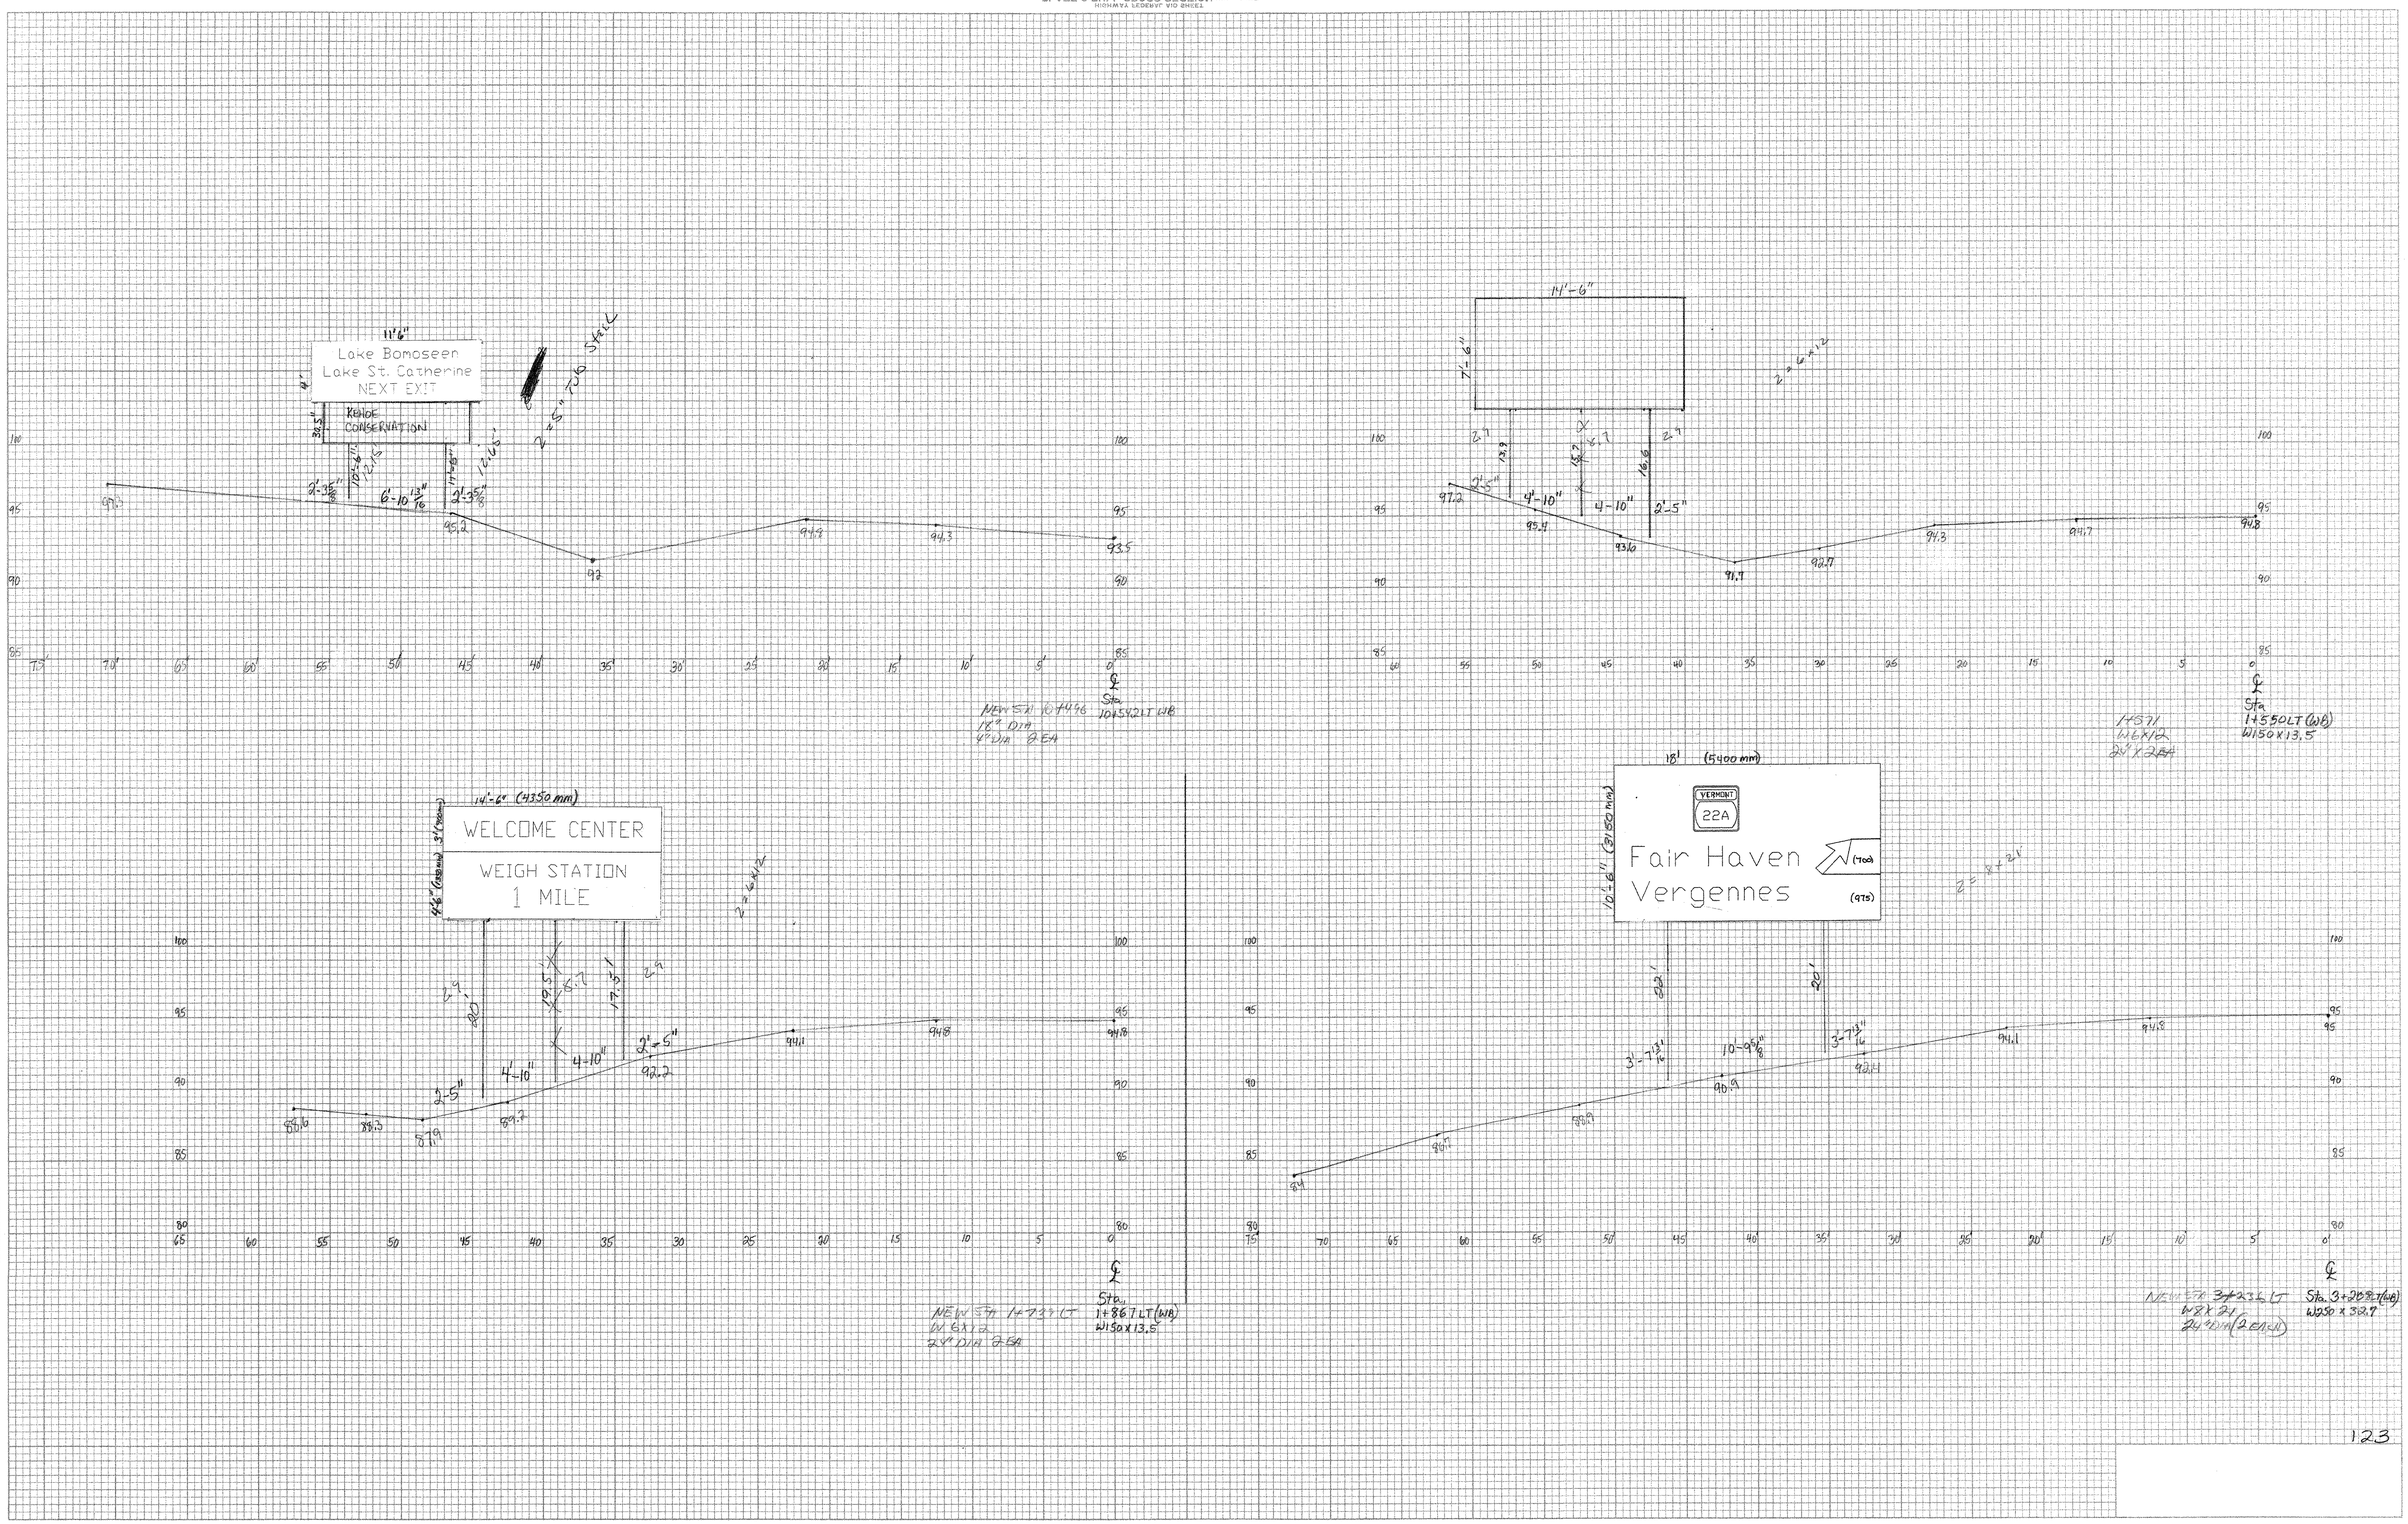

NO.	REVISIONS	BY	DATE

VALUE CHECKED
VALUE BOOK
INSTALLED
STRAIGHTED
ORIGINAL
1994/5
VERMONT
STATE

123