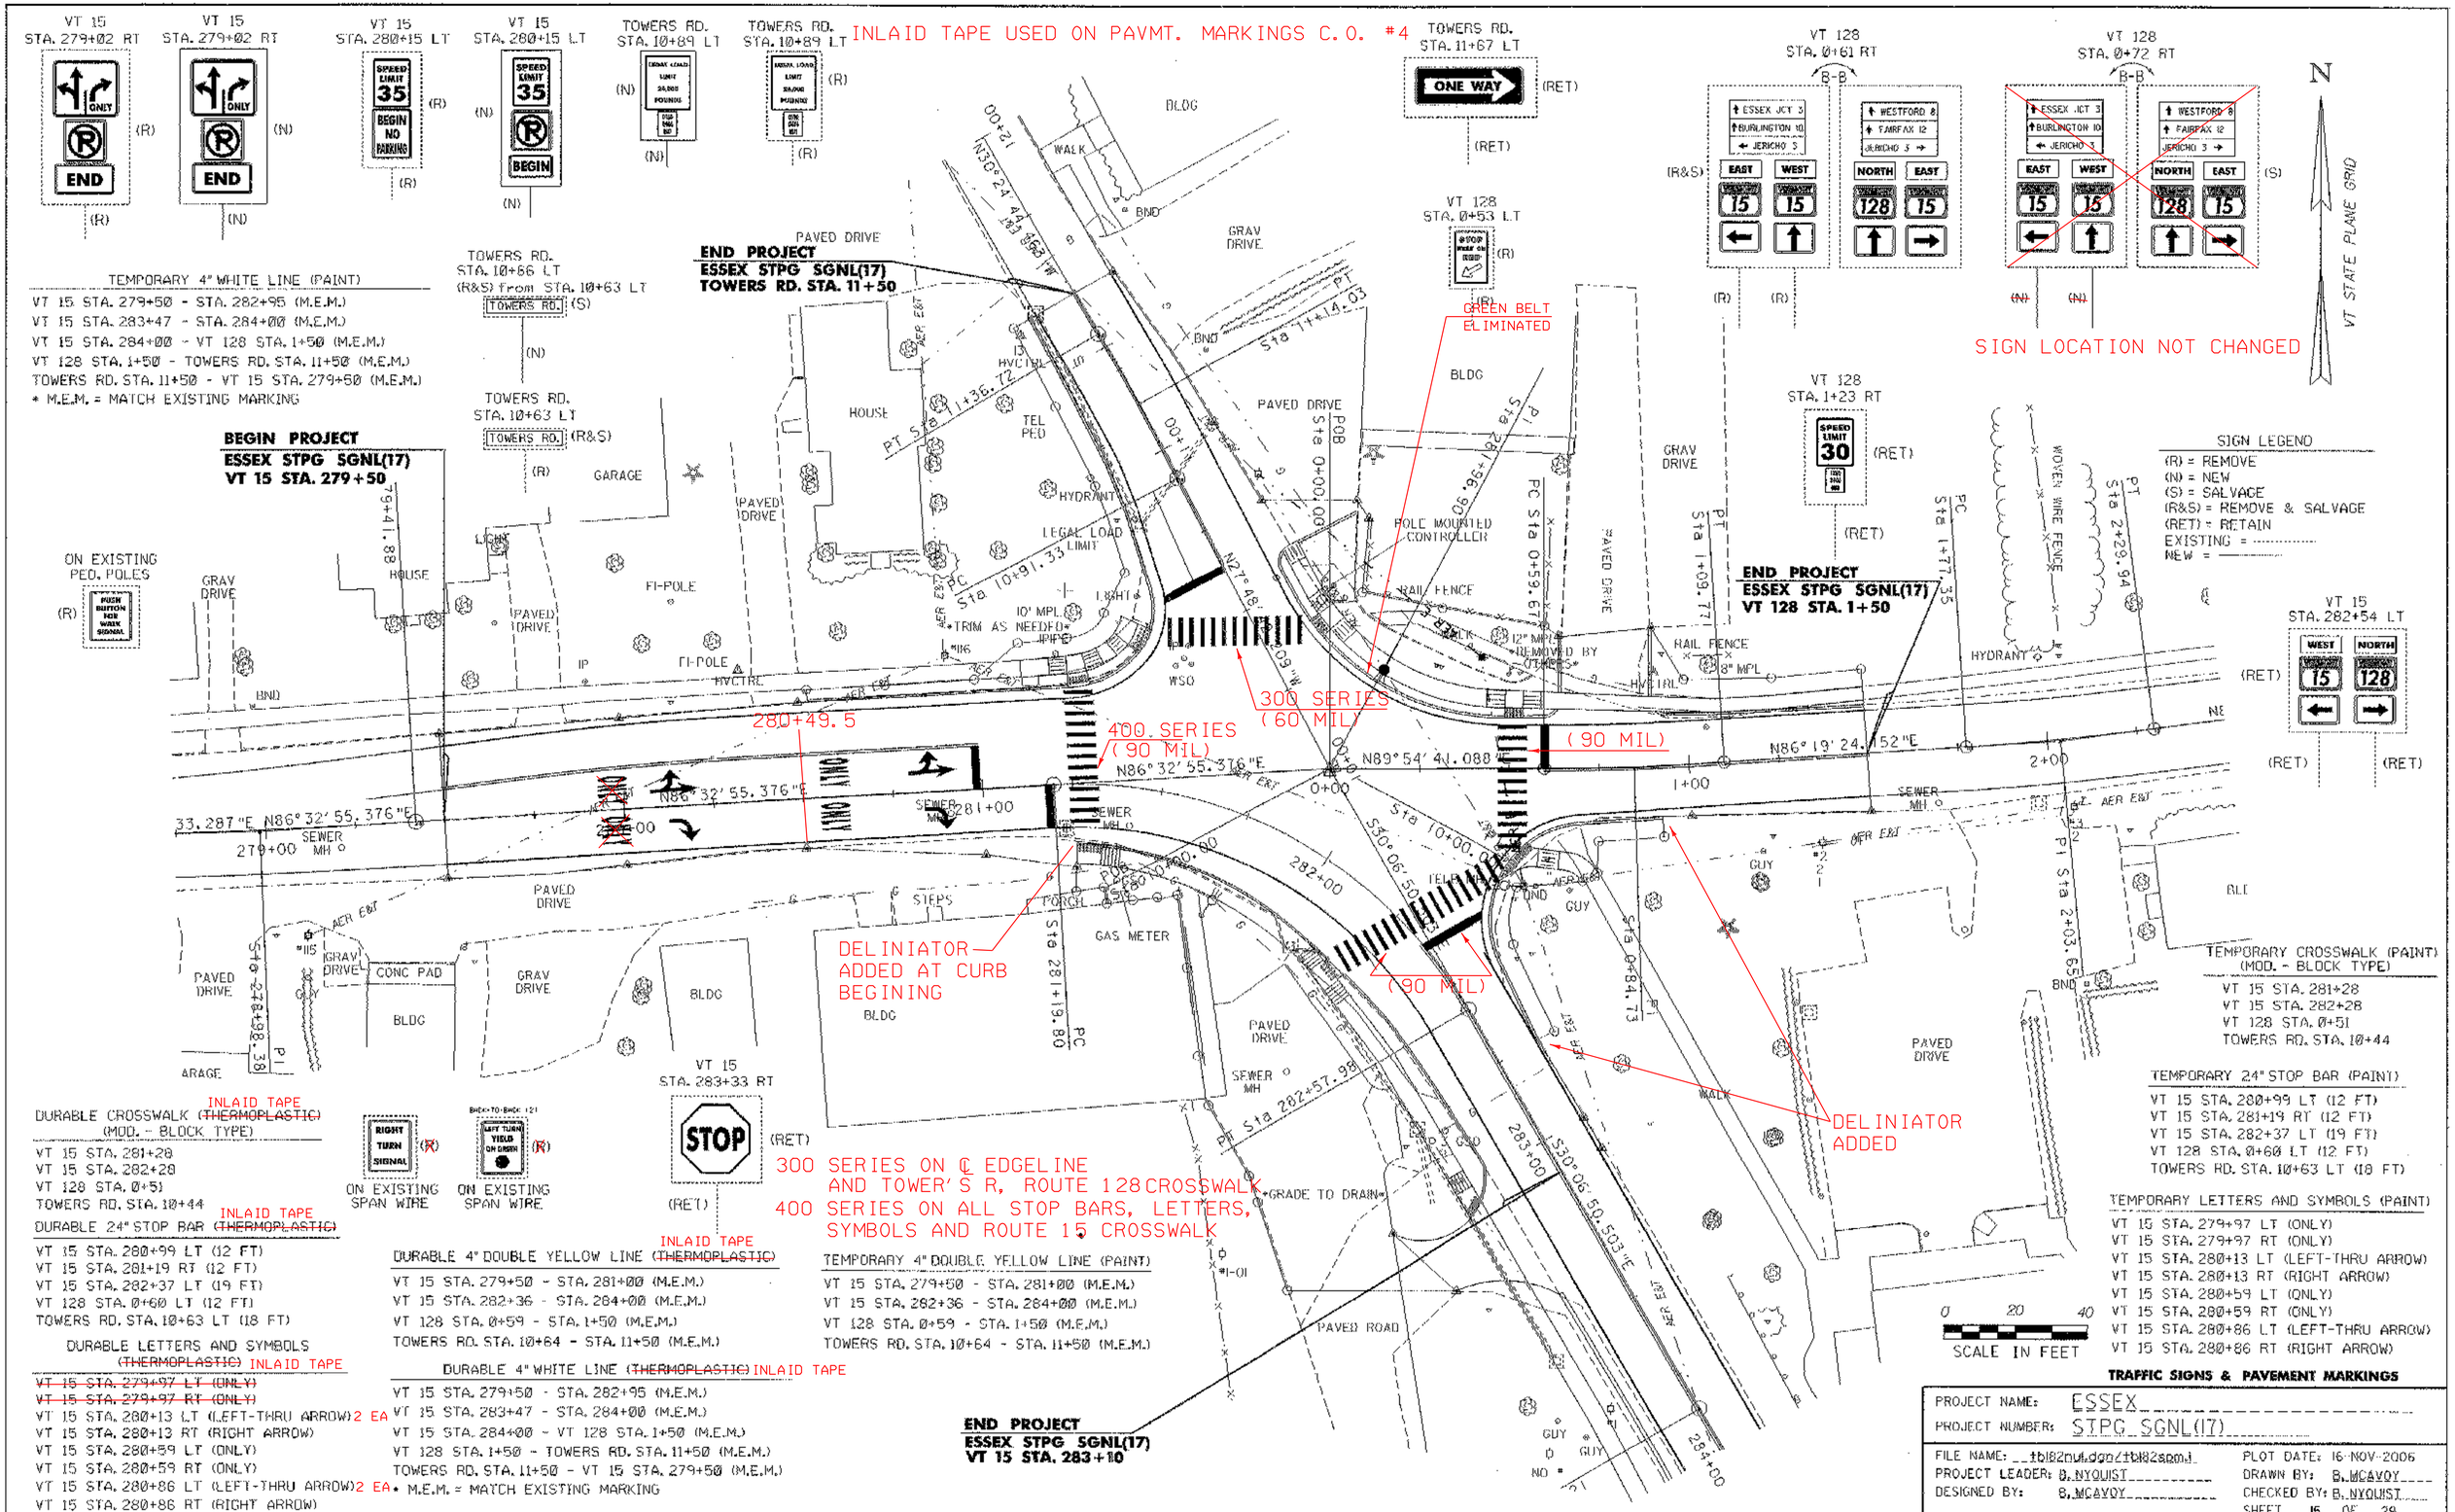
VT 15 STA. 279+02 RT
VT 15 STA. 279+02 RT
VT 15 STA. 280+15 LT
VT 15 STA. 280+15 LT
TOWERS RD. STA. 10+89 LT
TOWERS RD. STA. 10+89 LT
INLAID TAPE USED ON PAVMT. MARKINGS C.O. #4
TOWERS RD. STA. 11+67 LT
ONE WAY
VT 128 STA. 0+61 RT
VT 128 STA. 0+72 RT
SIGN LOCATION NOT CHANGED
VT STATE PLANE GRID
TEMPORARY 4" WHITE LINE (PAINT)
VT 15 STA. 279+50 - STA. 282+95 (M.E.M.)
VT 15 STA. 283+47 - STA. 284+00 (M.E.M.)
VT 15 STA. 284+00 - VT 128 STA. 1+50 (M.E.M.)
VT 128 STA. 1+50 - TOWERS RD. STA. 11+50 (M.E.M.)
TOWERS RD. STA. 11+50 - VT 15 STA. 279+50 (M.E.M.)
* M.E.M. = MATCH EXISTING MARKING
TOWERS RD. STA. 10+66 LT (R&S) from STA. 10+63 LT
TOWERS RD. STA. 10+63 LT
END PROJECT
ESSEX STPG SGNL(17)
TOWERS RD. STA. 11+50
BEGIN PROJECT
ESSEX STPG SGNL(17)
VT 15 STA. 279+50
VT 128 STA. 0+53 LT
GREEN BELT ELIMINATED
VT 128 STA. 1+23 RT
SPEED LIMIT 30
END PROJECT
ESSEX STPG SGNL(17)
VT 128 STA. 1+50
SIGN LEGEND
(R) = REMOVE
(N) = NEW
(S) = SALVAGE
(R&S) = REMOVE & SALVAGE
(RET) = RETAIN
EXISTING = ----------
NEW = ————
VT 15 STA. 282+54 LT
ON EXISTING PED. POLES
PUSH BUTTON FOR WALK SIGNAL
300 SERIES (60 MIL)
400 SERIES (90 MIL)
(90 MIL)
280+49.5
DELINIATOR ADDED AT CURB BEGINING
DELINIATOR ADDED
TEMPORARY CROSSWALK (PAINT) (MOD. - BLOCK TYPE)
VT 15 STA. 281+28
VT 15 STA. 282+28
VT 128 STA. 0+51
TOWERS RD. STA. 10+44
TEMPORARY 24" STOP BAR (PAINT)
VT 15 STA. 280+99 LT (12 FT)
VT 15 STA. 281+19 RT (12 FT)
VT 15 STA. 282+37 LT (19 FT)
VT 128 STA. 0+60 LT (12 FT)
TOWERS RD. STA. 10+63 LT (18 FT)
TEMPORARY LETTERS AND SYMBOLS (PAINT)
VT 15 STA. 279+97 LT (ONLY)
VT 15 STA. 279+97 RT (ONLY)
VT 15 STA. 280+13 LT (LEFT-THRU ARROW)
VT 15 STA. 280+13 RT (RIGHT ARROW)
VT 15 STA. 280+59 LT (ONLY)
VT 15 STA. 280+59 RT (ONLY)
VT 15 STA. 280+86 LT (LEFT-THRU ARROW)
VT 15 STA. 280+86 RT (RIGHT ARROW)
0 20 40
SCALE IN FEET
DURABLE CROSSWALK (~~THERMOPLASTIC~~) INLAID TAPE
(MOD. - BLOCK TYPE)
VT 15 STA. 281+28
VT 15 STA. 282+28
VT 128 STA. 0+51
TOWERS RD. STA. 10+44
DURABLE 24" STOP BAR (~~THERMOPLASTIC~~) INLAID TAPE
VT 15 STA. 280+99 LT (12 FT)
VT 15 STA. 281+19 RT (12 FT)
VT 15 STA. 282+37 LT (19 FT)
VT 128 STA. 0+60 LT (12 FT)
TOWERS RD. STA. 10+63 LT (18 FT)
DURABLE LETTERS AND SYMBOLS
(~~THERMOPLASTIC~~) INLAID TAPE
~~VT 15 STA. 279+97 LT (ONLY)~~
~~VT 15 STA. 279+97 RT (ONLY)~~
VT 15 STA. 280+13 LT (LEFT-THRU ARROW) 2 EA
VT 15 STA. 280+13 RT (RIGHT ARROW)
VT 15 STA. 280+59 LT (ONLY)
VT 15 STA. 280+59 RT (ONLY)
VT 15 STA. 280+86 LT (LEFT-THRU ARROW) 2 EA
VT 15 STA. 280+86 RT (RIGHT ARROW)
ON EXISTING SPAN WIRE
ON EXISTING SPAN WIRE
VT 15 STA. 283+33 RT
STOP
300 SERIES ON ℄ EDGELINE AND TOWER'S R, ROUTE 128 CROSSWALK
400 SERIES ON ALL STOP BARS, LETTERS, SYMBOLS AND ROUTE 15 CROSSWALK
DURABLE 4" DOUBLE YELLOW LINE (~~THERMOPLASTIC~~) INLAID TAPE
VT 15 STA. 279+50 - STA. 281+00 (M.E.M.)
VT 15 STA. 282+36 - STA. 284+00 (M.E.M.)
VT 128 STA. 0+59 - STA. 1+50 (M.E.M.)
TOWERS RD. STA. 10+64 - STA. 11+50 (M.E.M.)
TEMPORARY 4" DOUBLE YELLOW LINE (PAINT)
VT 15 STA. 279+50 - STA. 281+00 (M.E.M.)
VT 15 STA. 282+36 - STA. 284+00 (M.E.M.)
VT 128 STA. 0+59 - STA. 1+50 (M.E.M.)
TOWERS RD. STA. 10+64 - STA. 11+50 (M.E.M.)
DURABLE 4" WHITE LINE (~~THERMOPLASTIC~~) INLAID TAPE
VT 15 STA. 279+50 - STA. 282+95 (M.E.M.)
VT 15 STA. 283+47 - STA. 284+00 (M.E.M.)
VT 15 STA. 284+00 - VT 128 STA. 1+50 (M.E.M.)
VT 128 STA. 1+50 - TOWERS RD. STA. 11+50 (M.E.M.)
TOWERS RD. STA. 11+50 - VT 15 STA. 279+50 (M.E.M.)
* M.E.M. = MATCH EXISTING MARKING
END PROJECT
ESSEX STPG SGNL(17)
VT 15 STA. 283+10
TRAFFIC SIGNS & PAVEMENT MARKINGS
PROJECT NAME: ESSEX
PROJECT NUMBER: STPG SGNL(17)
FILE NAME: tb182nu4.dgn/tb182sgm.i
PROJECT LEADER: B. NYQUIST
DESIGNED BY: B. MCAVOY
PLOT DATE: 16-NOV-2006
DRAWN BY: B. MCAVOY
CHECKED BY: B. NYQUIST
SHEET 15 OF 29