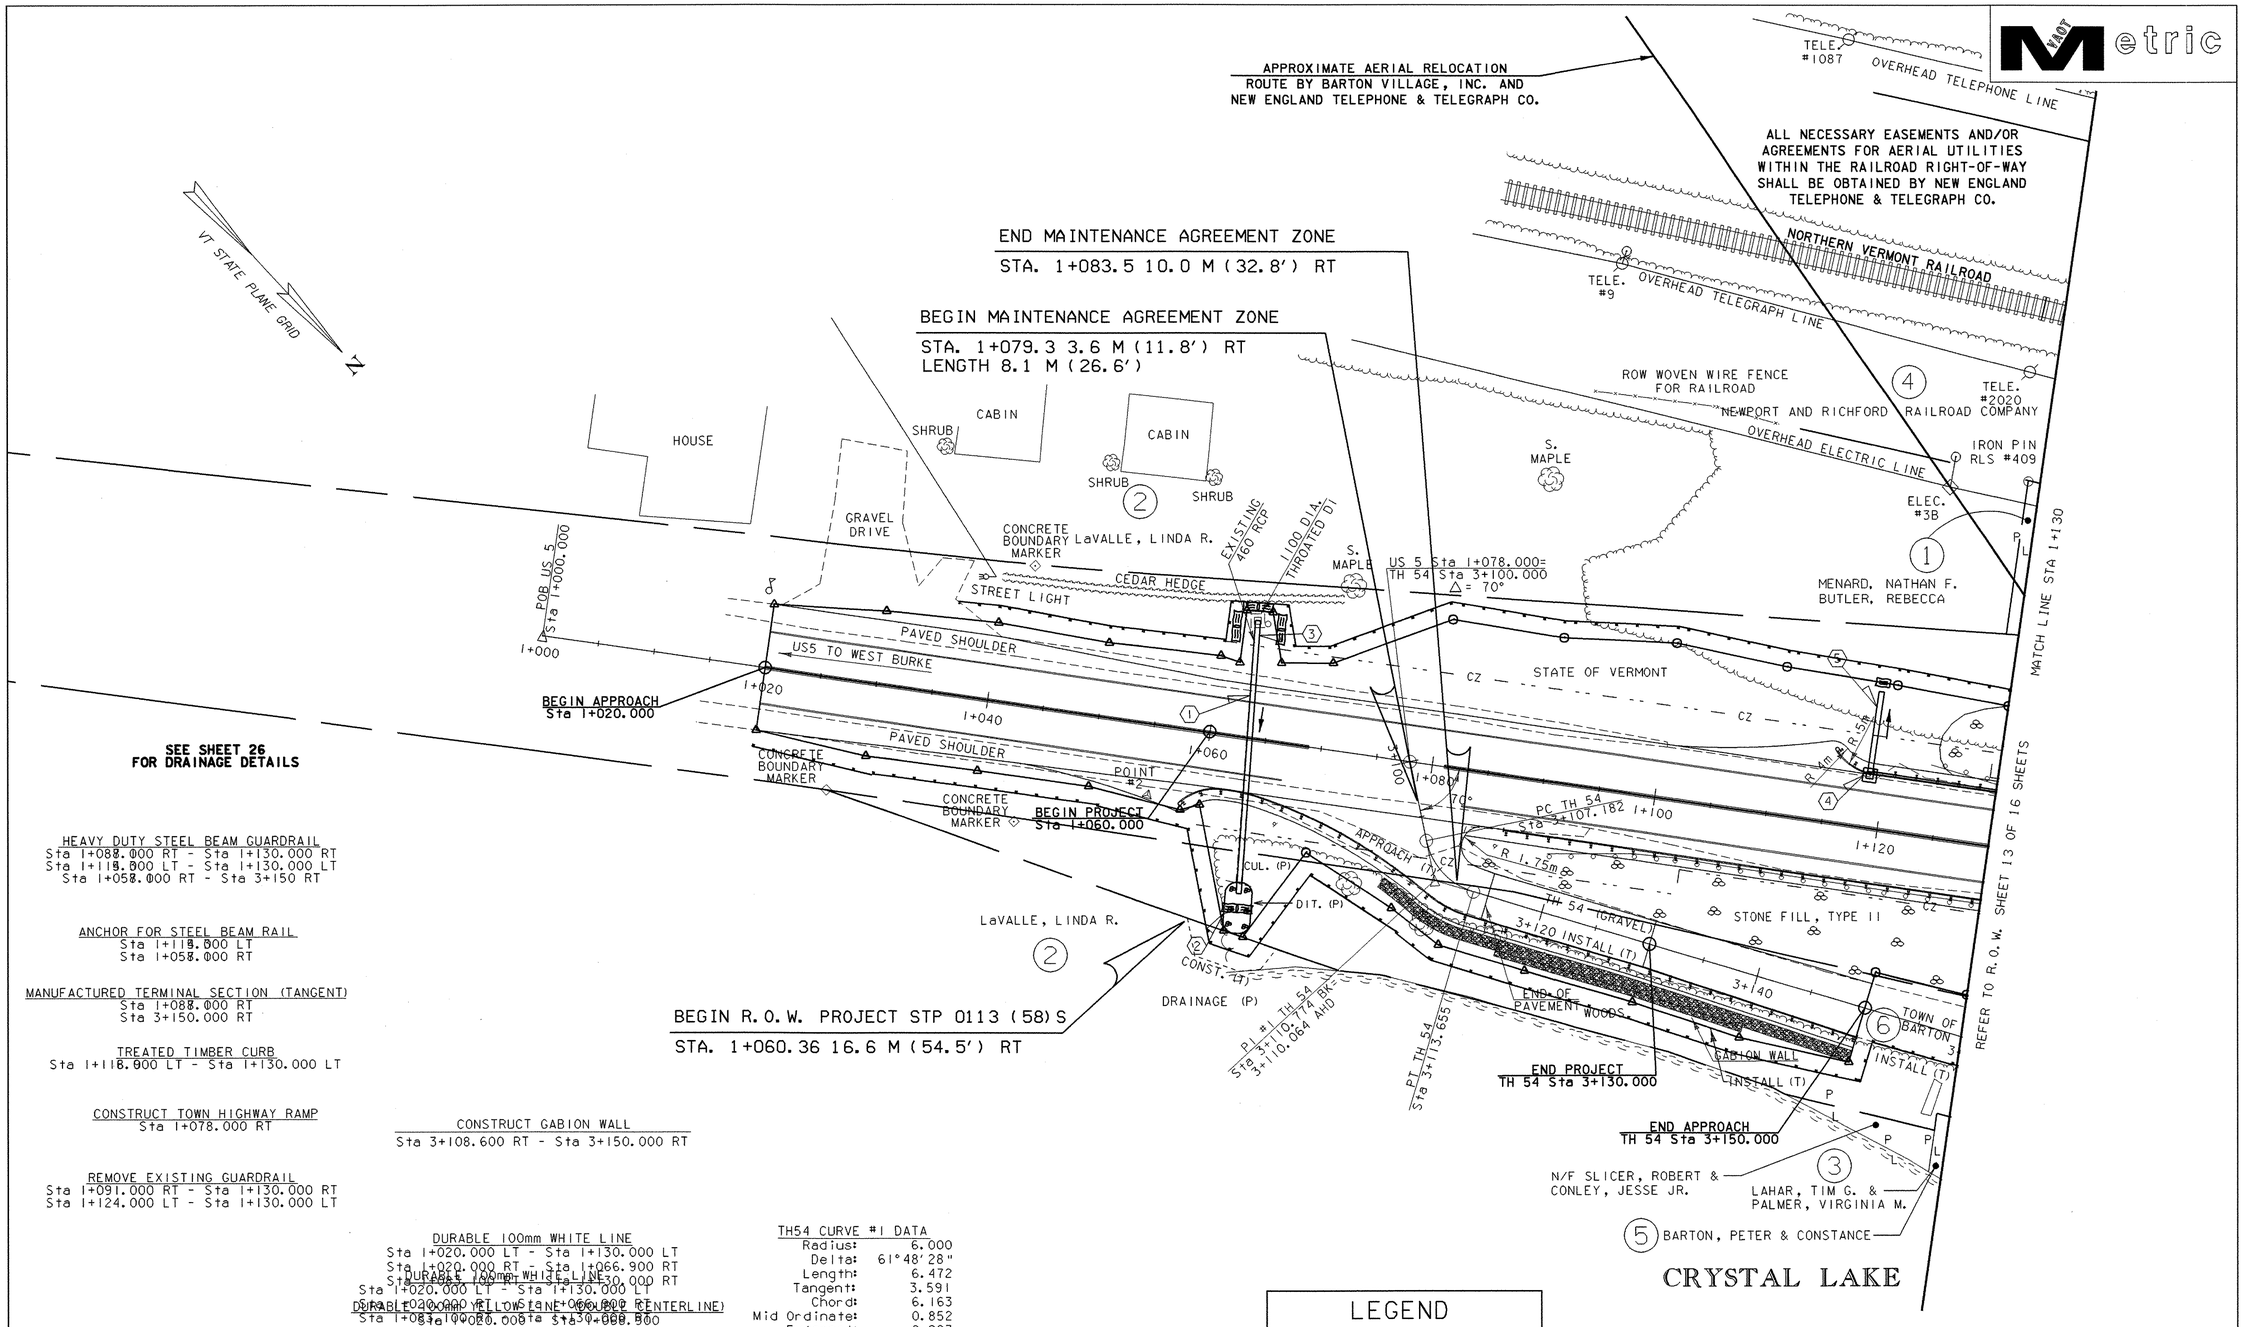

SEE SHEET 26
FOR DRAINAGE DETAILS

HEAVY DUTY STEEL BEAM GUARDRAIL
Sta 1+088.000 RT - Sta 1+130.000 RT
Sta 1+118.000 LT - Sta 1+130.000 LT
Sta 1+058.000 RT - Sta 3+150 RT

ANCHOR FOR STEEL BEAM RAIL
Sta 1+118.000 LT
Sta 1+058.000 RT

MANUFACTURED TERMINAL SECTION (TANGENT)
Sta 1+088.000 RT
Sta 3+150.000 RT

TREATED TIMBER CURB
Sta 1+118.000 LT - Sta 1+130.000 LT

CONSTRUCT TOWN HIGHWAY RAMP
Sta 1+078.000 RT

REMOVE EXISTING GUARDRAIL
Sta 1+091.000 RT - Sta 1+130.000 RT
Sta 1+124.000 LT - Sta 1+130.000 LT

CONSTRUCT GABION WALL
Sta 3+108.600 RT - Sta 3+150.000 RT

DURABLE 100mm WHITE LINE
Sta 1+020.000 LT - Sta 1+130.000 LT
Sta 1+020.000 RT - Sta 1+066.900 RT
Sta 1+083.100 RT - Sta 1+130.000 RT

DURABLE 100mm YELLOW LINE (DOUBLE CENTERLINE)
Sta 1+020.000 LT - Sta 1+130.000 LT

DURABLE 100mm YELLOW LINE (DOUBLE CENTERLINE)
Sta 1+020.000 - Sta 1+068.900
Sta 1+081.100 - Sta 1+130.000

REMOVING SIGNS
Sta 1+036.400 RT

REMOVING SIGNS
Sta 1+067.000 RT (2)
Sta 1+085.500 RT (3)

TEMPORARY 100mm WHITE LINE
Sta 1+020.000 LT - Sta 1+130.000 LT
Sta 1+020.000 RT - Sta 1+066.900 RT
Sta 1+083.100 RT - Sta 1+130.000 RT

TEMPORARY 100mm YELLOW LINE (DOUBLE CENTERLINE)
Sta 1+020.000 - Sta 1+068.900
Sta 1+081.100 - Sta 1+130.000

TH54 CURVE #1 DATA

Radius:	6.000
Delta:	61°48'28"
Length:	6.472
Tangent:	3.591
Chord:	6.163
Mid Ordinate:	0.852
External:	0.993
Max. Bank Rate:	NORMAL

SEE SHEET 46
FOR DRAINAGE DETAILS

SEE SHEET 48
FOR SIGN SUMMARY

LAYOUT #1

0 10 20

SCALE 1 : 250

LEGEND

HAY BALES

SILT FENCE

LINES SHOWN ON THIS PLAN AS EXISTING PROPERTY LINES (P/L) ARE BELIEVED TO BE ACCURATE BUT SHOULD NOT BE RELIED UPON FOR PURPOSES UNRELATED TO THE STATE OF VERMONT'S ACQUISITION OF LAND AND RIGHTS FOR THIS PROJECT.

DATUM

VERTICAL	NAVD88 ASSUMED
HORIZONTAL	NAD 83 (93)

FOR R.O.W. USE ONLY

PROJECT:	PROJECT NO. :
BARTON	STP 0113(58)S

DESIGN FILE NAME: 96c116/structures/sc116bdr.dgn
IPARM FILE NAME: sc116al.i — PLOT DATE: 03-JAN-2002
SURVEYED BY: R. BULLOCK, R. GILMAN — SURVEY DATE: 8/96,5/99
SQUAD LEADER: C.P. WILLIAMS — DRAWN BY: P.G. JARVIS
R.O.W. SHEET 12 OF 16 SHEETS — 84 OF 120