Metric

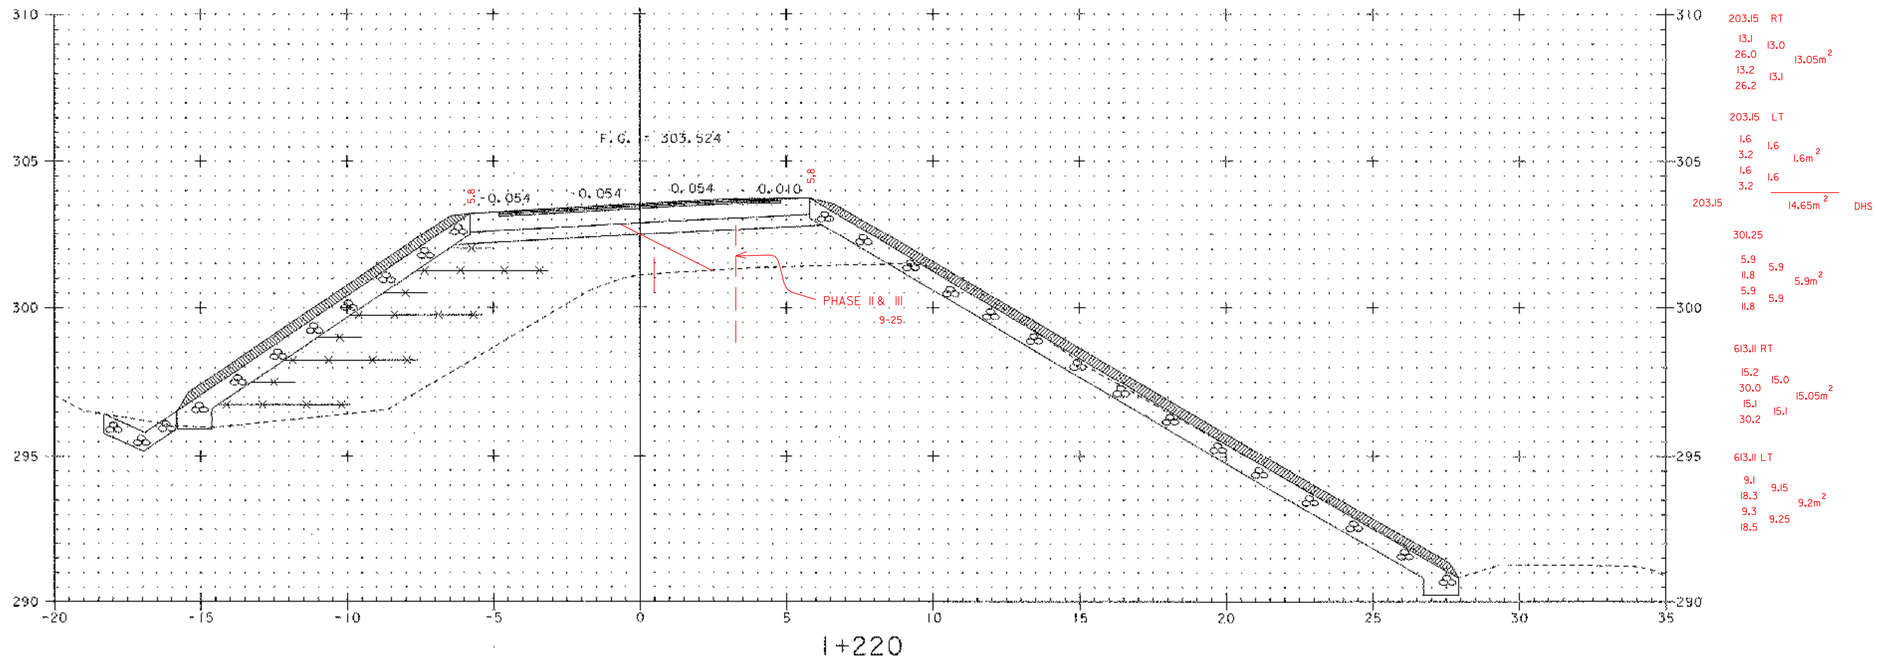

1+220

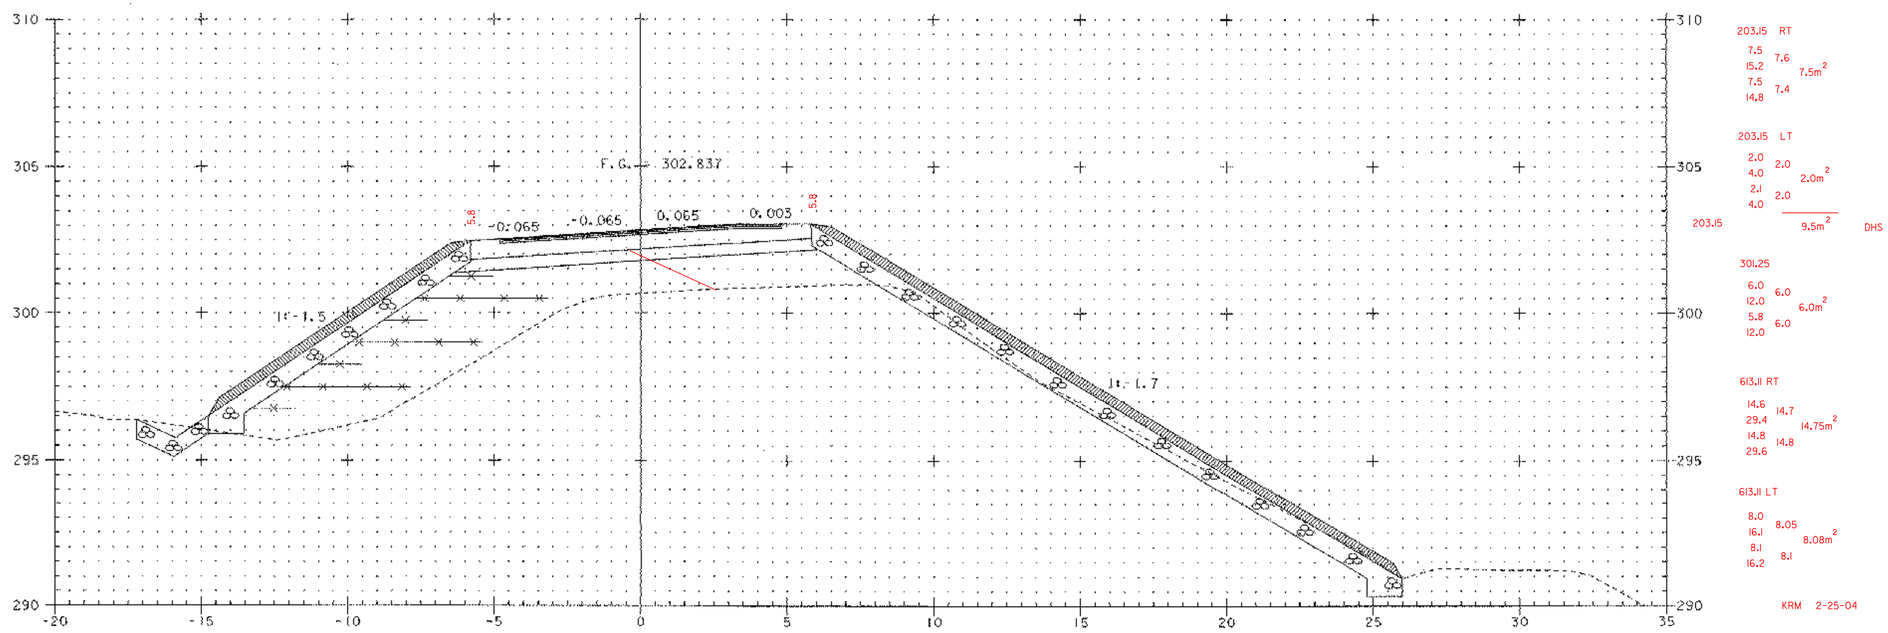

1+210

ARCHIVED ON CADD

KRM 2-25-04

0 2 4 6 8 10
SCALE 1:100

PLOTTED 03-JAN-2002

PROJECT: BARTON	PROJECT NO.: STP 0113 (58) S
DESIGN FILE NAME: 96c116/structures/sc116u5s.dgn IPARM FILE NAME: sc116508.i	PLOT DATE: 03-JAN-2002
Relocated US5 Cross Sections	
Sta 1+210 THRU Sta 1+220	SHEET: 96 OF 120