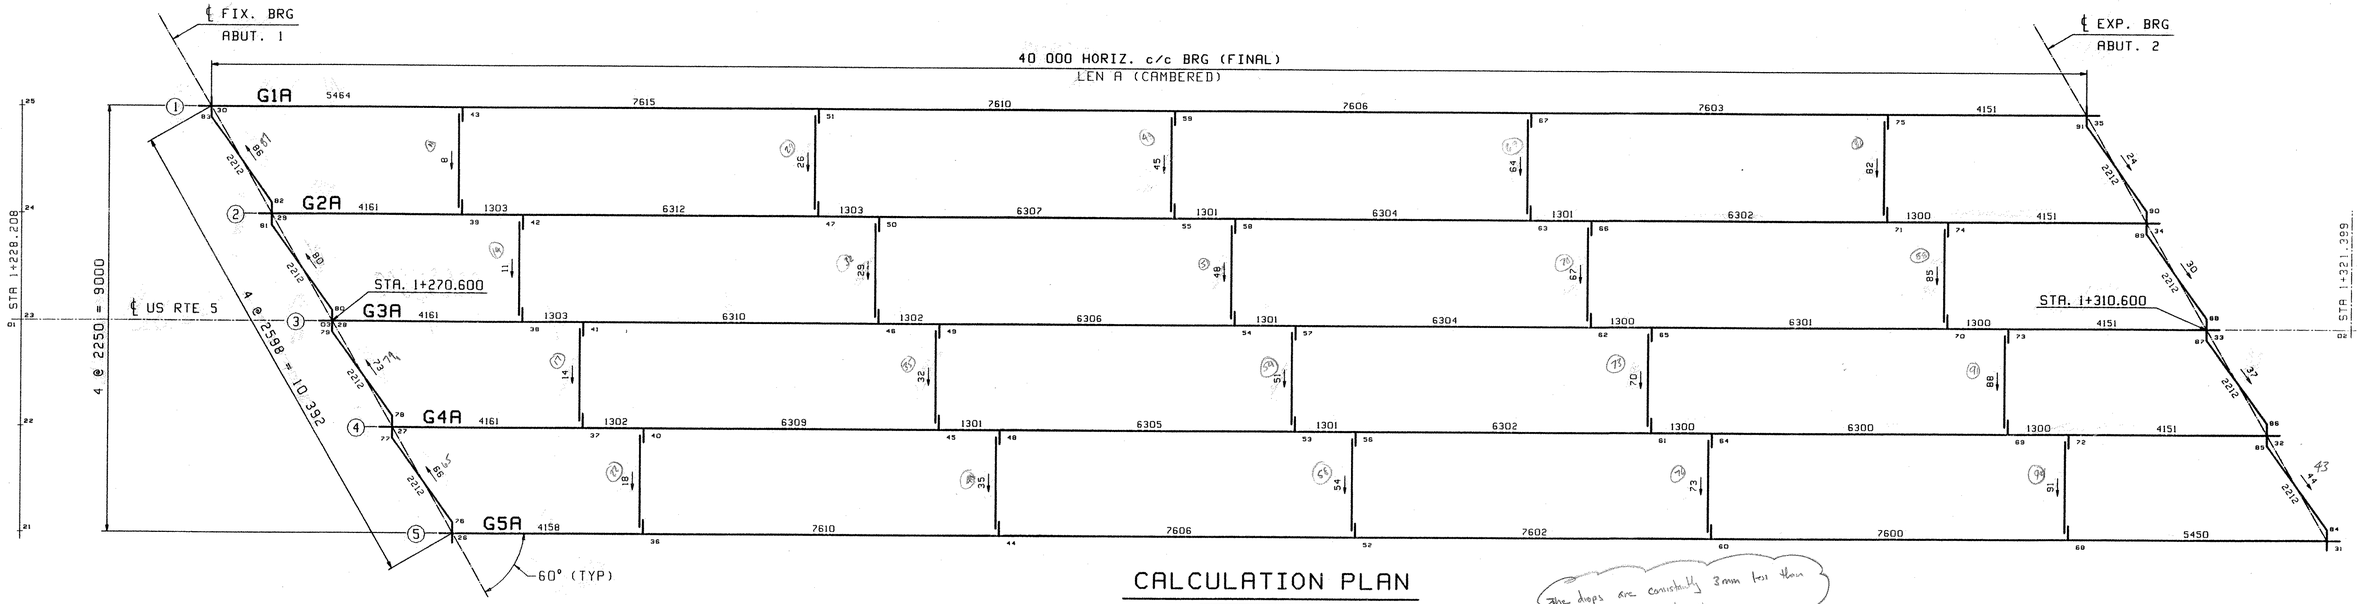

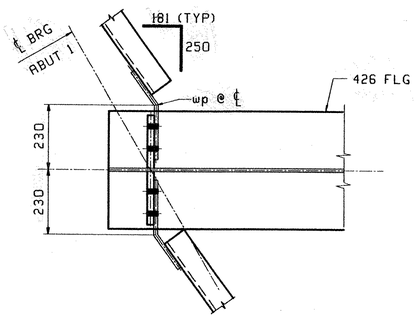

TYPICAL END CROSSFRAME WORKPOINTS

ABUT 1 AS SHOWN, ABUT 2 ROTATE 180°

CALCULATION PLAN

	CAMB. LEN @ BTM OF WEB	FINAL GRADE @ BRGS	
Line	LEN A	ABUT 1	ABUT 2
1	40 049	.0669	.0526
2	40 045	.0648	.0495
3	40 039	.0621	.0467
4	40 032	.0593	.0440
5	40 026	.0562	.0419

The drops are consistently 3mm less than what I calc, but ok.

RECEIVED
CK'D BY Was OK'D BY KSF
SEP 04 2002
RESUBMIT _____ APPROVED As Noted
BY CPW DATE 9/17/02

**** NOTE ****
THE PURPOSE OF THIS DRAWING IS TO COORDINATE GEOMETRIC CONTROL INFORMATION. THIS DWG IS SUBMITTED FOR INFORMATION ONLY AND IS NOT INTENDED FOR SHOP FABRICATION.

NOTES
1. LONGITUDINAL DIMENSIONS ARE SLOPING ALONG BOTT OF WEB. WITH CORRECTIONS MADE FOR VERTICAL CURVE & CAMBER (UN).
2. TRANSVERSE DIMENSIONS ARE IN A HORIZ. PLANE (UN).
3. ARROW POINTS TOWARDS LOW END OF MEMBER.
4. ENDS OF GIRDERS AND BRG. STIFF'S ARE VERTICAL AFTER DL ROTATION.
5. CROSSFRAME STIFF ARE NORMAL TO GRADE.
6. BOTT PT NUMBERS =TOP PT NUMBERS + 100.
7. FOR LAYOUTS SEE DWG TD1.
8. COMBINE INT. CROSSFRAMES FOR DIFF IN DROPS OF +/- 3mm.
9. CROSSFRAMES DROPS ARE CALCULATED IN THEIR FINAL POSITION.

REV.	REMARKS	DATE	DWN	CHK	APP	Q.A.	NO.	DIA.	LGT	TYPE	WASHER
	OUT FOR APPROVAL	5-X-02									
	OUT FOR APPROVAL										
	ISSUED TO SHOP										
	FIELD & OFFICE										

MATERIAL:	ELECTRODES:	HOLES:	SHOP BOLTS:
M270M-345W		24 mm (15/16"ø)	

SURFACE PREP. & PAINT:
-STEEL WITHIN 1500 OF ABUT. 2 END OF GIRDERS SHALL BE PAINTED (SEE GN1)
-ALL OTHER STEEL SHALL BE BLAST CLEANED AND LEFT UNPAINTED.

DESCRIPTION: CALCULATION PLAN	DRAWN BY	DATE
JOB: US Route 5 over Northern Vermont RR	WL	08/01
BRIDGE NO. 161	CHKD BY	
BARTON, VERMONT (ORLEANS COUNTY)	JAK	08/05
TENSOR 2256 CONTRACTOR: WINTERSET	APPROV BY	
	SUPERVISOR	W. J. GATTI
PROJ NO. AC STP 0113 (58) S	Q.A.	
CUSTOMER: VERMONT AGENCY OF TRANSPORTATION		

CASCO BAY STEEL STRUCTURES, INC.
75 SPRING HILL ROAD SACO, MAINE 04072
PHONE (207) 282-7360 FAX. (207) 282-1179

JOB NO.	DRG. NO.
163	WS1
	REV. △

Wed Aug 28 13:28:28 CDT 2002 /users/jobs-2256/dt1 | Rev0