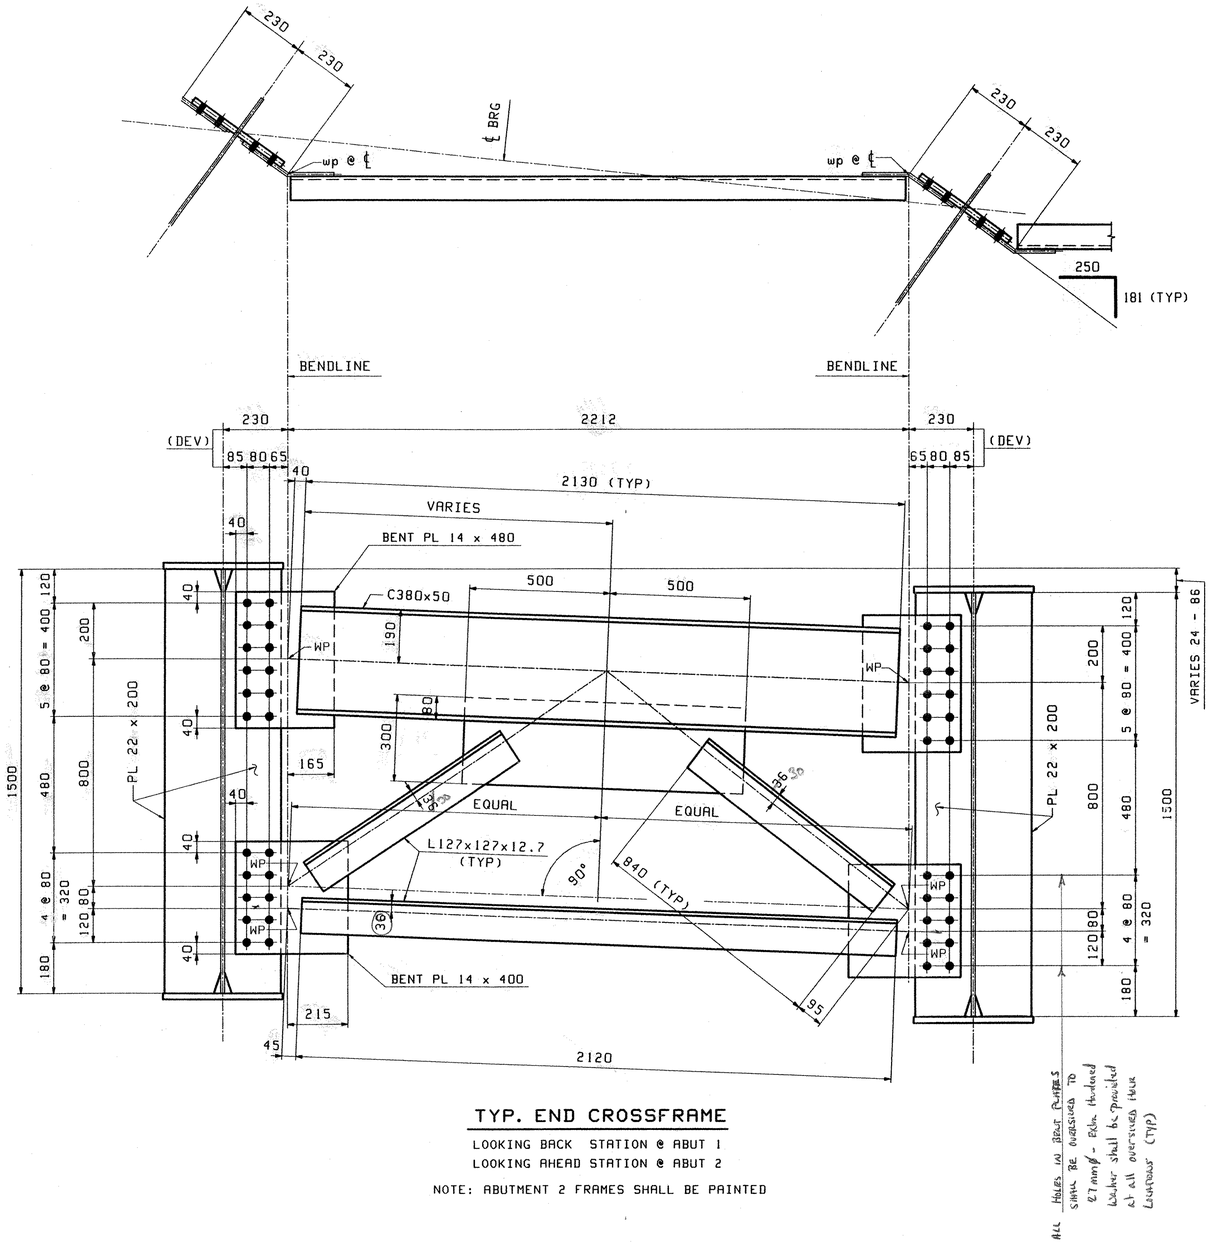

TYP. END CROSSFRAME

LOOKING BACK STATION @ ABUT 1
LOOKING AHEAD STATION @ ABUT 2

NOTE: ABUTMENT 2 FRAMES SHALL BE PAINTED

All holes in bent plates shall be oversized to 27 mm ø. Bolts tightened under shall be specified at all oversized holes (TYP)

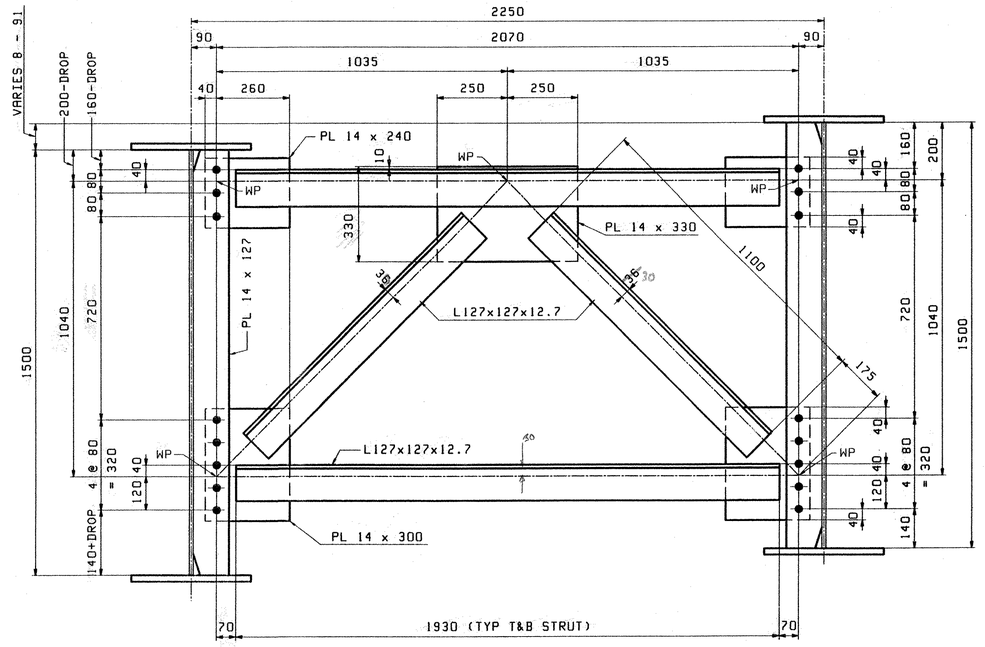

TYP. INTERMEDIATE CROSSFRAME

LOOKING BACK-STATION

REV.	REMARKS	DATE	DWN	CHK	APP	Q.A.
	OUT FOR APPROVAL	5-7-02				
	OUT FOR APPROVAL					
	ISSUED TO SHOP					
	FIELD & FINAL					

NO.	DIA.	LGT	TYPE	WASHER

MATERIAL: M270-50W

ELECTRODES:

HOLES: 24 dia (15/16)ø (UN)

SHOP BOLTS: 22 dia (7/8)ø A325-3

SURFACE PREP. & PAINT:
-STEEL WITHIN 1500 OF ABUT. 2 END OF GIRDERS SHALL BE PAINTED (SEE GN1)
-ALL OTHER STEEL SHALL BE BLAST CLEANED AND LEFT UNPAINTED.

RECEIVED
CK'D BY LWSS OK'D BY RSF
SEP 04 2002
RESUBMIT ____ APPROVED
BY QPW DATE 9/17/02

**** NOTE ****
THE PURPOSE OF THIS DRAWING IS TO COORDINATE GEOMETRIC CONTROL INFORMATION AND CONNECTION SPACING. THIS DWG IS SUBMITTED FOR INFORMATION ONLY & IS NOT INTENDED FOR SHOP FABRICATION. DETAIL DWGS WILL SHOW ALL WELDING AND DIMENSIONS REQ'D FOR FABRICATION.

SCALE 1:10

DESCRIPTION:	CROSSFRAME LAYOUTS	DRAWN BY	DATE
JOB:	US Route 5 over Northern Vermont RR	WL	08/01
	BRIDGE NO. 161	CHKD BY	
	BARTON, VERMONT (ORLEANS COUNTY)	JAK	08/05
TENSOR 2256	CONTRACTOR: WINTERSET	APPROV BY	
		SUPERVISOR	W. J. GATTI
PROJ NO.	AC STP 0113 (58) S	Q.A.	
CUSTOMER:	VERMONT AGENCY OF TRANSPORTATION		

CASCO BAY STEEL STRUCTURES, INC.
75 SPRING HILL ROAD SACO, MAINE 04072
PHONE (207) 282-7360 FAX. (207) 282-1179

JOB NO.	DRG. NO.
163	TD1
	REV. △

JAK Mon Aug 12 13:27:51 EDT 2002 /users/jaks/2256-TD1.Rx=0