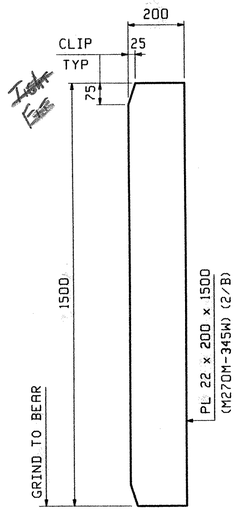

4 ~ x1a
FASCIA BRG STIFF

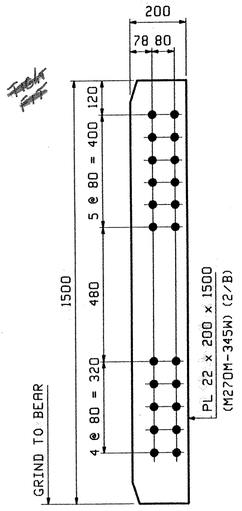

16 ~ x1b
BRG STIFF

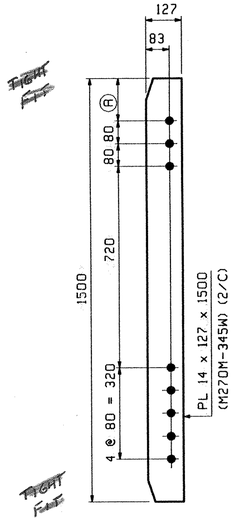

INT. STIFFENER

MARK	REQ'D	A
x1c	20	160
x1d	3	149
x1f	1	142
x1g	3	131
x1h	1	125
x1k	3	112
x1m	1	106
x1n	3	93
x1p	1	87
x1s	3	75
x1t	1	69

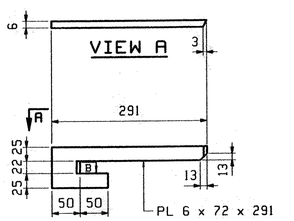

ONE ~ x1v
DRIP PL

VIEW B

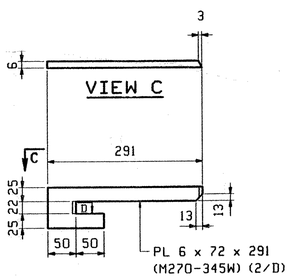

ONE ~ x1w
DRIP PL

VIEW D

RECEIVED
CK'D BY WW OK'D BY RSY
SEP 04 2002
RESUBMIT ____ APPROVED
BY CPW DATE 9/17/02

OUT FOR APPROVAL	8/30/02									
OUT FOR APPROVAL										
ISSUED TO SHOP										
FIELD & OFFICE										
REV.	REMARKS	DATE	DWN	CHK	APP	Q.A.	NO.	DIA.	LGT	TYPE	WASHER

MATERIAL: M270M-345W
ELECTRODES:
HOLES: (24 mm) 15/16" Ø
SHOP BOLTS:

SURFACE PREP. & PAINT:
-STEEL WITHIN 1500 OF ABUT. 2 END OF GIRDERS SHALL BE PAINTED (SEE GN1)
-ALL OTHER STEEL SHALL BE BLAST CLEANED AND LEFT UNPAINTED.

DESCRIPTION: GIRDER STANDARDS
JOB: US Route 5 over Northern Vermont RR
BRIDGE NO. 161
BARTON, VERMONT (ORLEANS COUNTY)
CONTRACTOR: WINTERSET
TENSOR 2256
PROJ NO. AC STP 0113 (58) S
CUSTOMER: VERMONT AGENCY OF TRANSPORTATION

DRAWN BY	DATE
PHG	08/22
CHKD BY	
JB	08/26
APPROV BY	
SUPERVISOR	W. J. GATTI
Q.A.	

CASCO BAY STEEL STRUCTURES, INC.
75 SPRING HILL ROAD SACO, MAINE 04072
PHONE (207) 282-7360 FAX. (207) 282-1179

JOB NO.	DRG. NO.
163	X1
	REV. △