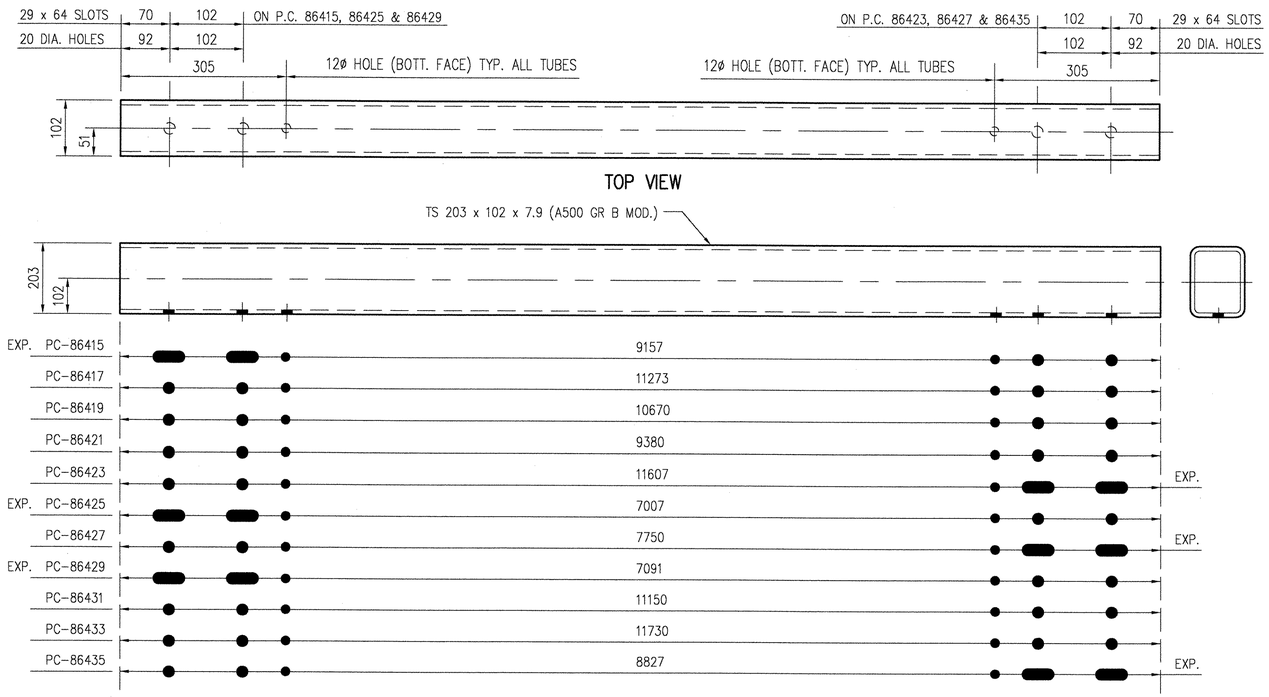

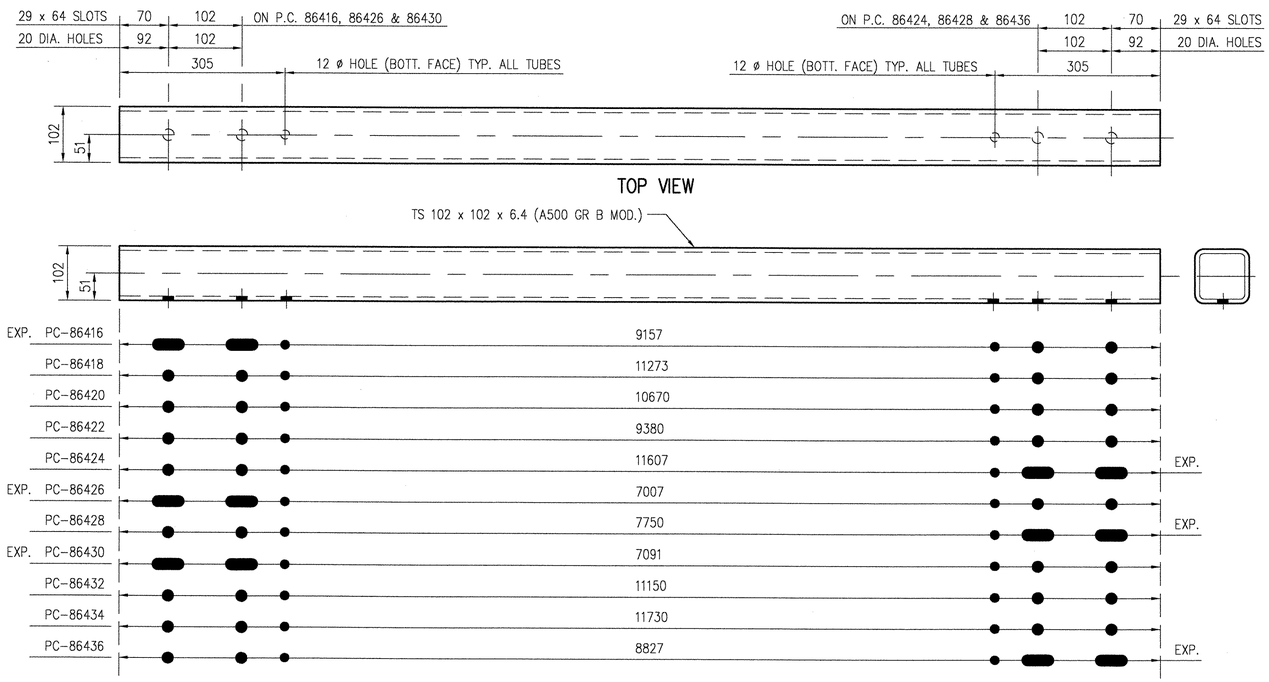

BILL OF MATERIAL

PRODUCT CODE	QTY.	DESCRIPTION	WT. EA.	REMARKS
86415G	1	TS 203 x 102 x 7.9 x 9157	338 k.g.	
86417G	1	TS 203 x 102 x 7.9 x 11273	416 k.g.	
86419G	1	TS 203 x 102 x 7.9 x 10670	394 k.g.	
86421G	3	TS 203 x 102 x 7.9 x 9380	346 k.g.	
86423G	1	TS 203 x 102 x 7.9 x 11607	428 k.g.	
86425G	1	TS 203 x 102 x 7.9 x 7007	286 k.g.	
86427G	1	TS 203 x 102 x 7.9 x 7750	256 k.g.	
86429G	1	TS 203 x 102 x 7.9 x 7091	262 k.g.	
86431G	1	TS 203 x 102 x 7.9 x 11150	411 k.g.	
86433G	1	TS 203 x 102 x 7.9 x 11730	433 k.g.	
86435G	1	TS 203 x 102 x 7.9 x 8827	326 k.g.	
86416G	1	TS 102 x 102 x 6.4 x 9157	177 k.g.	
86418G	1	TS 102 x 102 x 6.4 x 11273	218 k.g.	
86420G	1	TS 102 x 102 x 6.4 x 10670	206 k.g.	
86422G	3	TS 102 x 102 x 6.4 x 9380	181 k.g.	
86424G	1	TS 102 x 102 x 6.4 x 11607	224 k.g.	
86426G	1	TS 102 x 102 x 6.4 x 7007	135 k.g.	
86428G	1	TS 102 x 102 x 6.4 x 7750	150 k.g.	
86430G	1	TS 102 x 102 x 6.4 x 7091	137 k.g.	
86432G	1	TS 102 x 102 x 6.4 x 11150	215 k.g.	
86434G	1	TS 102 x 102 x 6.4 x 11730	226 k.g.	
86436G	1	TS 102 x 102 x 6.4 x 8827	170 k.g.	

RECEIVED
CK'D BY JRS CK'D BY (WRS)
JUL 23 2002
RESUBMIT ____ APPROVED ✓
BY GPW DATE 6/24/02

GIRARD ENGINEERING DEPT.
ISSUED
JUN 25 2002
TRINITY INDUSTRIES, INC.
1170 N. STATE STREET
GIRARD, OHIO 44420

NOTES: APPROVAL DRAWING

1. FOR GENERAL NOTES REFER TO SHEET D1 OF 4
2. FOR ERECTION LAYOUT SEE SHEET E2 OF 2 (22) 1004148

SHOP DRAWING USING METRIC DIMENSIONS

This drawing and the information shown thereon is the sole property of TRINITY INDUSTRIES, INC. Neither the drawing nor such information is to be used for any purpose other than that for which it was specifically furnished by TRINITY INDUSTRIES, INC., nor is any reproduction authorized without written permission.

REV.	CHK'D	BY	DATE	REMARKS

PAY ITEM NUMBER 525.33M ~ ST. BR. RL. 2 RL. NETC

STATE OF VERMONT AGENCY OF TRANSPORTATION
TOWN OF BARTON COUNTY OF ORLEANS
US ROUTE 5 OVER NORTHERN VERMONT RAILROAD
PROJECT #STP0113(58)S BRIDGE No. 161

CUSTOMER NORTHLAND SPECIALTIES P.O. No. VERBAL

TRINITY INDUSTRIES, INC.
HIGHWAY SAFETY PRODUCTS
2525 STEMMONS FREEWAY, DALLAS, TX 75207

DRAWN	SAR
CHECKED	JRS
SCALE:	N.T.S.
DATE	6/12/02
ENG. FILE #	22-1004148-D2
SHT.No.	D2 OF 4
TRINITY SALES ORDER NO.	(22) 1004148
REV.	0

F:\RrShare\Engineering\WIP\VT1004148\22-1004148-D2.dwg 6/25/02 12:18:01