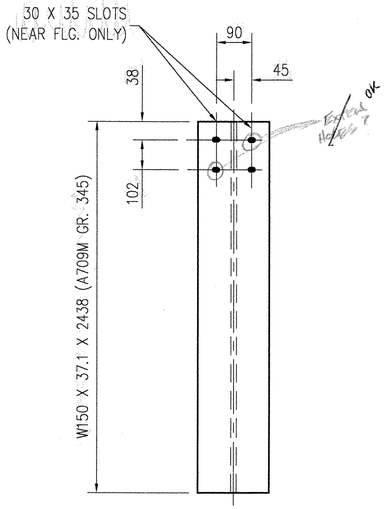

PC 24808 POST

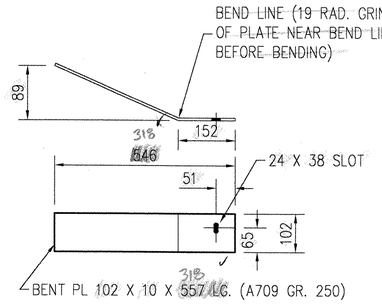

PC 35255 DEFLECTOR PL (AS SHOWN)
PC 35256 DEFLECTOR PL (OPP. HAND)

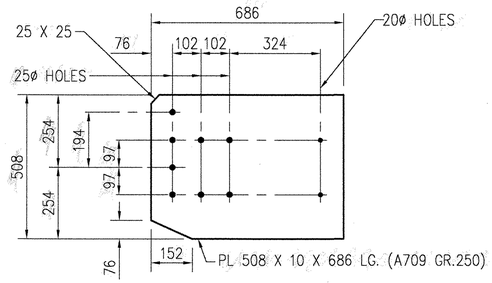

PC 35253 CONNECTION PL

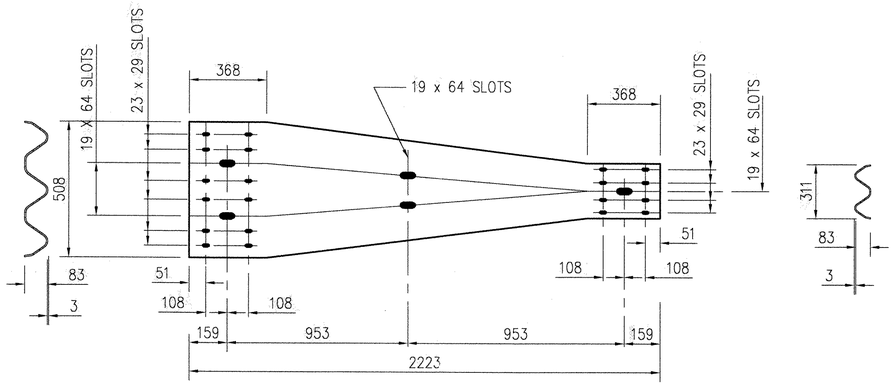

PC 974 TRANSITION
(M180)

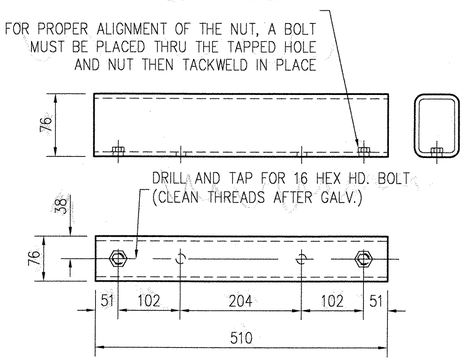

PC 35103 BOTTOM SPLICE TS 76 x 76 x 7.9 (A500 GR B)

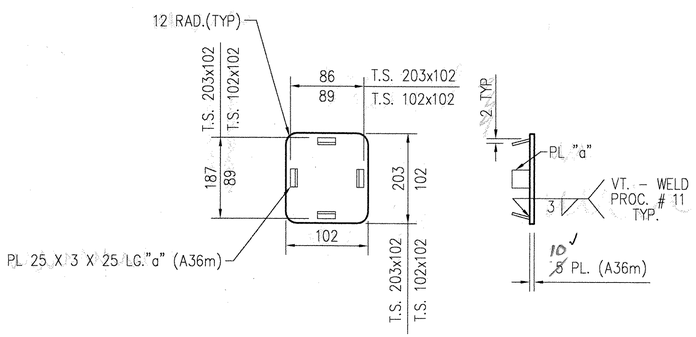

PC 32876 203 x 102 TOP END CAP
PC 32877 102 x 102 BOTT. END CAP

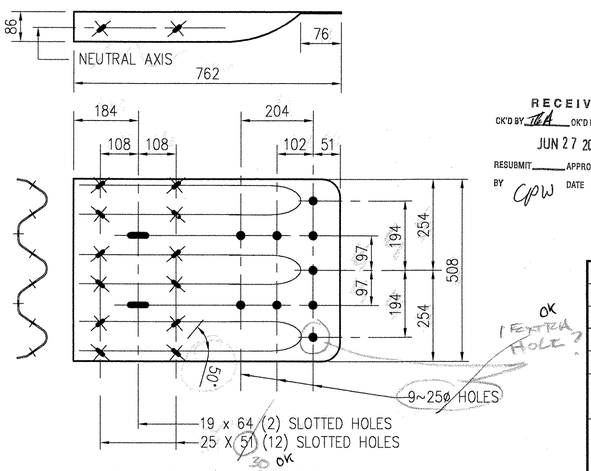

PC 35201 TRI-GRD TERMINAL
10 GA. (M180)

BILL OF MATERIAL

PRODUCT CODE	QTY	DESCRIPTION	WT EACH	REMARKS
24808G	16	W150 x 37.1 x 2438 POST	94kg.	
974G	4	TRANSITION	35kg.	
35201G	4	TRI-GARD TERMINAL	15kg.	
35253G	4	CONN. PL 508 x 10 x 686	27kg.	
35255G	2	DEFLECTOR PL 102 x 10 x 557	4kg.	AS SHOWN
35256G	2	DEFLECTOR PL 102 x 10 x 557	4kg.	OPP. HAND
32876A	4	TOP END CAP 203 x 102	1kg.	
32877A	4	BOTTOM END CAP 102 x 102	.4kg.	
35209G	32	PIPE SPACER (19ø SCH. 40 X 12)	0.1kg	(A53) (GALV A123) NOT DETAILED
35103A	4	BOTTOM SPLICE TS 76 x 76 x 7.9	8.5kg.	

HARDWARE

3300H	108	16ø WASHER 5/8" WASHER		F844 GALV. A153
3310H	32	16ø LOCKWASHER 5/8" LOCKWASHER		F436 GALV. A153
3320H	76	PLATE WASHER		A36 A123 NOT DETAILED
3340H	204	16ø HGR NUT 5/8" HGR NUT		A563 GR. A GALV. A153
3360H	32	16ø x 32 HGR BOLT 5/8"ø x 1 1/4" HGR BOLT		A307 GR A GALV. A153
3386H	96	16ø x 38 HGR BOLT 5/8"ø x 1 1/2" HGR BOLT		A307 GR A GALV. A153
3390H	32	16ø x 44 HEX HD. BOLT 5/8"ø x 1 3/4" HEX HD. BOLT		A307 GR A GALV. A153
3580H	76	16ø x 457 HGR BOLT 5/8"ø x 1'-6" HGR BOLT		A307 GR A GALV. A153
3669H	4	19ø x 51 CARRIAGE BOLT 3/4"ø x 2" CARRIAGE BOLT		A307 GR. A GALV. A153
3700H	32	19ø WASHER 3/4" WASHER		F844 GALV. A153
3702H	64	19ø WASHER, 51 O.D. 3/4" WASHER, 2" O.D.	TYPE A HARDENED	F436 GALV. A153
3710H	32	19ø HEX NUT 3/4" HEX NUT		A563 GR.A GALV. A153
4682H	64	19ø LOCKNUT 3/4"ø LOCKNUT		A194-2H GALV. A153
4789H	28	19ø x 152 CARRIAGE BOLT 3/4"ø x 6" CARRIAGE BOLT		A307 GR. A GALV. A153
6984H	64	19ø x 152 ROUND HD BOLTSLTD 3/4"ø x 6" ROUND HD BOLT SLTD		A325 GALV. A153

PAY QUANTITY

35.86 LIN. METERS	ITEM 565.22 (4 RUNS @ 8.965)	APPROACH RAIL, TYPE T-2

RECEIVED
CK'D BY TBA CK'D BY WBS
JUN 27 2002
RESUBMIT ____ APPROVED As Noted
BY CPW DATE 7/18/02

VERMONT AGENCY OF TRANSPORTATION ENGINEERING DEPT.
ISSUED
JUN 19 2002
TRINITY INDUSTRIES, INC.
1170 N. STATE STREET
GIRARD OHIO 44420

APPROVAL DRAWING

SHOP DRAWING USING METRIC DIMENSIONS

SEE NOTES ON SHEET 30-1004148-D1
ERECTION DETAILS ARE ON SHEET 30-1004148-D1

REV.	CHK'D	BY	DATE	REMARKS

PAY ITEM 621.72 BRIDGE APPROACH RAIL T2

STATE OF VERMONT AGENCY OF TRANSPORTATION
US ROUTE 5
TOWN OF BARTON COUNTY OF ORLEANS
STATE PROJECT NO. STP 0113 (58) S BRIDGE NO. 161

CUSTOMER **NORTHLAND SPECIALTIES** P.O. No. **VERBAL**

TRINITY INDUSTRIES, INC.
HIGHWAY SAFETY PRODUCTS
2525 STEMMONS FREEWAY, DALLAS, TX 75207

DRAWN	JRS
CHECKED	SH
SCALE	N.T.S.
DATE	06/05/02
ENG. FILE #	30-1004148-D2
SHT.No.	D2 OF 2
TRINITY SALES ORDER NO.	REV.
(30) 1004148	0

This drawing and the information shown thereon is the sole property of TRINITY INDUSTRIES, INC. Neither the drawing nor such information is to be used for any purpose other than that for which it was specifically furnished by TRINITY INDUSTRIES, INC., nor is any reproduction authorized without written permission.

F:\R&Share\Engineering\WIP\VT1004148\30-1004148-D2.dwg 6/18/02 14:48:35