Metric

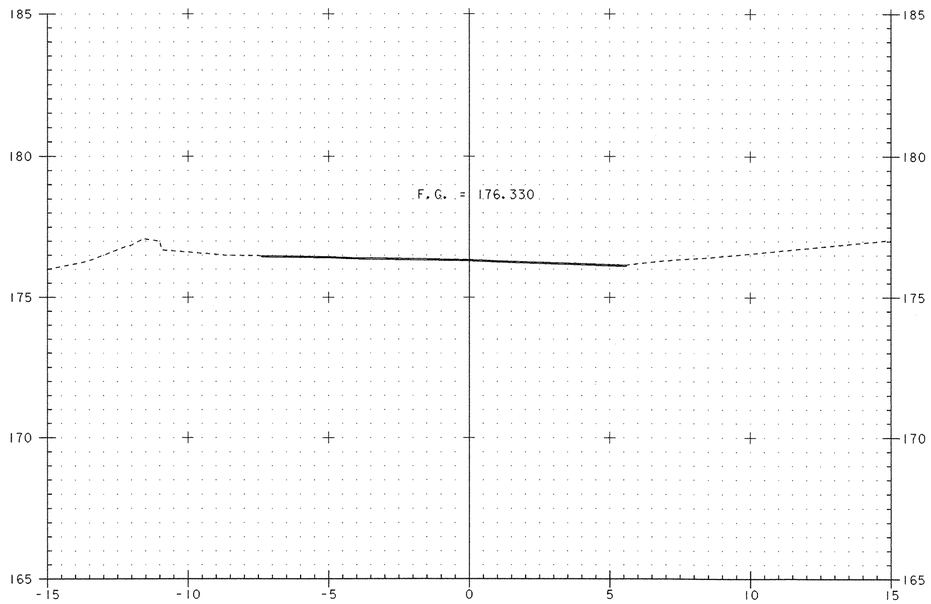


6+050

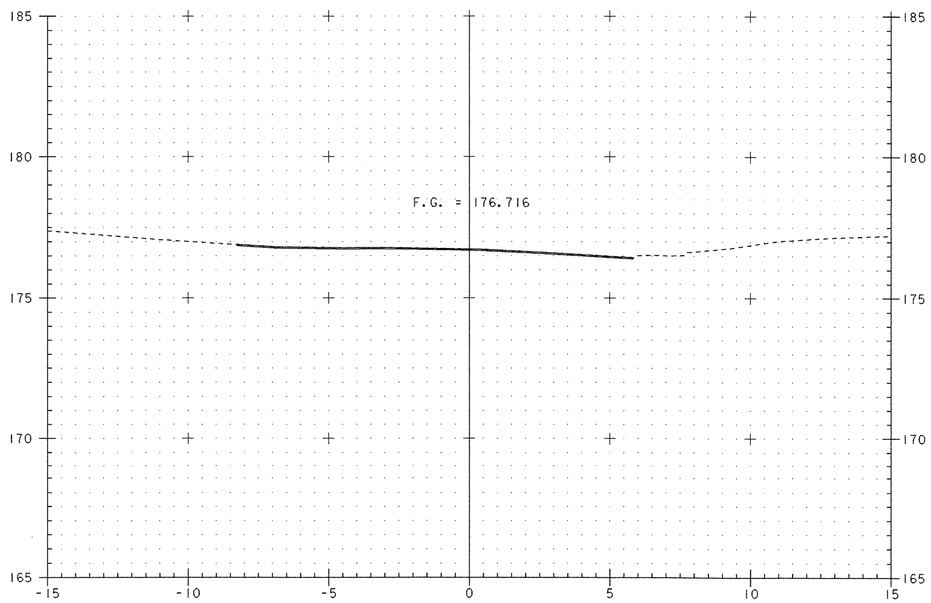


6+040

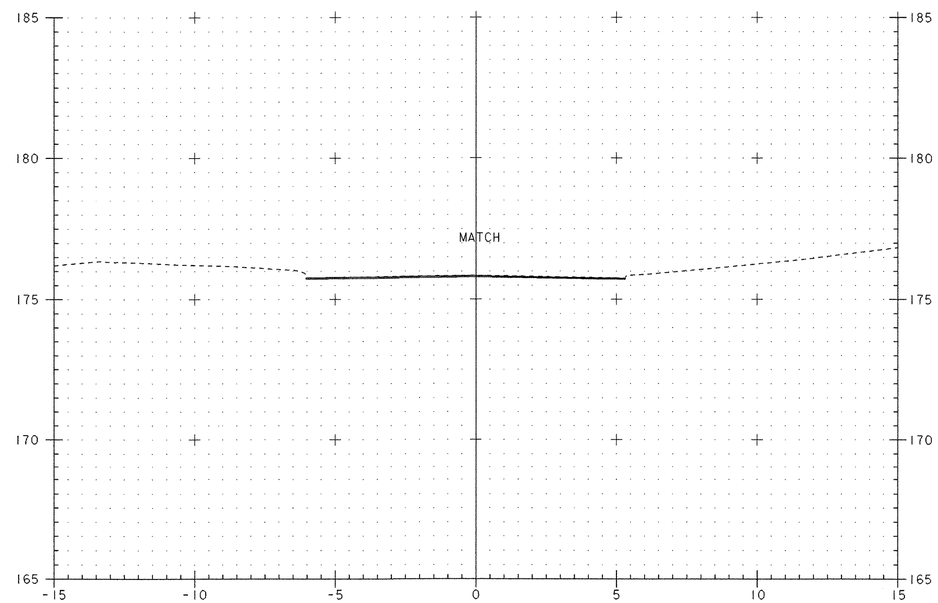


6+060

0 2 4 6 8 10
SCALE 1 : 100

| | |
|---|---|
| PROJECT: BETHEL | PROJECT NO. : BRF 0241 (33) -C1 |
| DESIGN FILE NAME: 96j250/structures/s96j250xsec-c1.dgn<br>IPARM FILE NAME: s96j250xth52.i | PLOT DATE: 09-JUL-2003 |
| TH5 Cross Sections | |
| STA 6+040 THRU STA 6+060 | SHEET: 40 OF 47 |