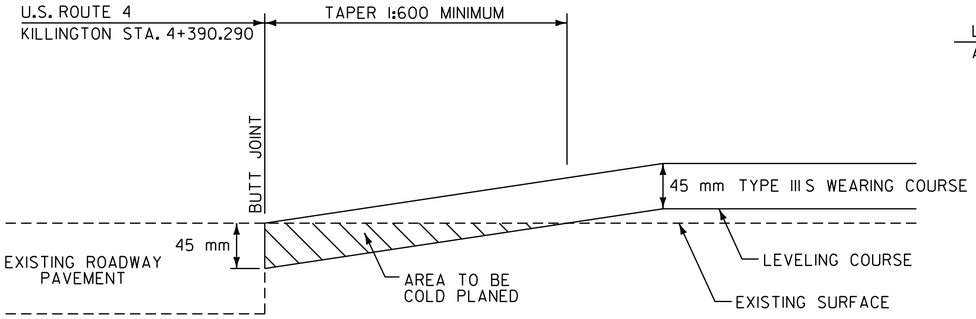

APPROACH AREA DETAIL

U.S. ROUTE 4 KILLINGTON STA. 4+390.290 - END OVERLAY

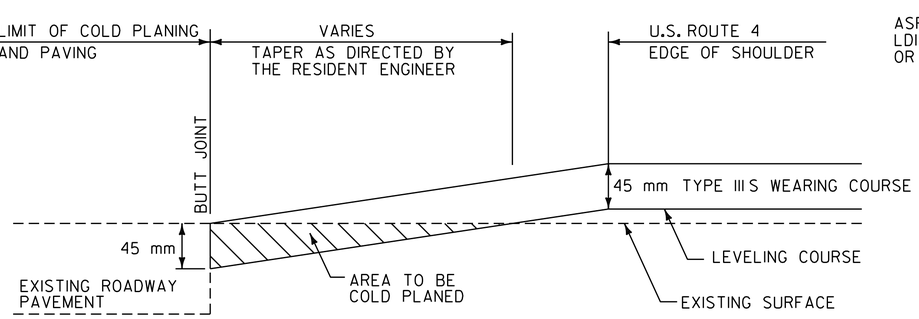

APPROACH AREA DETAIL

SHOPPING CENTER

T-54	T-4
T-30	T-14
T-63	T-120
T-2	T-82
T-3	T-41
T-1	T-85
T-13	VT. ROUTE 100
T-7	VT. ROUTE 100
T-22	T-2
T-9	T-52

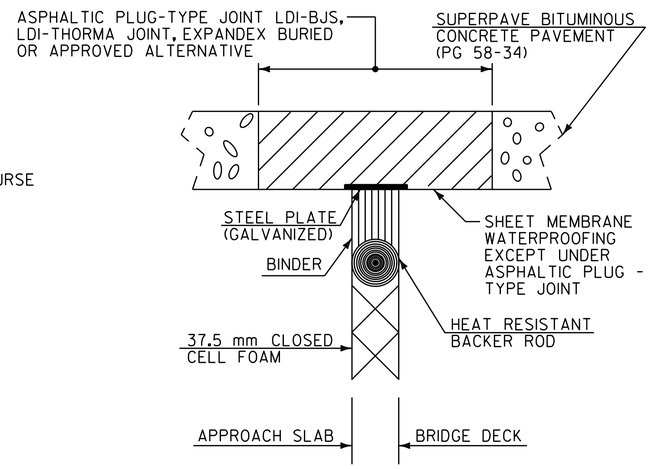

ASPHALTIC PLUG-TYPE JOINT DETAIL

U.S. ROUTE 4 MENDON STA. 3+874.500 (20.8 m)
U.S. ROUTE 4 MENDON STA. 3+916.000 (17.9 m)

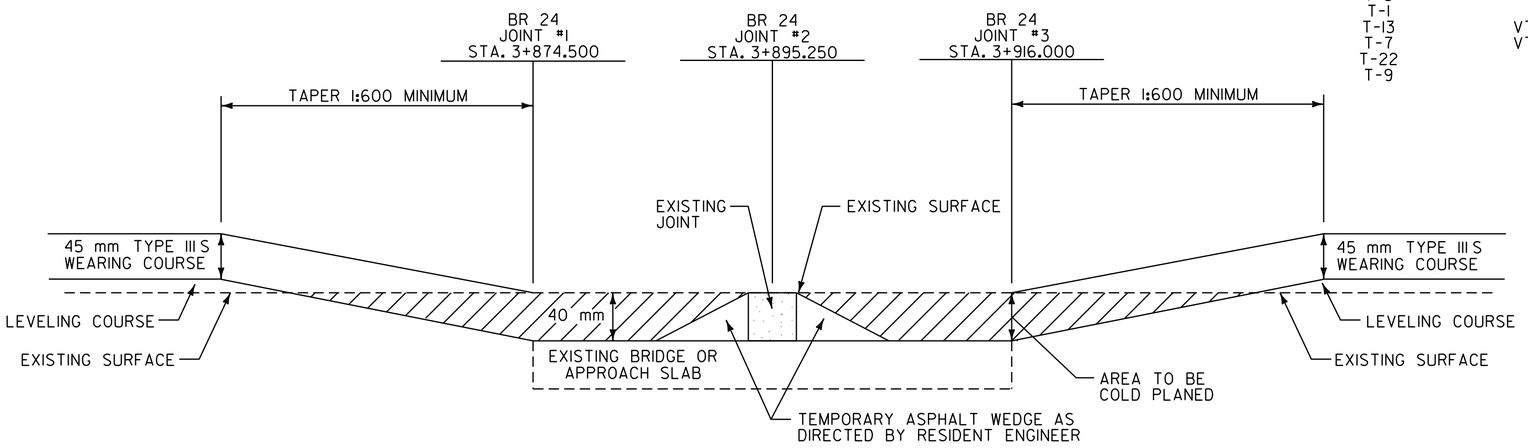

TRANSITION AREA DETAIL

BR 24 U.S. ROUTE 4 MENDON STA. 3+874.500 TO STA. 3+916.000

NOTE: THE CONTRACTOR MUST USE CARE WHEN COLD PLANING BR 24 AS NOT TO DAMAGE THE BRIDGE MEMBRANE. IF DAMAGE TO THIS MEMBRANE SHOULD OCCUR DURING THE COLD PLANING OF BR 24, THE CONTRACTOR SHALL REPLACE THE BRIDGE MEMBRANE AT NO COST TO THE STATE.

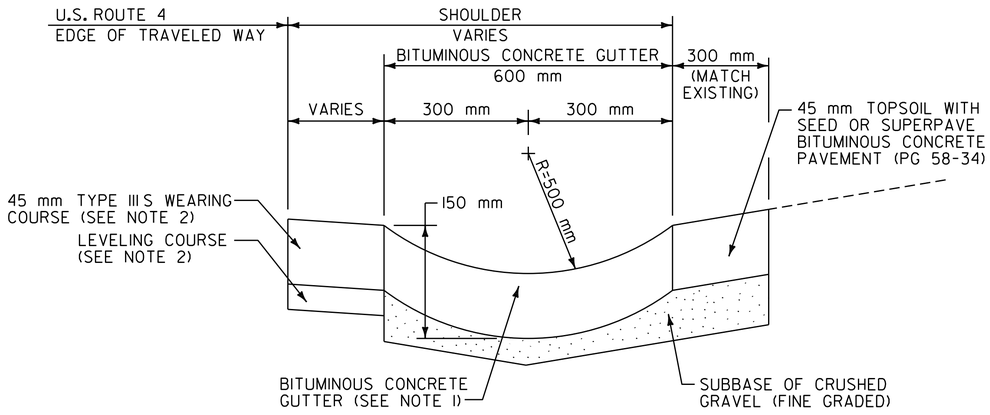

BITUMINOUS CONCRETE GUTTER DETAIL

NOTES:
1. BITUMINOUS CONCRETE GUTTER TO BE CONSTRUCTED BY PLACING 1-45 mm TYPE III S SUPERPAVE BITUMINOUS CONCRETE PAVEMENT LIFT. PAYMENT UNDER ITEM 616.47 BITUMINOUS CONCRETE GUTTERS AND TRAFFIC ISLANDS.
2. THE LEVELING COURSE AND 45 mm TYPE III S WEARING COURSE ADJACENT TO THE TRAVELED WAY SHALL BE PLACED AT THE SAME CROSS SLOPE AS THE TRAVELED WAY. PAYMENT UNDER ITEM 490.30 SUPERPAVE BITUMINOUS CONCRETE PAVEMENT (58-34).

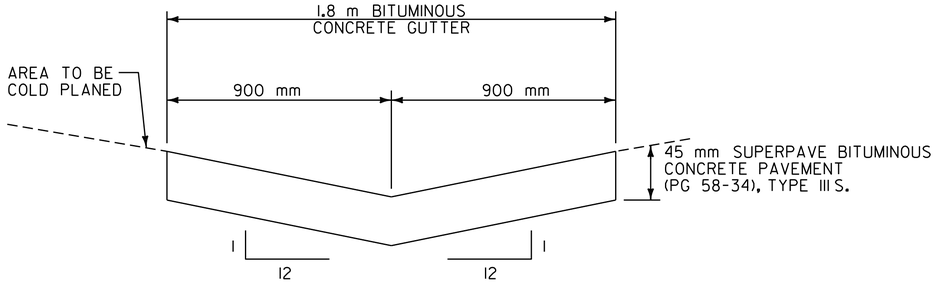

BITUMINOUS CONCRETE GUTTER DETAIL

U.S. ROUTE 4 RUTLAND STA. 0+291.291RT (VERMONT PET CENTER)

BITUMINOUS CONCRETE GUTTER TO BE CONSTRUCTED BY PLACING 1-45 mm TYPE III S SUPERPAVE BITUMINOUS CONCRETE PAVEMENT (PG 58-34) LIFT. PAYMENT UNDER ITEM 616.47 BITUMINOUS CONCRETE GUTTERS AND TRAFFIC ISLANDS.

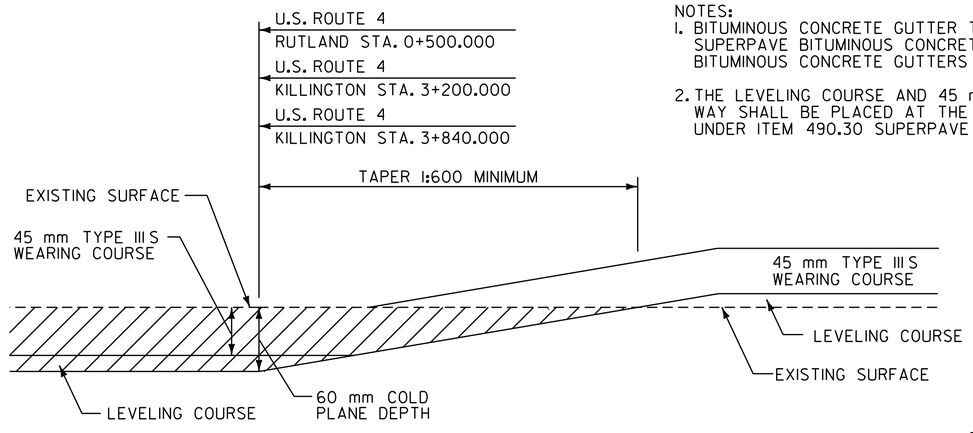

TRANSITION AREA DETAIL

U.S. ROUTE 4 RUTLAND STA. 0+500.000 END COLD PLANE - BEGIN OVERLAY
U.S. ROUTE 4 KILLINGTON STA. 3+200.000 END OVERLAY - BEGIN COLD PLANE
U.S. ROUTE 4 KILLINGTON STA. 3+840.000 END COLD PLANE - BEGIN OVERLAY

ARCHIVED IN DPR

DATUM
VERTICAL N/A
HORIZONTAL N/A

PAVING DETAILS AND PAVEMENT JOINT DETAIL SHEET

SURVEYED BY N/A DATE N/A
DRAWN BY C.A.K. DATE 11/99
SQUAD LEADER T.P.K.
DESIGN FILE NO. /pave/97bl60/pbl60.dgn
IPARM FILE pbl60ty2.i DATE PLOTTED N/A
PROJ. NAME RUTLAND - KILLINGTON
PROJ. NO. NH 9809(11)S
SHEET 3 OF 83 SHEETS

USER - $NTUSER$