 

NOTE:

PRELIMINARY PROJECT LAYOUT

SHEETS