


LEGEND

- SOIL TYPE BOUNDARY
- 300--- 5' INTERVAL PROPOSED CONTOUR
- 1'--- 1' INTERVAL PROPOSED CONTOUR
- 300--- 5' INTERVAL EXISTING CONTOUR
- 1'--- 1' INTERVAL EXISTING CONTOUR
- EXIST. PROPERTY/ROW LINE
- △ LIMIT OF WORK (LIMIT OF DISTURBANCE)
- [Symbol] SURFACE ROUGHENING
- [Symbol] SILT FENCE
- [Symbol] SILT FENCE WOVEN WIRE
- [Symbol] ROLLED EROSION CONTROL PRODUCT, DITCH/SIDESLOPE
- [Symbol] STABILIZED CONSTRUCTION ENTRANCE (SEE TRAFFIC MANAGEMENT PLANS)
- [Symbol] PIPE INLET PROTECTION
- [Symbol] FILTER FABRIC DROP INLET PROTECTION
- BF- BF - BARRIER FENCE
- PDF- PDF - PROJECT DEMARCATION FENCE
- [Symbol] DUST CONTROL

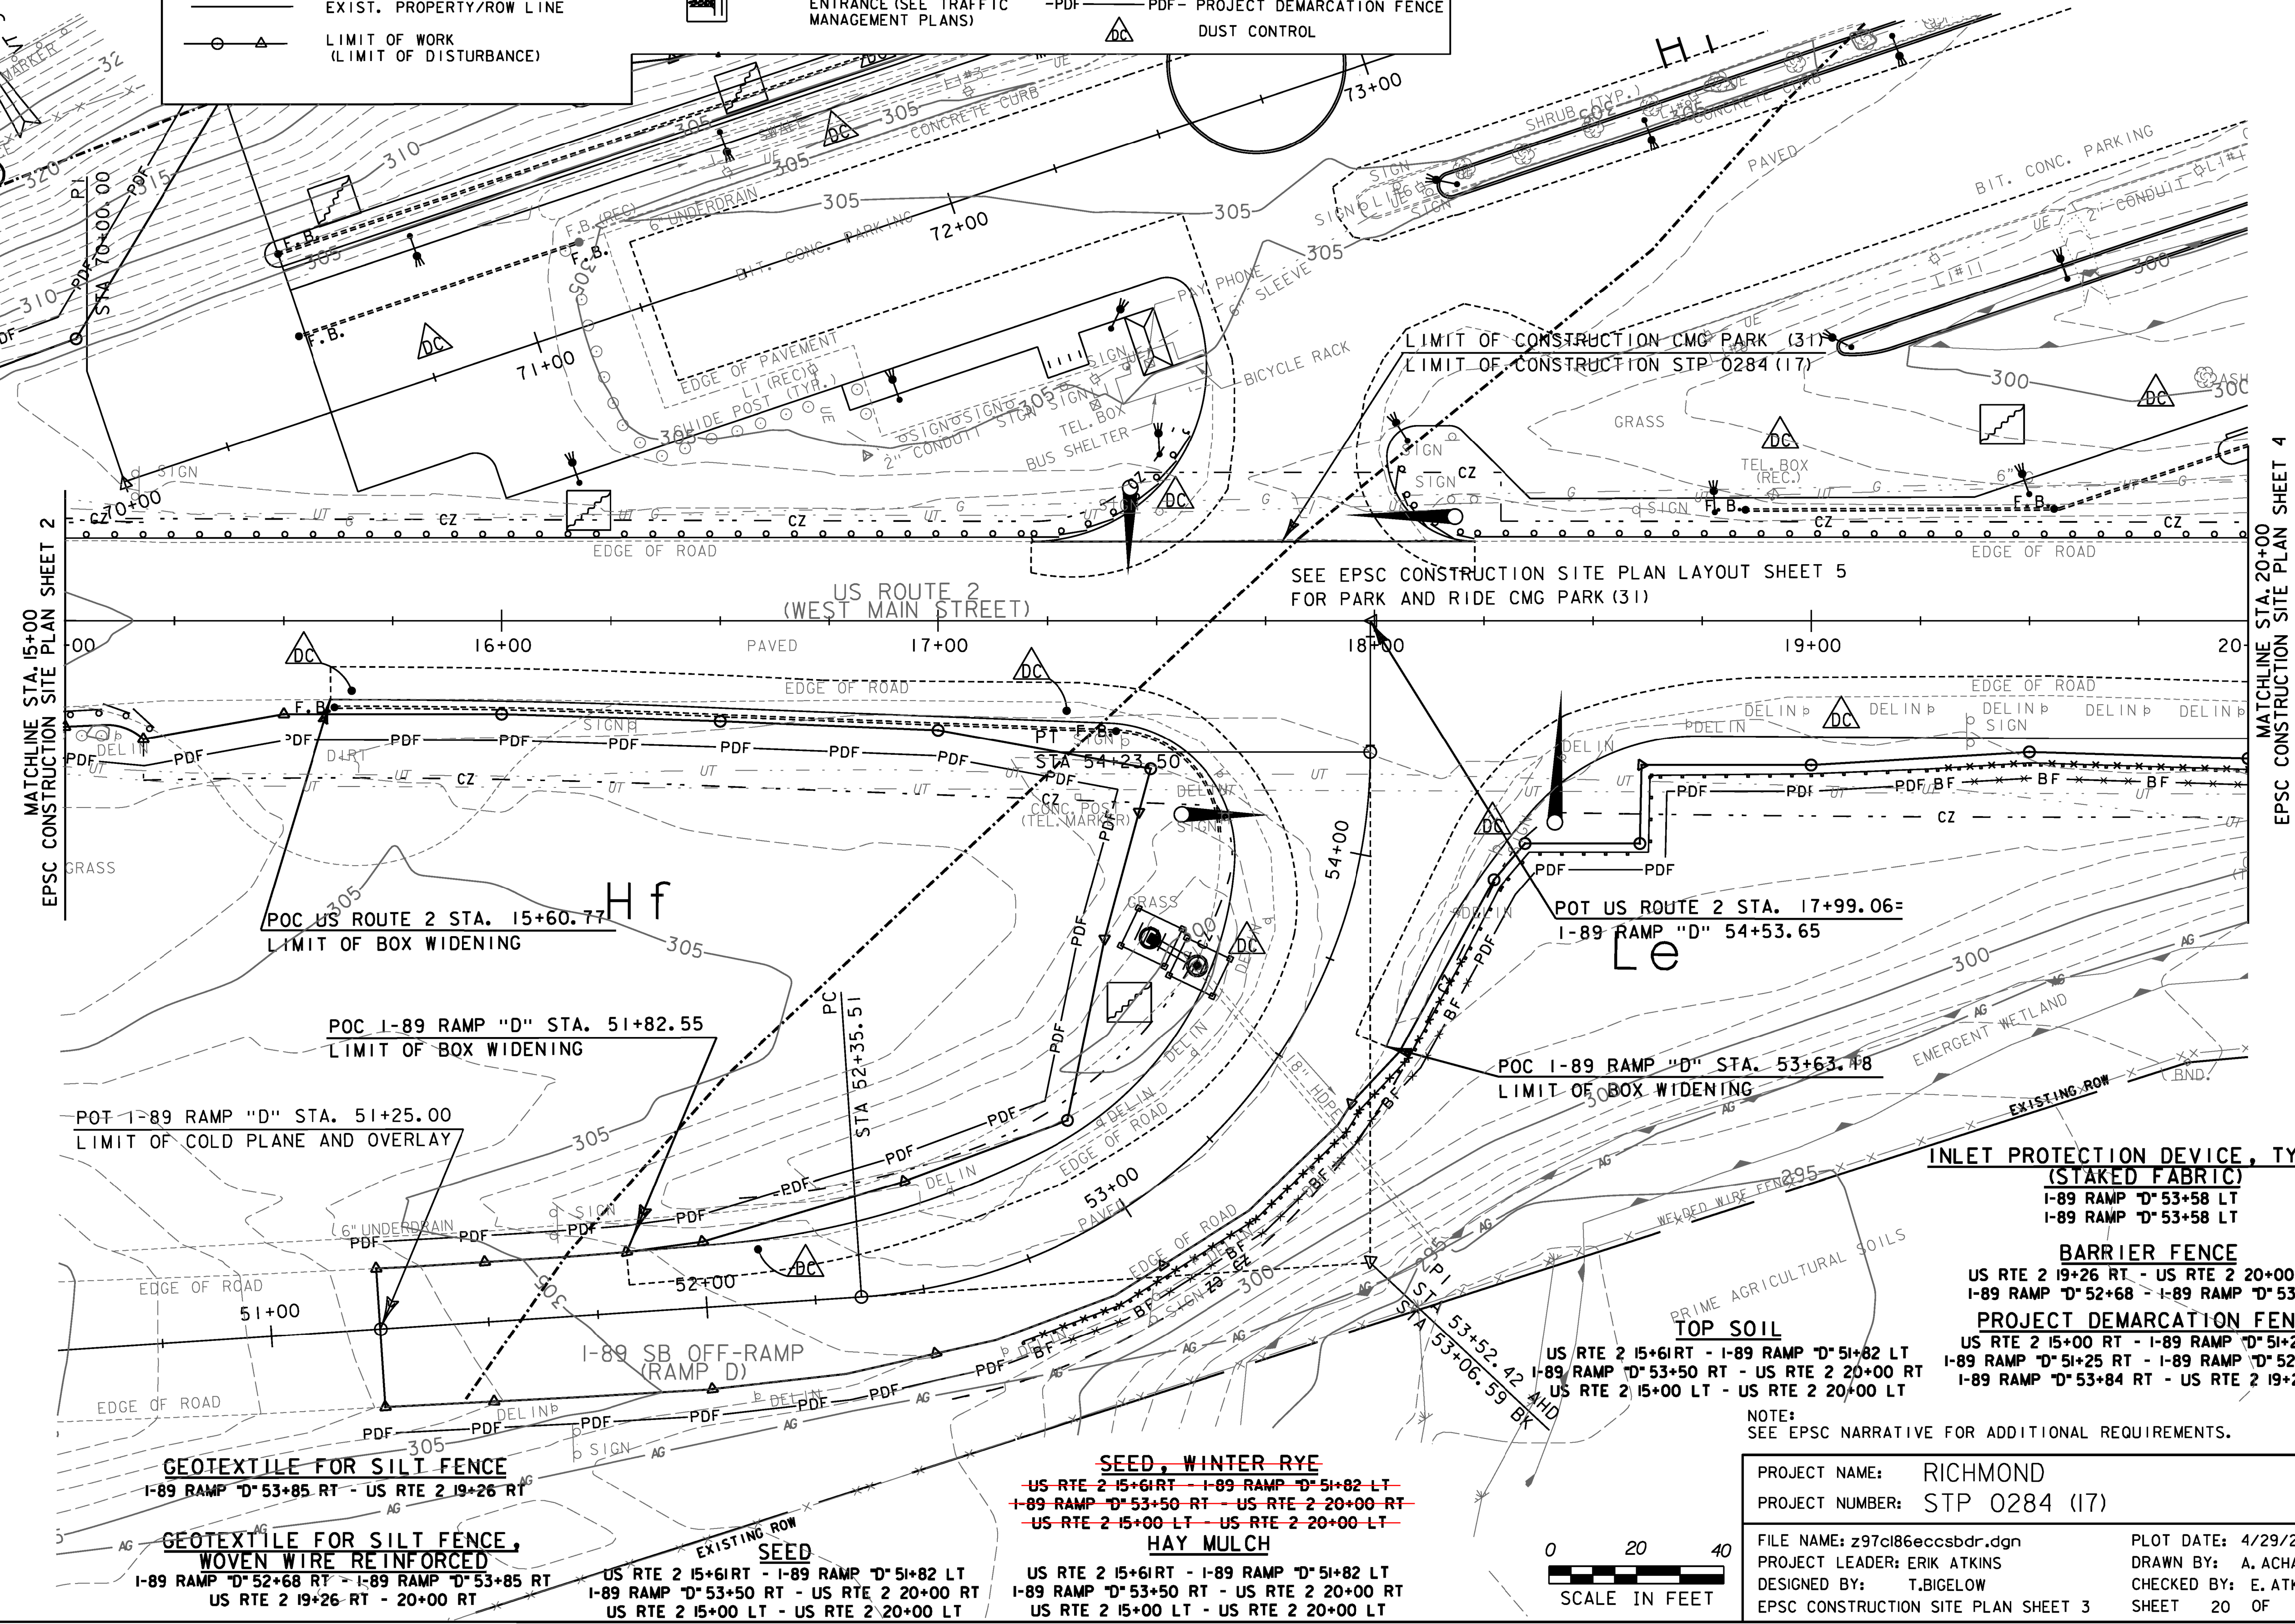

MATCHLINE STA. 15+00
EPSC CONSTRUCTION SITE PLAN SHEET 2

MATCHLINE STA. 20+00
EPSC CONSTRUCTION SITE PLAN SHEET 4

- INLET PROTECTION DEVICE, TYPE I (STAKED FABRIC)**
- I-89 RAMP "D" 53+58 LT
- I-89 RAMP "D" 53+58 LT
- BARRIER FENCE**
- US RTE 2 19+26 RT - US RTE 2 20+00 RT
- I-89 RAMP "D" 52+68 - I-89 RAMP "D" 53+84
- PROJECT DEMARCATION FENCE**
- US RTE 2 15+00 RT - I-89 RAMP "D" 51+25 LT
- I-89 RAMP "D" 51+25 RT - I-89 RAMP "D" 52+68 RT
- I-89 RAMP "D" 53+84 RT - US RTE 2 19+27 RT

NOTE:
SEE EPSC NARRATIVE FOR ADDITIONAL REQUIREMENTS.

PROJECT NAME: RICHMOND	
PROJECT NUMBER: STP 0284 (17)	
FILE NAME: z97cl86eccsbdr.dgn	PLOT DATE: 4/29/2013
PROJECT LEADER: ERIK ATKINS	DRAWN BY: A. ACHARYA
DESIGNED BY: T. BIGELOW	CHECKED BY: E. ATKINS
EPSC CONSTRUCTION SITE PLAN SHEET 3	SHEET 20 OF 133

- SEED, WINTER RYE**
- US RTE 2 15+61 RT - I-89 RAMP "D" 51+82 LT
- I-89 RAMP "D" 53+50 RT - US RTE 2 20+00 RT
- US RTE 2 15+00 LT - US RTE 2 20+00 LT
- HAY MULCH**
- US RTE 2 15+61 RT - I-89 RAMP "D" 51+82 LT
- I-89 RAMP "D" 53+50 RT - US RTE 2 20+00 RT
- US RTE 2 15+00 LT - US RTE 2 20+00 LT

