STATE OF VERMONT
AGENCY OF TRANSPORTATION

TRAFFIC SIGN SUMMARY SHEET 6

MILEMARKER, STATION, OR SIGN NUMBER	SIGN LEGEND	SIGN DIMENSIONS EA	SIGN DIMENSIONS WIDTH (in)	SIGN DIMENSIONS HEIGHT (in)	NEW & SALVAGED SIGNS "A"	NEW & SALVAGED SIGNS "B"	NEW & SALVAGED SIGNS SALV SIGN	NEW & SALVAGED SIGNS SALV TIS	EXIST POST RETAIN	EXIST POST SALVAGE	NEW SIGN POSTS NO. OF POSTS	FLANGED CHANNEL lb/ft 1.12	FLANGED CHANNEL lb/ft 2.0	FLANGED CHANNEL lb/ft 3.0	SQUARE STEEL (in) 1.75 lb/ft 1.88	SQUARE STEEL (in) 2.0 lb/ft 2.42	SQUARE STEEL (in) 2.5 lb/ft 3.35	ANCHOR	SLEEVE	TUBULAR ALUMINUM Ø (in) 3.0 lb/ft 1.3	TUBULAR ALUMINUM Ø (in) 4.0 lb/ft 1.7	TUBULAR ALUMINUM Ø (in) 4.0 MOD lb/ft 1.7	FOUND-ATION	TUBULAR STEEL Ø (in) 3.0 lb/ft 7.6	TUBULAR STEEL Ø (in) 3.5 lb/ft 9.0	TUBULAR STEEL Ø (in) 4.0 lb/ft 10.8	TUBULAR STEEL Ø (in) 5.0 lb/ft 14.6	W-SHAPE STEEL FTG. SIZE 24"	W-SHAPE STEEL FTG. SIZE 30"	W-SHAPE STEEL WEIGHT	W-SHAPE STEEL POST SIZE	SIGN FRAME REQUIRED	REMARKS	SIGN DETAIL S.H.S.*	SIGN DETAIL DETAIL ON SHEET NUMBER	SIGN DETAIL STD. SHEET NUMBER
					SF	SF	EA.	SF				FT			FT				LB			EA.	LB				EA.	EA.	LB							
SHEET 60 TOTALS					13.16		9								65.5							2	283.50 ~~348.75~~													
SHEET 61 TOTALS							17								64.40 ~~91.85~~																					
SHEET 62 TOTALS					24.00		14								72.13 ~~74.0~~																					
SHEET 63 TOTALS					28.5		10								109.25 ~~108.25~~																					
SHEET 64 TOTALS					42.88		1								62.0 ~~55.0~~																					
GRAND TOTALS					108.54		51								△1 373.28 ~~394.6~~							2	△1 283.50 ~~348.75~~													

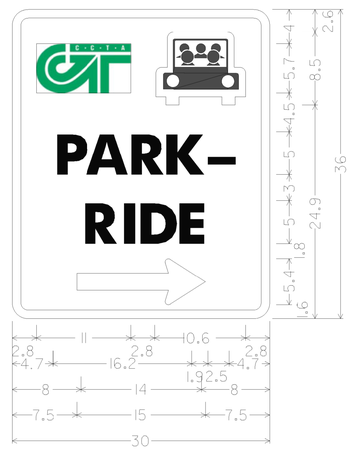

D4-2;
1.9" RADIUS, 1.0" BORDER, WHITE ON GREEN;
SYMBOL RA074;
[PARK -] D 601 SPACING;
[RIDE] D;
STANDARD ARROW CUSTOM 15.0" X 5.4" 01;

SIGN DETAIL
NOT TO SCALE

FINAL POST LENGTHS ARE TO BE DETERMINED IN THE FIELD. POST SIZES ARE COMPUTED BASED ON INFORMATION FURNISHED ON THE VTRANS STANDARD SHEETS AND THE "SIGN POST DESIGN GUIDELINE".

*STANDARD HIGHWAY SIGNS

KEY	DATE	BY	REVISION
△1	11/12/2015	VTRANS	SIGN SUMMARY UPDATE

PROJECT NAME: RICHMOND
PROJECT NUMBER: STP 0284 (17)

FILE NAME: z97c186tss.dgn
PROJECT LEADER: JEFFREY MAXTUTIS
DESIGNED BY: J.SOBEL
TRAFFIC SIGN SUMMARY SHEET 6

PLOT DATE: 4/29/2013
DRAWN BY: Y.CAO/I.ALMY
CHECKED BY: D.FLYNN
SHEET 65 OF 133