LEGEND

— AER E&T — AERIAL ELECTRIC & TELEPHONE

DISTURBED AREAS REQUIRING RE-VEGETATION

LIMITS OF SOIL DISTURBANCE

GRASS CHANNEL

N

VT STATE PLANE GRID

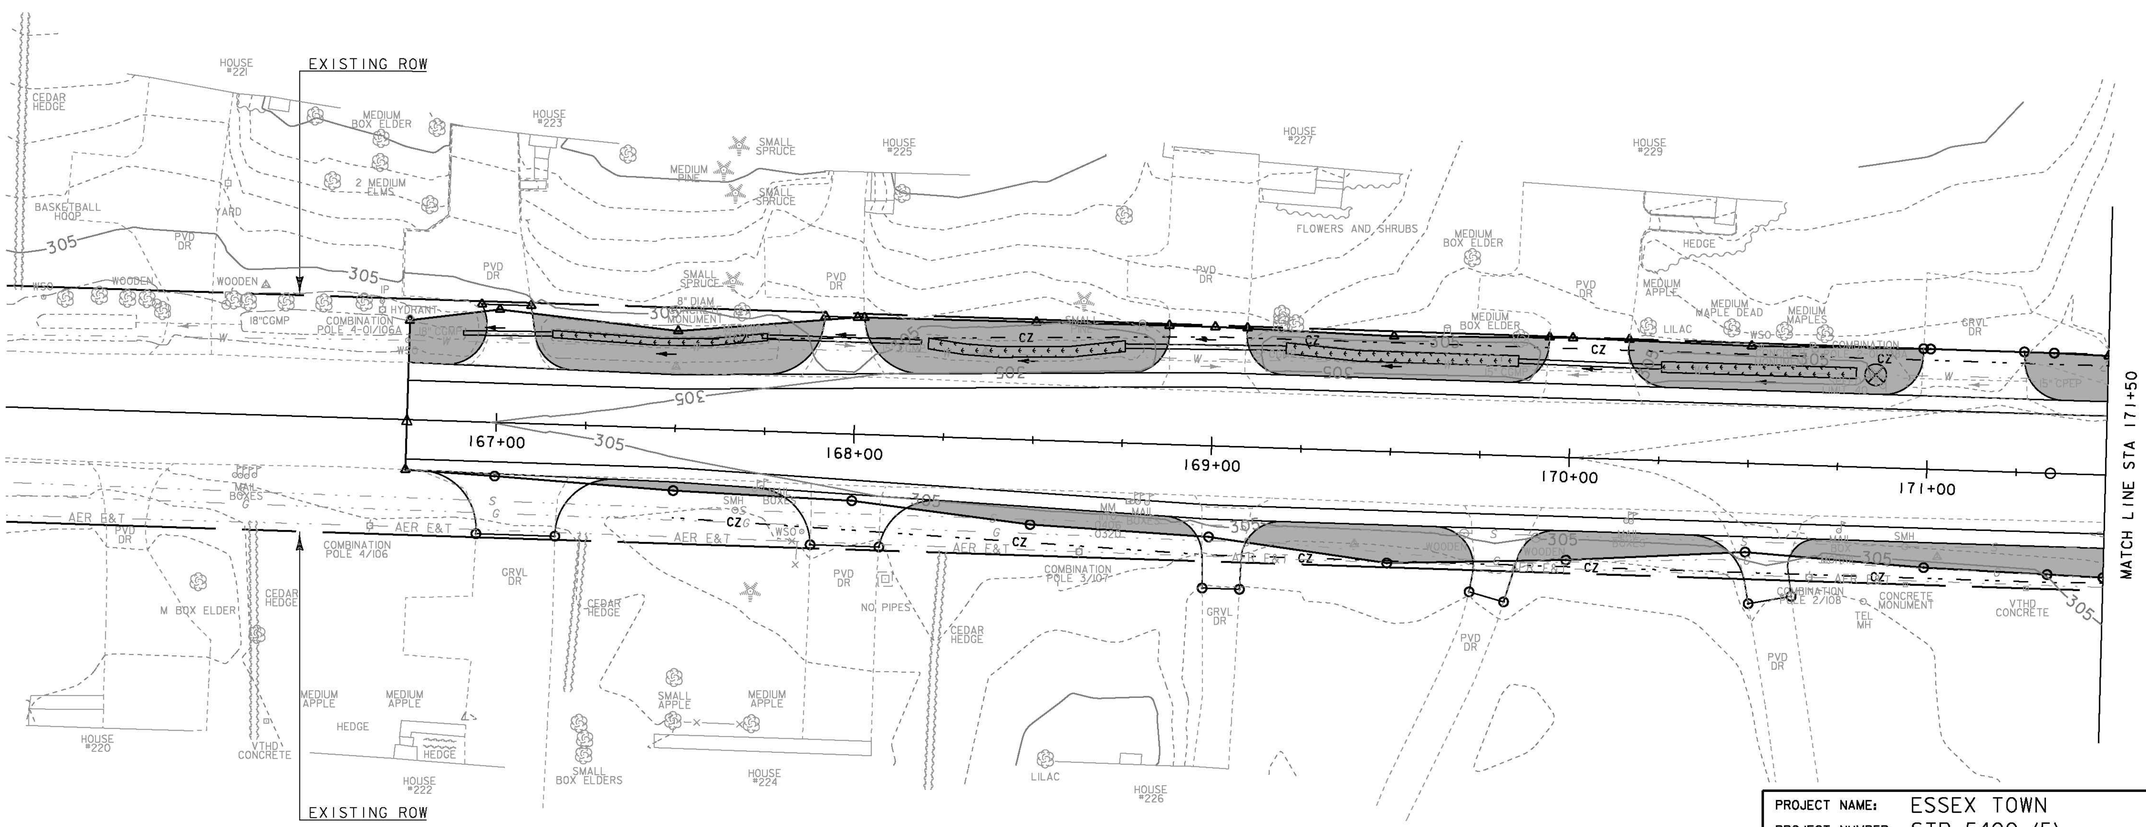

0 20 40

SCALE IN FEET

PROJECT NAME: ESSEX TOWN	
PROJECT NUMBER: STP 5400 (5)	
FILE NAME: t97d002ecfinalbdr.dgn	PLOT DATE: 24-AUG-2012
PROJECT LEADER: J. SCHULTZ	DRAWN BY: D. LYMAN
DESIGNED BY: D. LYMAN	CHECKED BY: J. DEVLIN
EPSC FINAL CONDITIONS SHEET 1	SHEET 32 OF 64