NOTE: FOR NEW SIGNS AND ALL CONSTRUCTION NOTES, SEE NEXT SHEET.

REMOVING SIGNS
AS SHOWN - 43

VAOT Metric

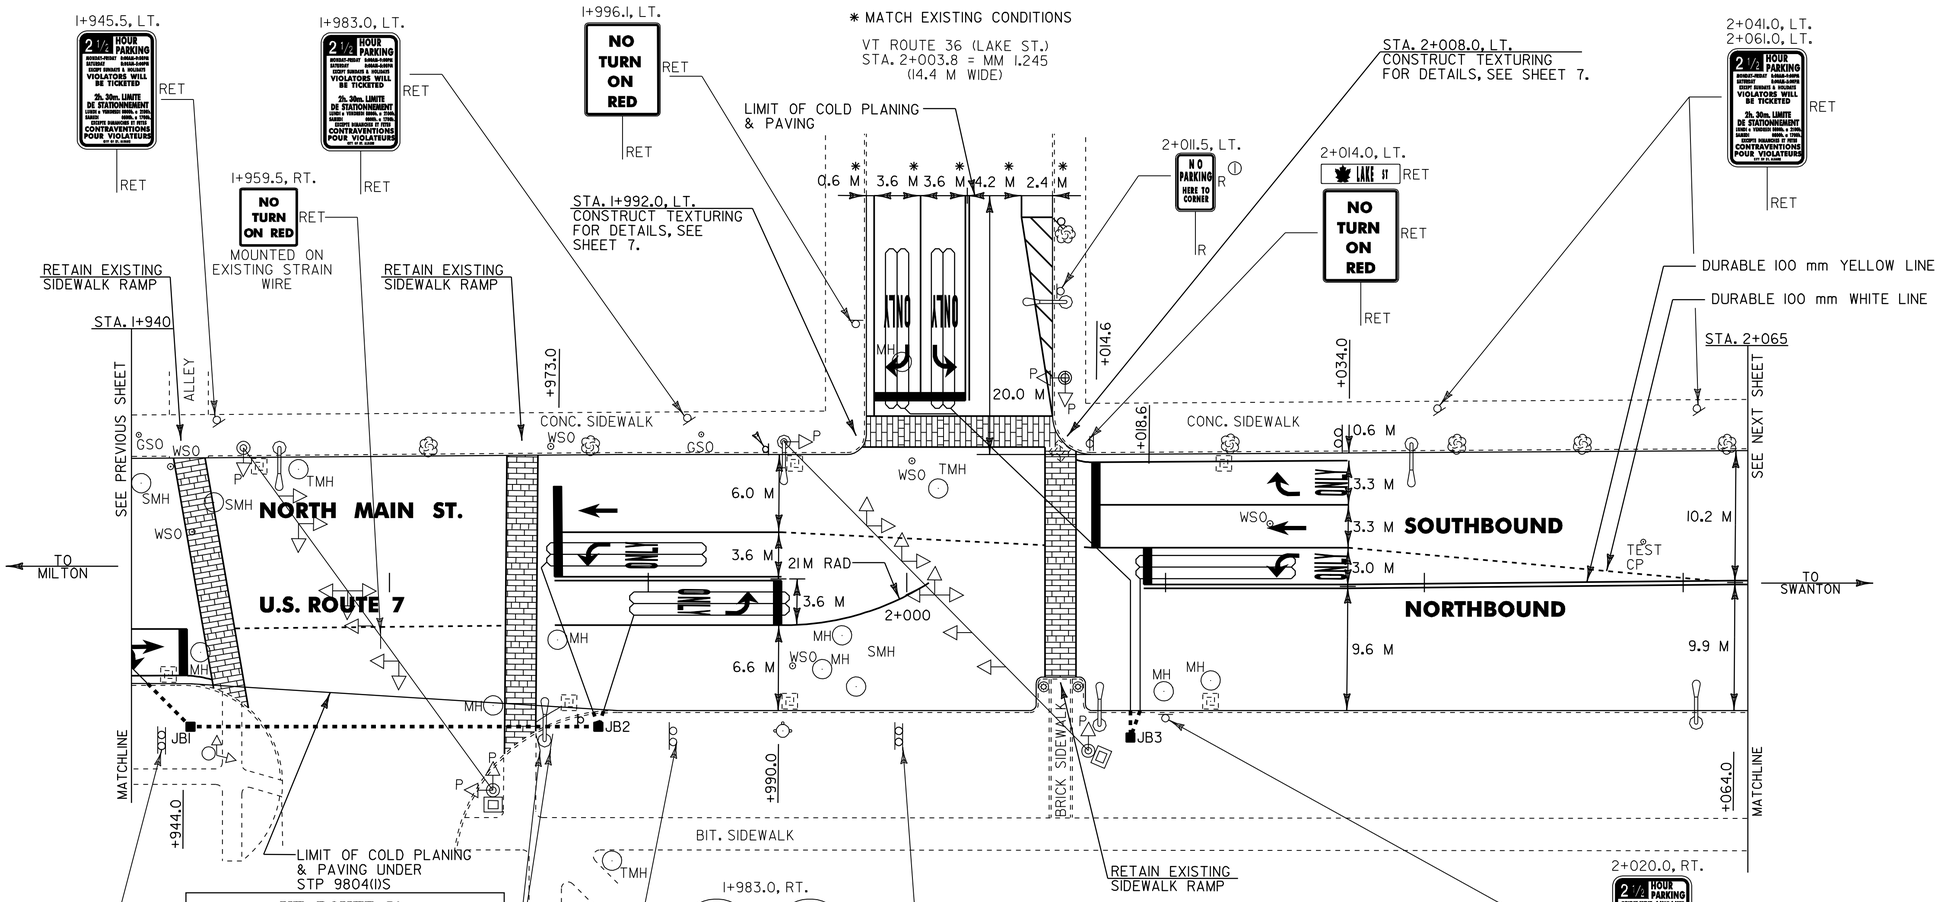

BUILT AS DESIGNED

NOTES:
1) ALL DIMENSIONS IN MILLIMETERS EXCEPT WHERE OTHERWISE INDICATED.
2) ALL EXISTING SIGNS NOT SHOWN SHALL BE RETAINED AS DIRECTED BY THE RESIDENT ENGINEER.
3) FOR ANY TOWN HIGHWAY OR STREET DETAILS, SEE VTrans STANDARD E-193M.
4) FOR VEHICLE DETECTOR LOOP DETAILS SEE SHEET 10.

Dufresne-Henry

PROJECT LAYOUT #14A EXISTING SIGNS

PROJECT NAME: ST. ALBANS CITY
PROJECT NUMBER: STP 9804(I)S

FILE NAME: /pave/97dl50/pdl50.dgn
PROJECT LEADER: JLL
DESIGNED BY: D-H
IPARM FILE NAME: pdl50pl4g.i
PLOT DATE: 01-FEB-2006 07:4
DRAWN BY: D-H
CHECKED BY:
SHEET 33 OF 105