~~TEMPORARY &~~ DURABLE 100 mm WHITE LINE
STA. 2+480.0 TO 2+600.0, SOLID LT. & RT. (WITH EDGELINE BREAKS FOR CROSSWALK & SHOPPING CENTER)
STA. 2+480.0 TO 2+494.0, SOLID RT. (LANE LINE) (WITH BREAK FOR CROSSWALK)
STA. 2+487.0 TO 2+494.0, SOLID RT. (LANE LINE)
STA. 2+499.0, SOLID RT. (SHOPPING CENTER EDGELINES & LANE LINE)
STA. 2+503.3 TO 2+538.0, SOLID LT. (LANE LINE)
STA. 2+538.0 TO 2+568.0, DOTTED LT.

TEMPORARY & DURABLE 100 mm YELLOW LINE
STA. 2+480.0 TO 2+538.0, SOLID LT. & RT. (WITH CENTERLINE BREAK FOR CROSSWALK & SHOPPING CENTER)
STA. 2+499.0, RT. (AROUND ISLAND & INCLUDING DOUBLE SOLID FOR GORE)
STA. 2+538.0 TO 2+600.0, DOUBLE SOLID LT. & RT.

TEMPORARY & DURABLE 200 mm YELLOW LINE
STA. 2+499.0, SOLID RT. (DIAGONAL)
STA. 2+538.0 TO 2+600.0, SOLID LT. & RT. (DIAGONALS)

~~TEMPORARY &~~ DURABLE CROSSWALK WITH DIAGONAL LINES (MOD.)
STA. 2+485.8

~~TEMPORARY &~~ DURABLE 600 mm STOP BAR (TYPE I TAPE)
~~STA. 2+483.1, RT.~~
STA. 2+499.0, RT. (SHOPPING CENTER)
~~STA. 2+516.0, LT.~~

DURABLE LETTER OR SYMBOL (TYPE I TAPE)
~~STA. 2+499.0, RT. - "ONLY" (2) (SHOPPING CENTER)~~
STA. 2+499.0, RT. - " ↰ "&" ↱ " (SHOPPING CENTER)
STA. 2+~~533.2, LT.~~ - " ↰ " 545.0, RT.
STA. 2+~~536.5, LT.~~ - " → " 549.0, CL
STA. 2+~~536.8,~~ RT. - "ONLY" 549.0, RT.

TEMPORARY LETTER OR SYMBOL
STA. 2+499.0, RT. - " ↰ "&" ↱ " (SHOPPING CENTER)
~~STA. 2+533.2, LT. - " ↰ "~~
~~STA. 2+536.5, LT. - " → "~~

REMOVING SIGNS
AS SHOWN - 7

ERECTING SALVAGED SIGNS
AS SHOWN - 1

CHANGING ELEVATION OF SMH'S
STA. 2+482.0, RT.

ADJUST ELEVATION OF VALVE BOX
STA. 2+534.0, RT. - WSO

REHABILITATION OF DI'S, CB'S OR MH'S - CLASS I
STA. 2+482.0, LT. - DI
STA. 2+483.0, RT. - DI
STA. 2+487.0, LT. - DI
STA. 2+577.0, LT. - DI
STA. 2+591.0, RT. - DI

PAINTED ISLAND
STA. 2+499.0, RT. (SHOPPING CENTER ISLAND)

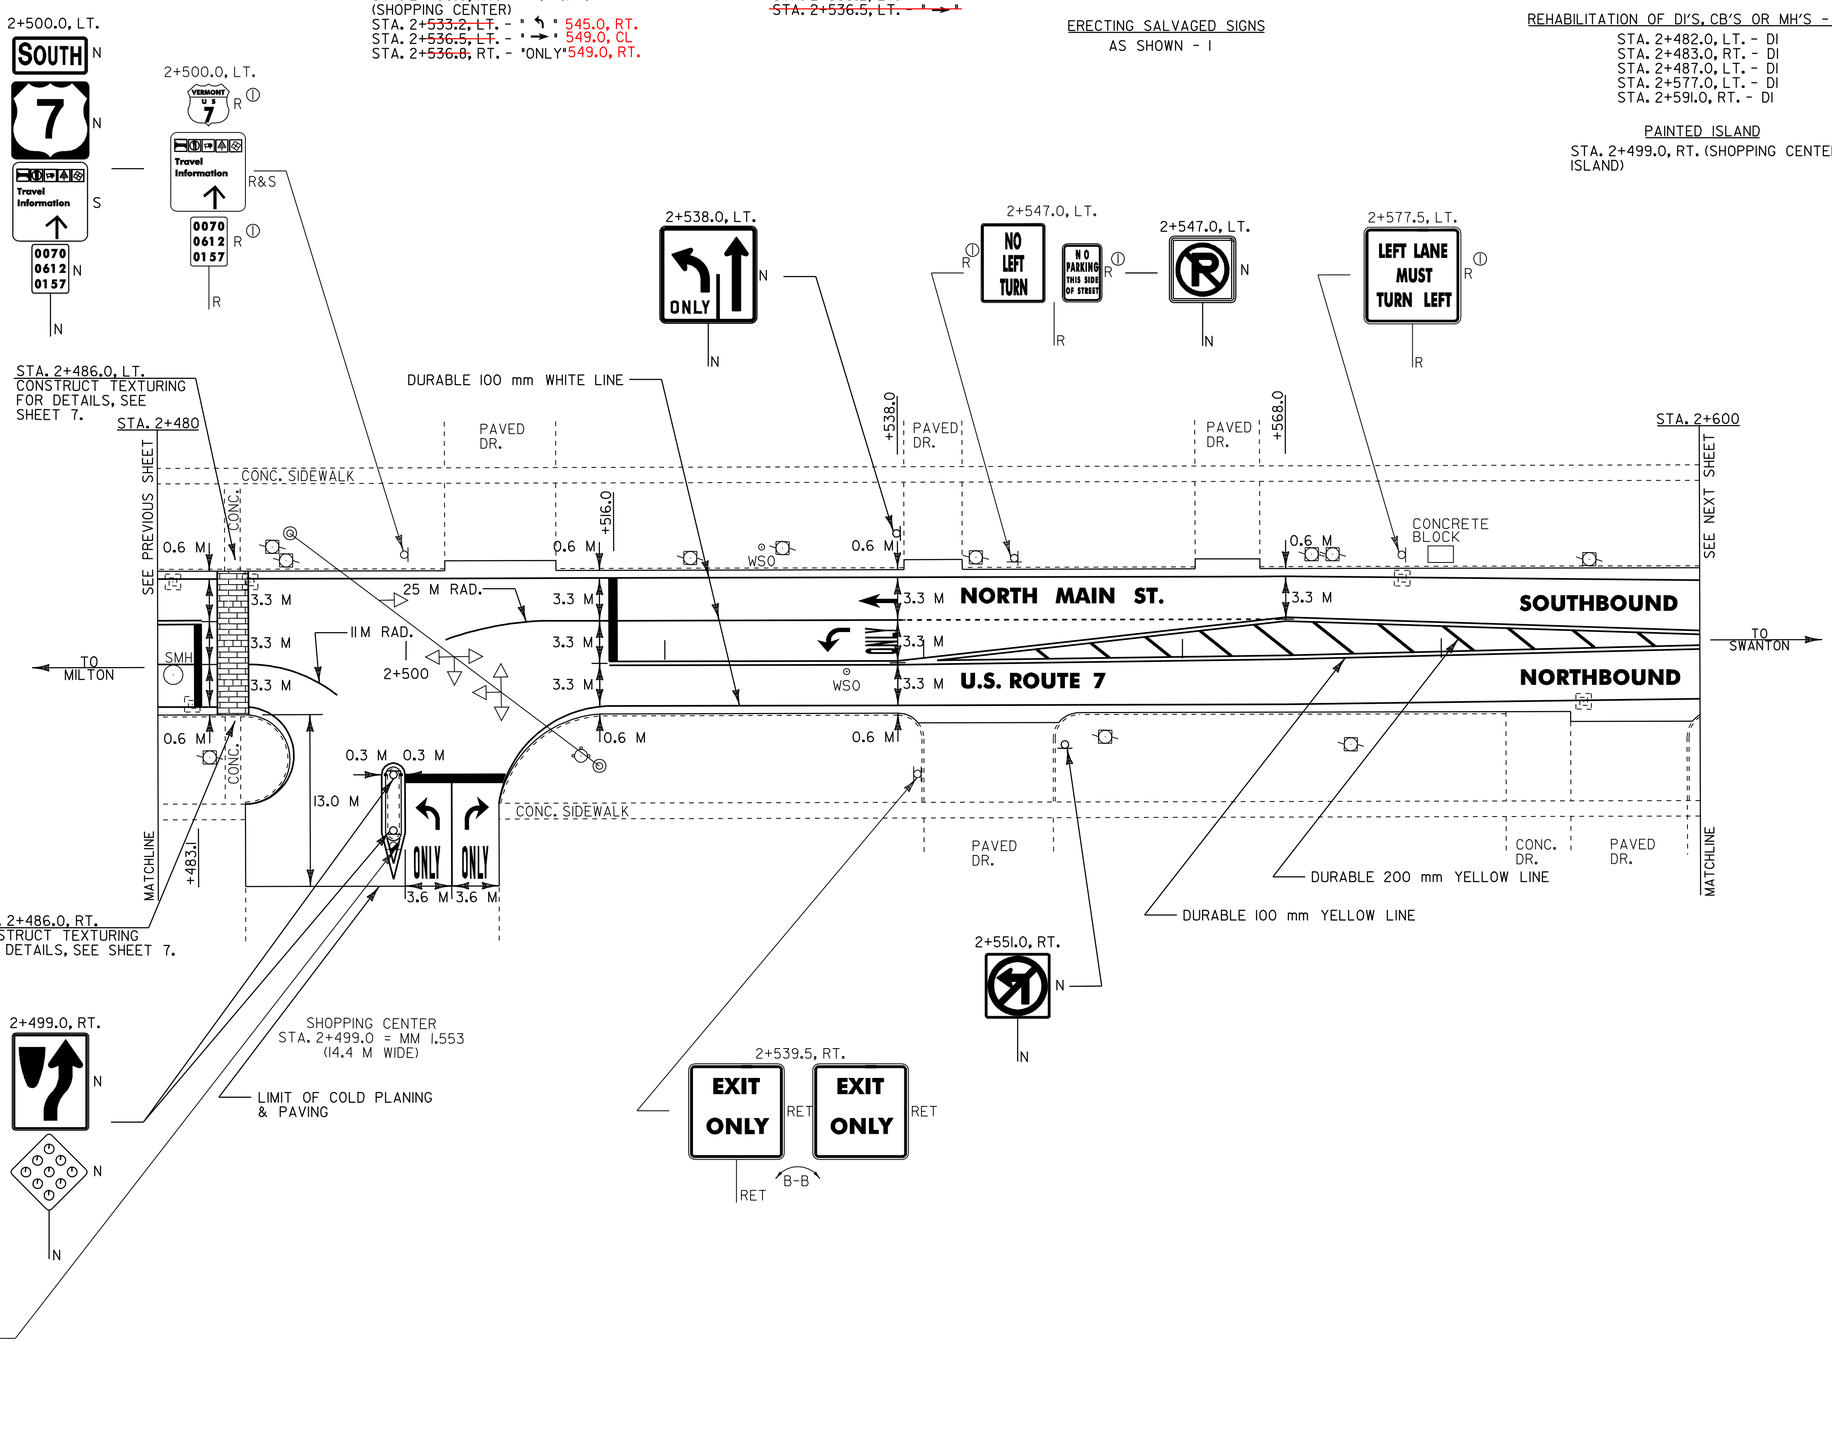

NOTES:
1) ALL DIMENSIONS IN MILLIMETERS EXCEPT WHERE OTHERWISE INDICATED.
2) ALL EXISTING SIGNS NOT SHOWN SHALL BE RETAINED AS DIRECTED BY THE RESIDENT ENGINEER.
3) FOR ANY TOWN HIGHWAY OR STREET DETAILS, SEE VTrans STANDARD E-193M.

LAYOUT SHEET #18

PROJECT NAME: ST. ALBANS CITY
PROJECT NUMBER: STP 9804(I)S
FILE NAME: /pave/97d150/pd150.dgn
PROJECT LEADER: JLL
DESIGNED BY: D-H
IPARM FILE NAME: pd150pl8.i
PLOT DATE: 01-FEB-2006 07:4
DRAWN BY: D-H
CHECKED BY:
SHEET 39 OF 105