STATE OF VERMONT
AGENCY OF TRANSPORTATION

TRAFFIC SIGN SUMMARY SHEET

VAOT Metric

KILOMETER MARKER, STATION, OR SIGN NUMBER	SIGN LEGEND	SIGN DIMENSIONS EA	WIDTH (mm)	HEIGHT (mm)	NEW & SALVAGED SIGNS "A"	"B"	SALV SIGN	SALV TIS	EXIST POST RETAIN	EXIST POST SALVAGE	NO. OF POSTS	NEW SIGN POSTS: FLANGED CHANNEL kg/m 1.7	3.0	4.5	SQUARE STEEL (mm) kg/m 44 3.4	50 3.9	63 5.0	ANCHOR	SLEEVE	TUBULAR ALUMINUM Ø (mm) kg/m 75 1.9	100 2.5	100 MOD 2.5	TUBULAR STEEL Ø (mm) FOUNDATION	kg/m 75 11.3	89 13.4	100 16.1	125 21.7	W-SHAPE STEEL FTG. SIZE 600 mm	750 mm	WEIGHT	POST SIZE	SIGN FRAME REQUIRED	REMARKS	SIGN DETAIL: DETAIL ON SHEET NUMBER	STD. SHEET NUMBER
												OPTION ITEMS																								
U.S. ROUTE 7							2																											- -	- -
0+894.5, LT							2				1			X		3.78 X 3.78																X		- -	- -
							1																											-	-
	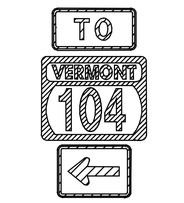	1	600	300	0.18																														E-136BM
0+928.5, LT		1	750	600	0.45						1			X		3.48 X																			E-136BM
		1	525	375	0.20																														E-136BM
0+962.0, RT		1	750	750	0.56						1			X		2.99 X																			E-145AM
0+970.0, LT		1	750	750	0.56						1			X		3.08 X																			E-145AM
0+978.0, LT							2				1			X		2.74 X																		SALVAGED STREET SIGNS TO BE INSTALLED 90° TO EACH OTHER MOUNTED 150 mm ABOVE THE NEW STOP SIGN USING A POST TOP MOUNTING BRACKET, MOUNTED ON A NEW POST.	-	-
		1	750	750	0.56																														E-143M
1+010.5, LT		1	600	300	0.18																														E-135M
		1	600	600	0.36						1			X		3.44 X																			E-135M
		1	525	375	0.20																														E-135M
1+021.0, LT							1				1			X		3.11 X																			-	-
							1																												-	-
		m² 3.25	m²	m²	EA. 9	m²					m ~~32.2~~		32.2		m 32.2	m ~~32.2~~ 26.40		EA	kg	kg	kg	EA.	kg	kg	kg	kg	EA.	EA.	kg					

FINAL POST LENGTHS ARE TO BE DETERMINED IN THE FIELD. POST SIZES ARE COMPUTED BASED ON INFORMATION FURNISHED ON THE STANDARD SHEETS AND THE TRAFFIC & SAFETY DIVISION'S "SIGN POST DESIGN GUIDELINE."

PROJECT NAME: ST. ALBANS CITY
PROJECT NUMBER: STP 9804(I)S

FILE NAME: /pave/97dl50/pdl50.dgn
PROJECT LEADER: JLL
DESIGNED BY: D-H
IPARM FILE NAME: pdl50t03.i
PLOT DATE: 01-FEB-2006 07:5
DRAWN BY: D-H
CHECKED BY:
SHEET 50 OF 105