STATE OF VERMONT
AGENCY OF TRANSPORTATION

TRAFFIC SIGN SUMMARY SHEET

VAOT Metric

KILOMETER MARKER, STATION, OR SIGN NUMBER	SIGN LEGEND	SIGN DIMENSIONS EA	WIDTH (mm)	HEIGHT (mm)	NEW & SALVAGED SIGNS "A"	"B"	SALV SIGN	SALV TIS	EXIST POST RETAIN	EXIST POST SALVAGE	NO. OF POSTS	NEW SIGN POSTS: FLANGED CHANNEL kg/m 1.7	3.0	4.5	SQUARE STEEL (mm) kg/m 44 3.4	50 3.9	63 5.0	ANCHOR	SLEEVE	TUBULAR ALUMINUM Ø (mm) kg/m 75 1.9	100 2.5	100 MOD 2.5	TUBULAR STEEL Ø (mm) FOUNDATION	kg/m 75 11.3	89 13.4	100 16.1	125 21.7	W-SHAPE STEEL FTG. SIZE 600 mm	750 mm	WEIGHT	POST SIZE	SIGN FRAME REQUIRED	REMARKS	SIGN DETAIL: DETAIL ON SHEET NUMBER	STD. SHEET NUMBER
												OPTION ITEMS						* ANCHOR = 1 METER																			
VT ROUTE 36																																			
1+663.0, LT.		1	750	750	0.56						1			X		3.3 X		1.0																	E-152M
		1	600	300	0.18																													88	
1+667.0, RT.	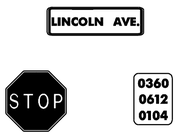						1				1			X		2.9 X		1.0																NEW STOP SIGN AND MILEMARKER MOUNTED BACK TO BACK. SALVAGED STREET SIGN INSTALLED 150 mm ABOVE THE 'STOP' SIGN USING POST TOP MOUNTING BRACKET ON NEW POST.		-
		1	750	750	0.56																													E-143M
		1	150	200	0.03																													E-138M
1+668.0, RT.		1	750	750	0.56						1			X		3.0 X		1.0																	E-152M
		1	600	300	0.18																													88	
1+674.7, LT.		1	300	450	0.14						1			X		2.6 X		1.0																	88	
1+685.7, RT.		1	300	450	0.14						1			X		2.7 X		1.0																	88	
1+726.0, LT.	SPEED LIMIT 25	1	600	750	0.45						1			X		3.0 X		1.0																	E-142	
1+783.0, LT.	HIGH ST.						1				1			X		2.8 X		1.0																NEW STOP SIGN AND MILEMARKER MOUNTED BACK TO BACK. SALVAGED STREET SIGN INSTALLED 150 mm ABOVE THE 'STOP' SIGN USING POST TOP MOUNTING BRACKET ON NEW POST.		-
	STOP 0360 0612 0111	1	750	750	0.56																													E-143M
		1	150	200	0.03																													E-138M
1+805.9, RT.		1	300	450	0.14						1			X		2.7 X		1.0																	88	
1+837.9, LT.	SPEED LIMIT 25	1	600	750	0.45						1			X		3.3 X		1.0																	E-142M	
		1	300	450	0.14																													88	
1+909.7, RT.		1	300	450	0.14						1			X		2.5 X		1.0																	88	
TOTALS			m^2 4.26	m^2	EA. 2	m^2						m ~~46.0~~	m	m 46.0	m	m ~~46.0~~ 28.8	m	10.0	EA	kg	kg	kg	EA.	kg	kg	kg	kg	EA.	EA.	kg					

FINAL POST LENGTHS ARE TO BE DETERMINED IN THE FIELD. POST SIZES ARE COMPUTED BASED ON INFORMATION FURNISHED ON THE STANDARD SHEETS AND THE TRAFFIC & SAFETY DIVISION'S "SIGN POST DESIGN GUIDELINE."

PROJECT: ST. ALBANS CITY	PROJECT NO.: STP 2129(I)S
DESIGN FILE NAME: /pave/99d070/pd070.dgn	
IPARM FILE NAME: pd070t03.i	PLOT DATE: 01-FEB-2006 0
SURVEYED BY: D-H	SURVEY DATE: 09/98
DESIGNED BY: D-H	DRAWN BY: D-H
	SHEET: 85 OF 105