STATE OF VERMONT
AGENCY OF TRANSPORTATION

TRAFFIC SIGN SUMMARY SHEET

VAOT Metric

KILOMETER MARKER, STATION, OR SIGN NUMBER	SIGN LEGEND	SIGN DIMENSIONS EA	WIDTH (in)	HEIGHT (in)	NEW & SALVAGED SIGNS "A"	"B"	SALV SIGN	SALV TIS	EXIST POST RETAIN	EXIST POST SALVAGE	NEW SIGN POSTS NO. OF POSTS	FLANGED CHANNEL kg/m 1.7	3.0	4.5	SQUARE STEEL (mm) 44 kg/m 3.4	50 kg/m 3.9	63 kg/m 5.0	ANCHOR	SLEEVE	TUBULAR ALUMINUM Ø (mm) 75 kg/m 1.9	100 kg/m 2.5	100 MOD kg/m 2.5	TUBULAR STEEL Ø (mm) FOUNDATION	75 kg/m 11.3	89 kg/m 13.4	100 kg/m 16.1	125 kg/m 21.7	W-SHAPE STEEL FTG. SIZE 24"	30"	WEIGHT	POST SIZE	SIGN FRAME REQUIRED	REMARKS	SIGN DETAIL DETAIL ON SHEET NUMBER	STD. SHEET NUMBER
											OPTION ITEMS																									
STA 4+916.00 LT		1 1	36 18	36 18	9.00 2.25						2	275"				X		X															W3-3 W13-1		E-152 E-155
STA 4+974.00 LT		1	24	30	5.00						1	158"				X		X															R2-1		E-142
STA 5+100.00 LT APPROX.		1 1	21 24	15 24	2.19 4.00						1	183"				X		X															M2-1 M1-4		E-136B E-136B
STA 40+011.00 LT		1 1 1	 6	 8	 0.33		1 1			1																							A POST-TOP MOUNTING BRACKET WILL BE REQUIRED. MOUNT 0.3M ABOVE AND PERPENDICULAR TO STOP SIGN. R1-1		E-123 E-143 E-138
STA 40+020.00 RT		1					1			1																							VR-017		E-141
STA 40+045.00 RT		1	24	30	5.00						1	160"				X		X															R2-1		E-142
STA 14+070.00 LT		1	30	36	7.50						1	177"				X		X															VR-925		E-145A
STA 14+070.00 RT		1					1				2	377"				X		X															W11-8		
STA 14+100.00 LT.	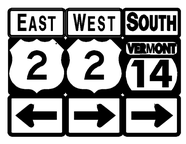	3 3 3	 21	 15	 6.57		3 3			2																							*2	M3-4 M1-4 M6-3		E-136A E-136B
STA 14+110.00 RT		1	30	30	6.25						1	159"				X		X															VR-921		E-145A
STA 14+130.00 LT.	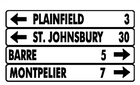	2 2	 72	 10	 10.0		2			2																										E-123
STA 5+060 RT							2			1																								INSTALLED AT 4+830 RT AS NEW THEN REMOVED AND SALVAGED		
												m	m	m	m	m 41.2	m		EA	kg	kg	kg		kg	kg	kg	kg								
TOTALS		m2 ~~5.40~~ 58.09		m2	EA. ~~12~~ 15	m2						m			m 41.2					kg			EA.	kg				EA.	EA.	kg					

FINAL POST LENGTHS ARE TO BE DETERMINED IN THE FIELD. POST SIZES ARE COMPUTED BASED ON INFORMATION FURNISHED ON THE STANDARD SHEETS AND THE VTRANS "SIGN POST DESIGN GUIDELINE."

PROJECT NAME: EAST MONTPELIER
PROJECT NUMBER: STPG 028 - 3(35)S

FILE NAME: t98b028tsss.dgn
PROJECT LEADER: J. SCHULTZ
DESIGNED BY: J. GRUCHACZ
TRAFFIC SIGN SUMMARY SHEET 2

PLOT DATE: 22-MAR-2010
DRAWN BY: D. LYMAN
CHECKED BY: J. DEVLIN
SHEET 84 OF 142