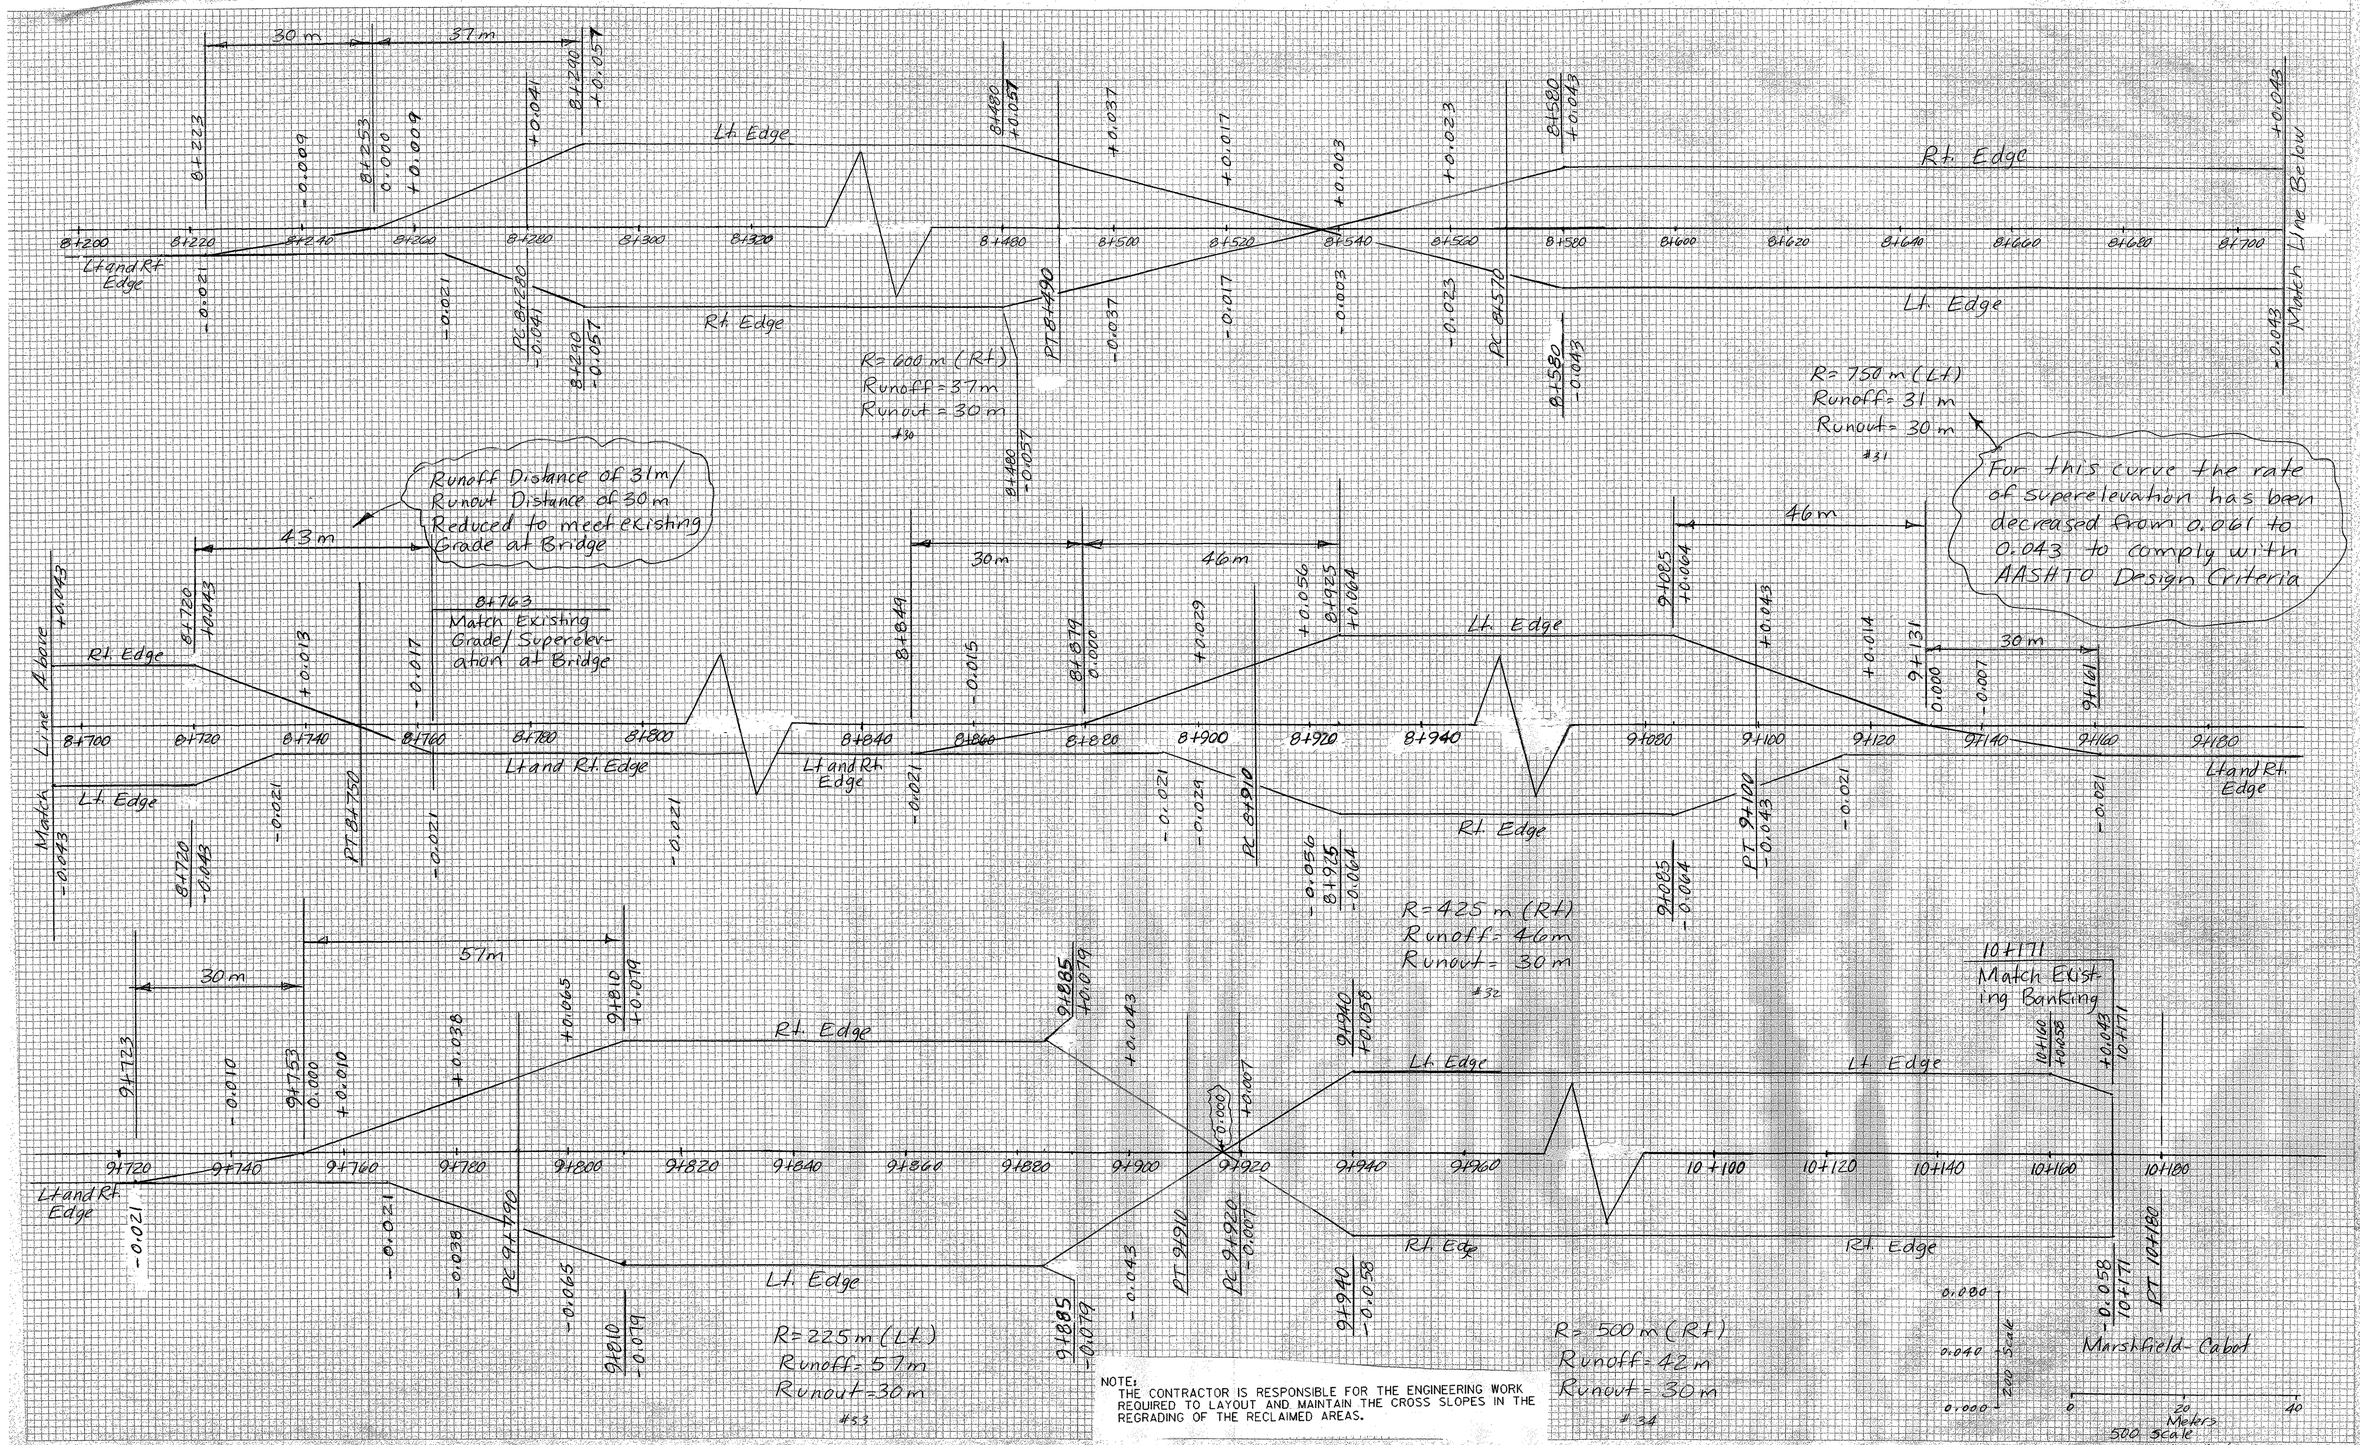

NOTE:
THE CONTRACTOR IS RESPONSIBLE FOR THE ENGINEERING WORK REQUIRED TO LAYOUT AND MAINTAIN THE CROSS SLOPES IN THE REGRADING OF THE RECLAIMED AREAS.

K&E STANDARD ® CROSS SECTION 10X10 TO THE INCH
KEUFFEL & ESSER CO. MADE IN U.S.A.
K&E STANDARD ® CROSS SECTION 10X10 TO THE INCH
KEUFFEL & ESSER CO. MADE IN U.S.A.