TEMPORARY AND DURABLE 100mm YELLOW LINE

STA. 2+890.0 TO STA. 2+984.0 DOUBLE SOLID LT. AND RT.
STA. 3+006.0 TO STA. 3+060.0 DOUBLE SOLID LT. AND RT.
STA. 10+120.0 TO STA. 10+213.0 SOLID LT. AND RT.
(WITH CENTERLINE BREAK FOR SIDE ROAD)

TEMPORARY AND DURABLE 100mm WHITE LINE

STA. 2+890.0 TO STA. 3+060.0 SOLID RT. (EDGELINE)
STA. 2+890.0 LT. TO STA. 3+060.0 LT. DASHED (PASSING LANE)
STA. 2+890.0 RT. TO STA. 3+060.0 RT. DASHED (PASSING LANE)
STA. 2+890.0 LT. TO STA. 10+204.0 RT. SOLID (EDGELINE)
STA. 2+920.0 RT. TO STA. 2+998.0 RT. SOLID (LEFT TURN LANE)
STA. 3+009.0 LT. TO STA. 3+060.0 LT. SOLID (RIGHT TURN LANE)
STA. 10+120.0 RT. TO STA. 10+192.0 RT. SOLID (EDGELINE)
STA. 10+120.0 LT. TO STA. 3+060.0 LT. SOLID (EDGELINE)

DURABLE 200mm YELLOW LINE

STA. 2+890.0 TO STA. 2+990.0 SOLID (CHANNELIZING LINES)
STA. 3+006.0 TO STA. 3+060.0 SOLID (CHANNELIZING LINES)

REHABILITATION OF DI, CB, OR MH, CLASS I

STA. 3+035 RT.

TEMPORARY AND DURABLE 600mm STOP BAR

STA. 10+213.0 RT. (VT RTE 346)

DURABLE LETTER OR SYMBOL

STA. 2+939 RT. - "ONLY"
STA. 2+943 RT. -
STA. 2+962 RT. - "ONLY"
STA. 2+966 RT. -
STA. 2+984 RT. - "ONLY"
STA. 2+988 RT. -
STA. 10+213 RT. - "STOP" (VT. RTE 346)
STA. 3+018 LT. -
STA. 3+022 LT. - "ONLY"
STA. 3+050 LT. -
STA. 3+054 LT. - "ONLY"

TEMPORARY LETTER OR SYMBOL

STA. 2+943 RT. -
STA. 2+988 RT. -
STA. 10+213 RT. - "STOP" (VT. RTE 346)
STA. 3+018 LT. -
STA. 3+050 LT. -

REMOVING SIGNS

53 -- AS SHOWN

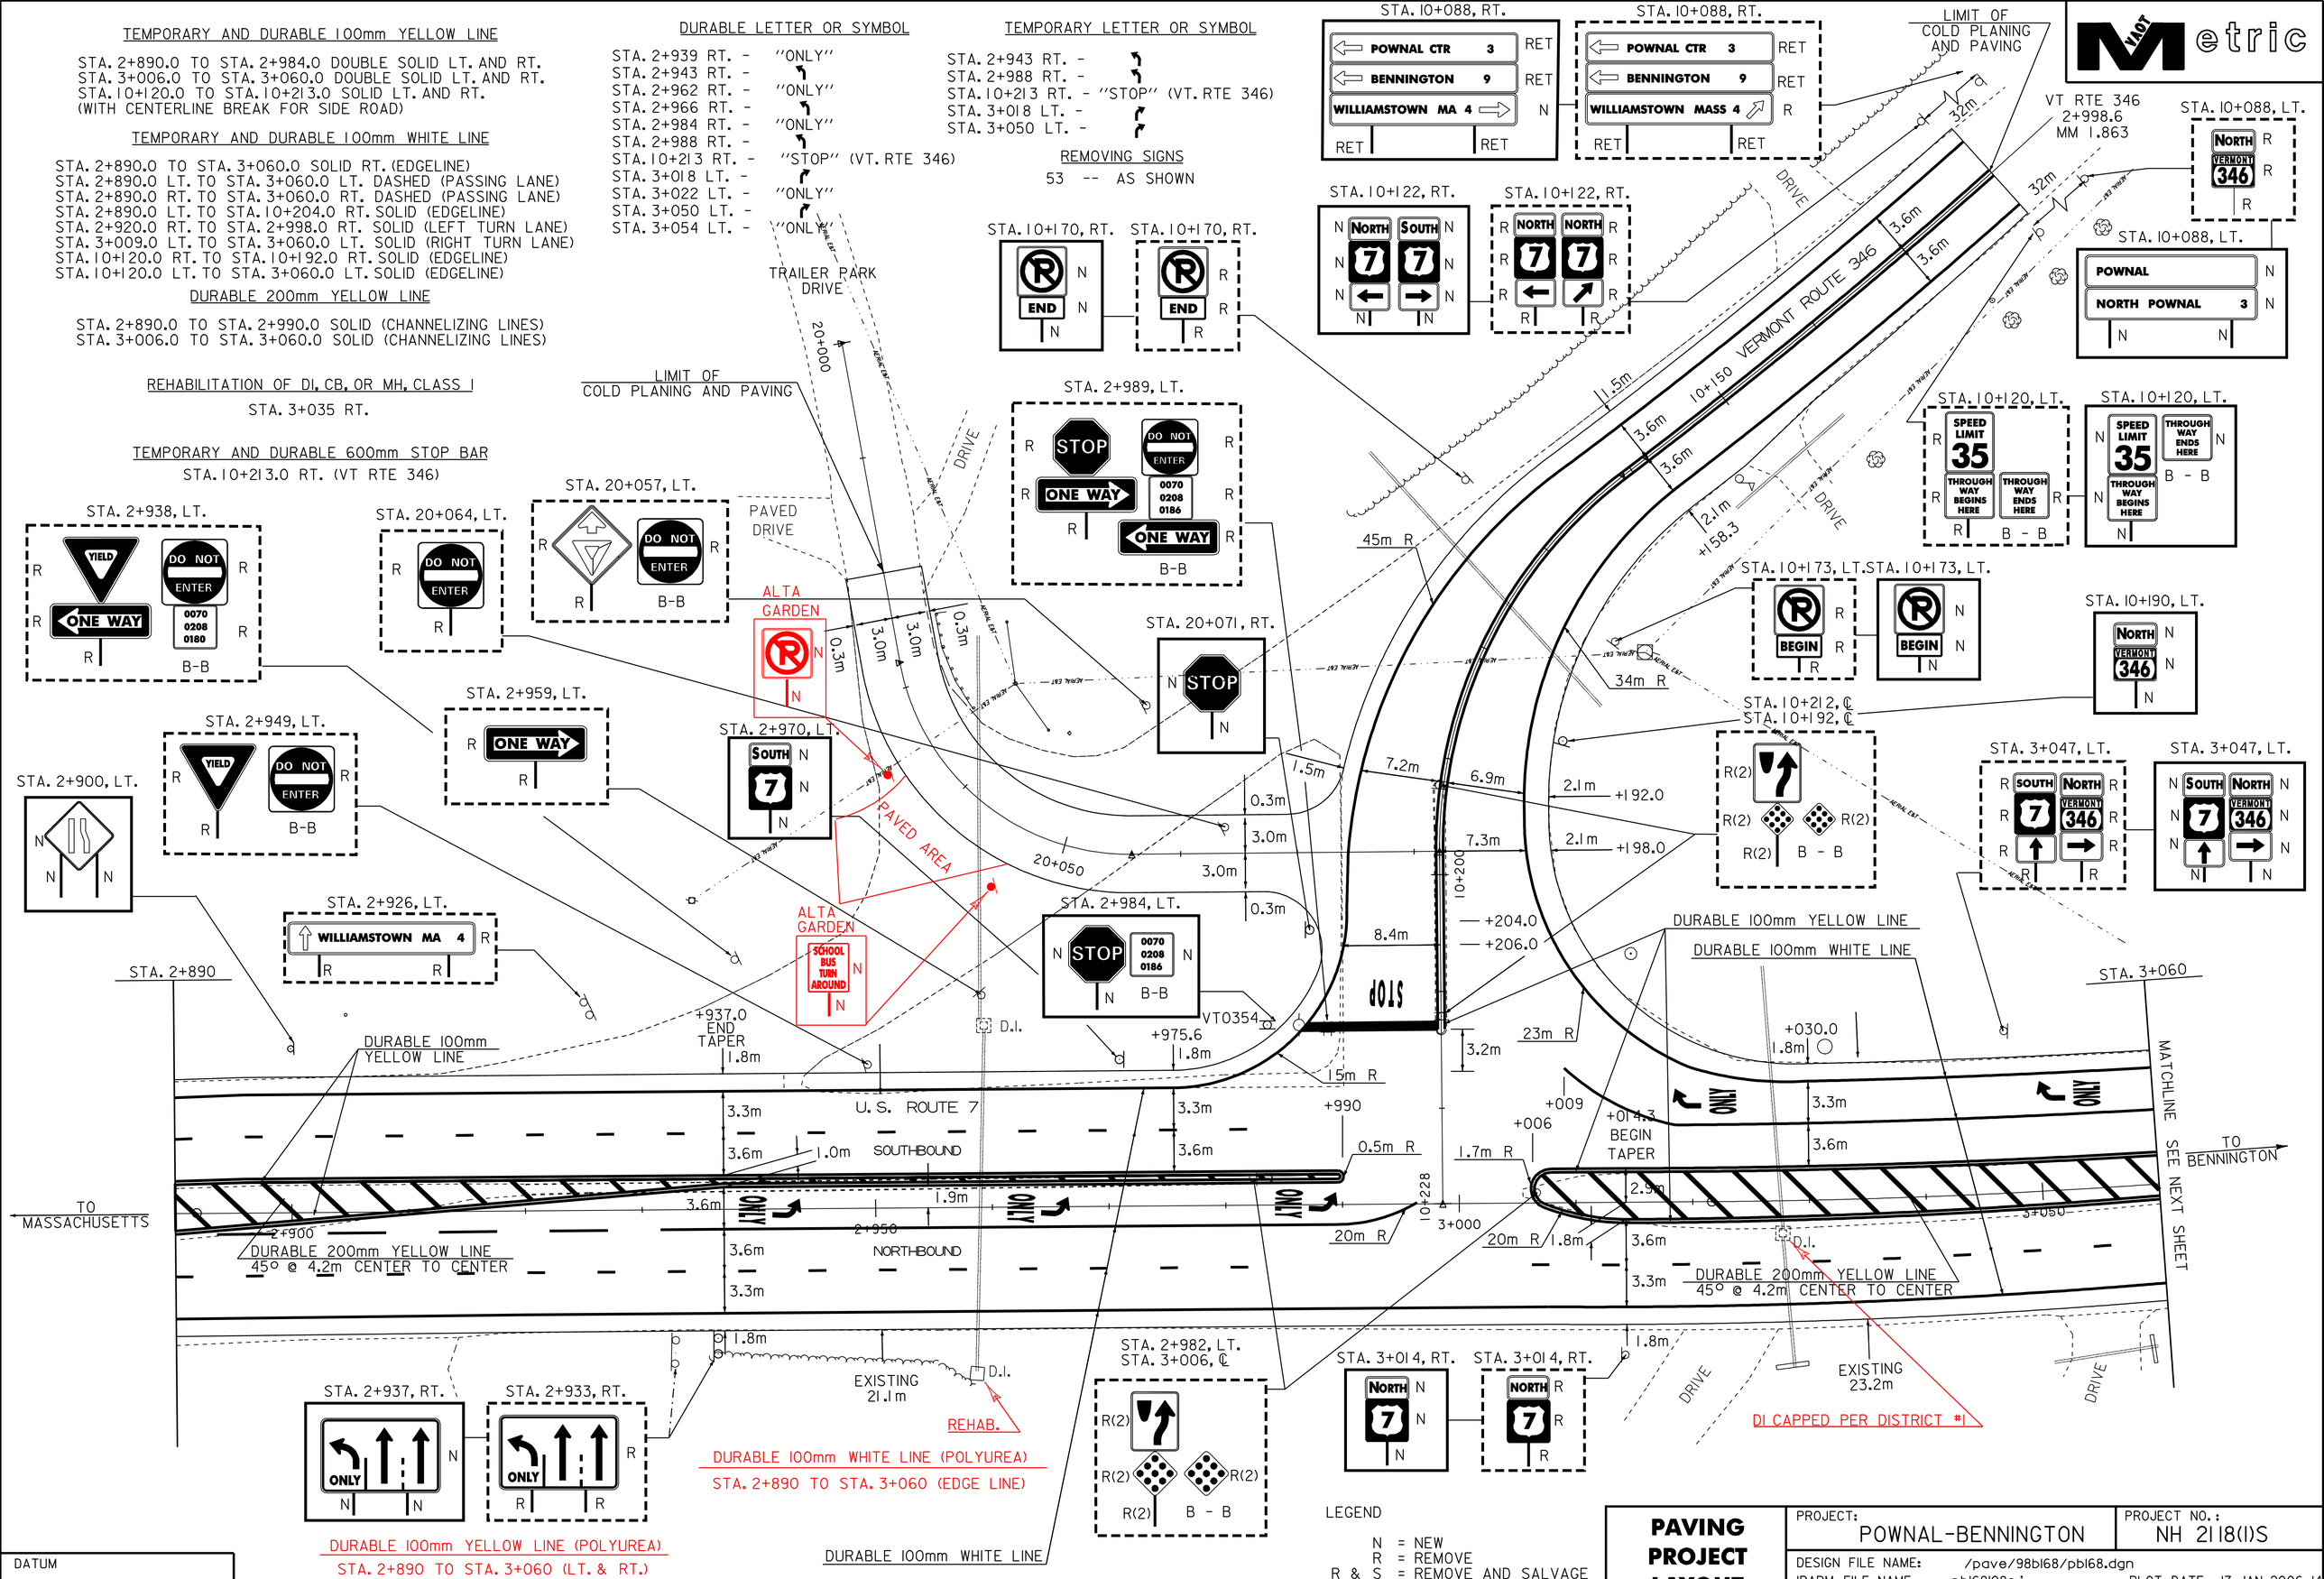

SEE INTERSECTION DETAIL ON SHEET 43

LEGEND

N = NEW
R = REMOVE
R & S = REMOVE AND SALVAGE
S = SALVAGE SIGN
RET = RETAIN
B - B = BACK TO BACK

DATUM

VERTICAL N/A
HORIZONTAL N/A

PAVING PROJECT LAYOUT #8

PROJECT: POWNAL-BENNINGTON
PROJECT NO.: NH 2118(1)S

DESIGN FILE NAME: /pave/98b168/pb168.dgn
IPARM FILE NAME: pb168108s.1
SURVEYED BY: ACT, SJL, RAL
SQUAD LEADER: JAV
PLOT DATE: 17-JAN-2006 14
SURVEY DATE:
DRAWN BY: ACT
SHEET: 16 OF 65