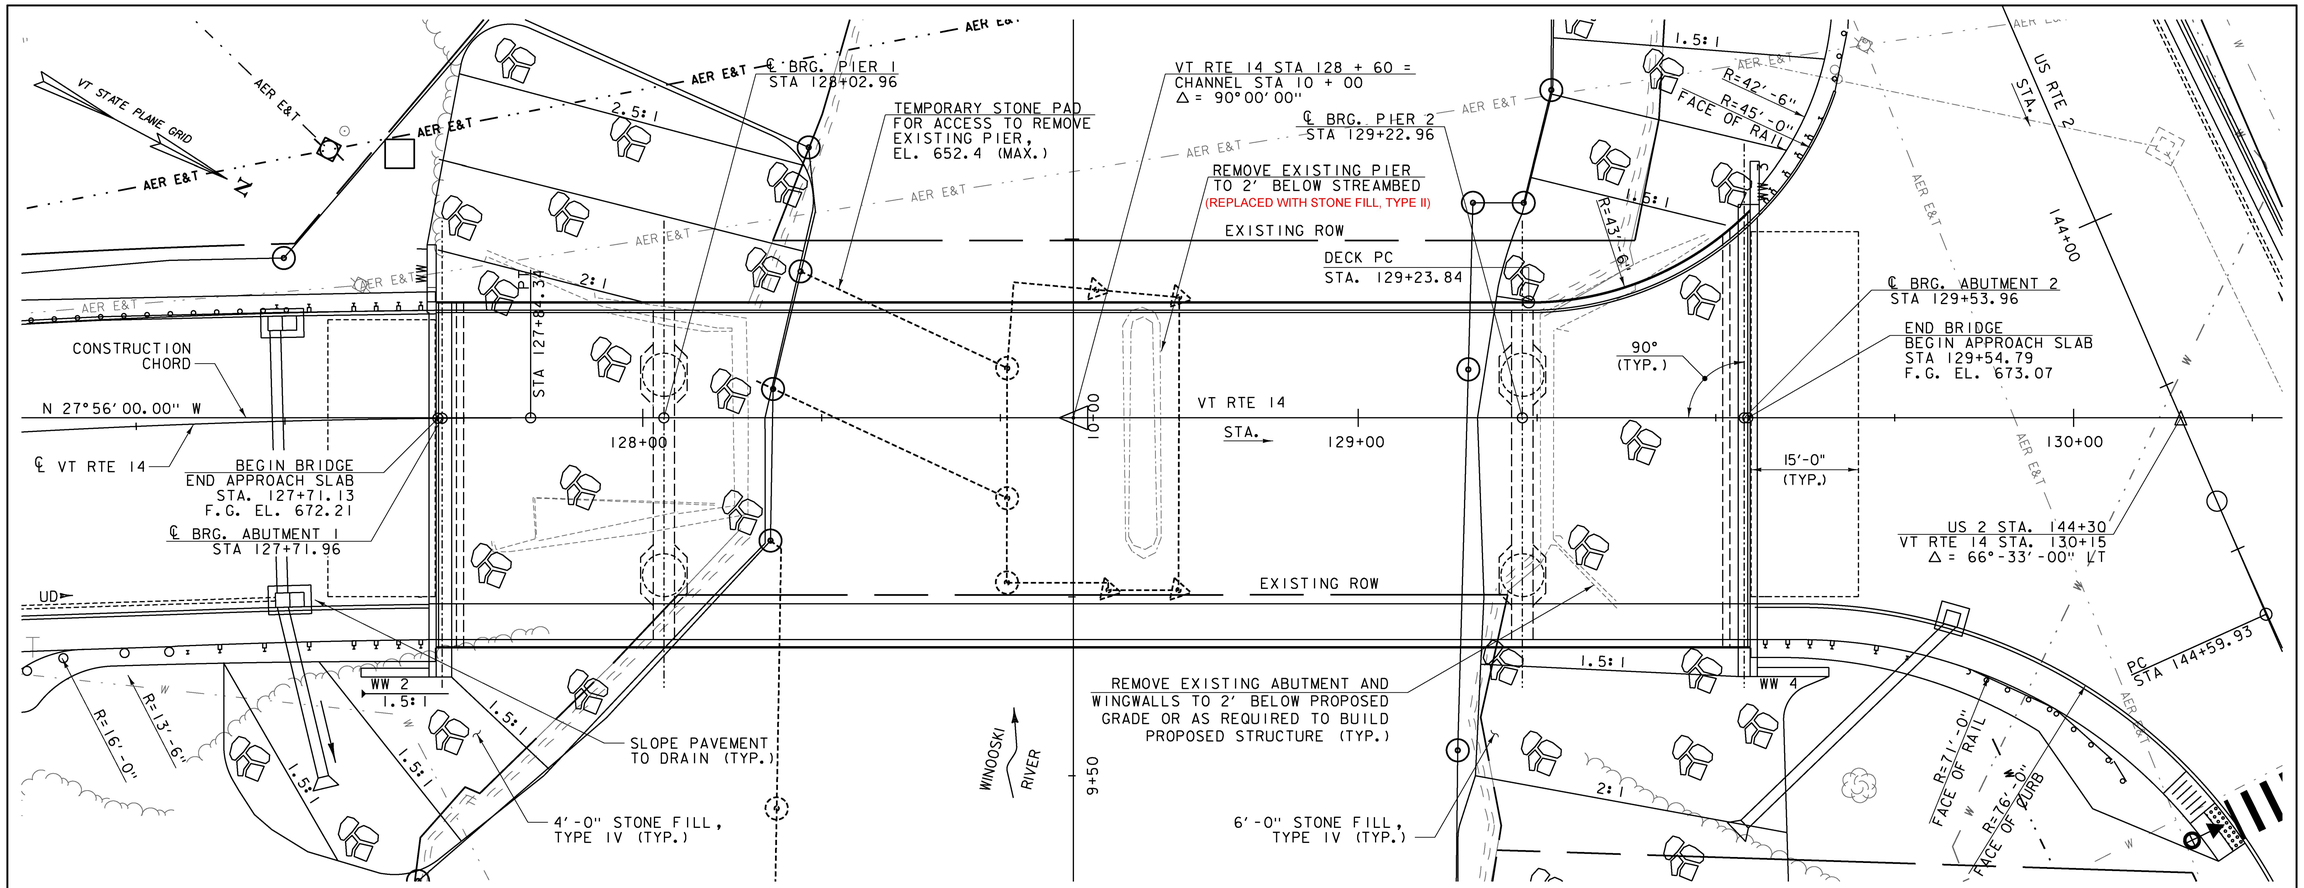

PLAN

SCALE: 1″ = 10′-0″

0 10 20

* PAY LIMIT FOR SPECIAL PROVISION
(GUARDRAIL APPROACH SECTION TO CONCRETE
BRIDGE RAILING) (TL2)
UPSTREAM PAY LIMIT = 36′-6″
DOWNSTREAM PAY LIMIT = ~~17′-9″~~ 24′0″

** PAY LIMIT FOR SPECIAL PROVISION
(GUARDRAIL APPROACH SECTION TO CONCRETE
BRIDGE RAILING) (TL2)
UPSTREAM PAY LIMIT = 30′-3″
DOWNSTREAM PAY LIMIT = ~~17′-9″~~ 24′0″

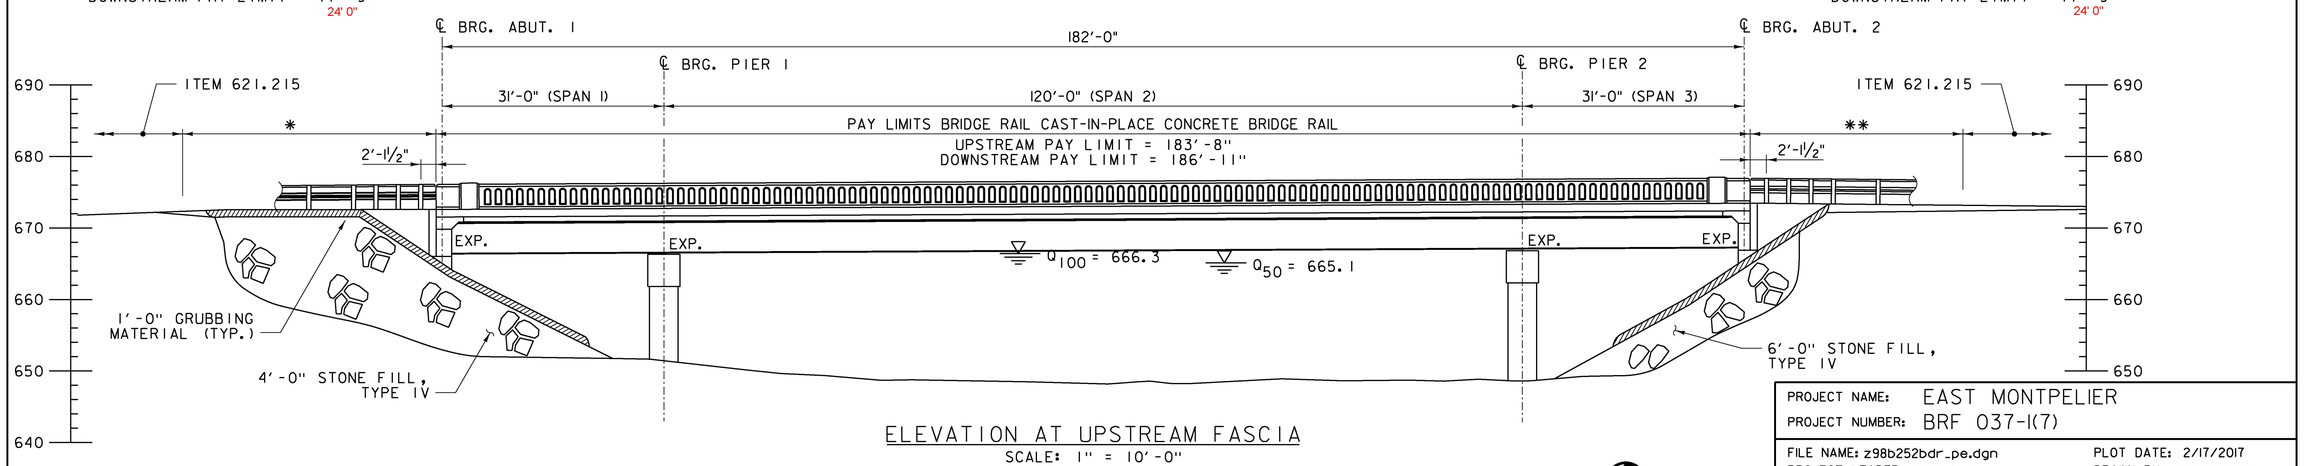

ELEVATION AT UPSTREAM FASCIA

SCALE: 1″ = 10′-0″

0 10 20

Stantec

PROJECT NAME: EAST MONTPELIER	
PROJECT NUMBER: BRF 037-1(7)	
FILE NAME: z98b252bdr_pe.dgn	PLOT DATE: 2/17/2017
PROJECT LEADER: T. KNIGHT	DRAWN BY: L. BUXTON
DESIGNED BY: T. KNIGHT	CHECKED BY: P. GREENBERG
PLAN AND ELEVATION	SHEET 74 OF 158