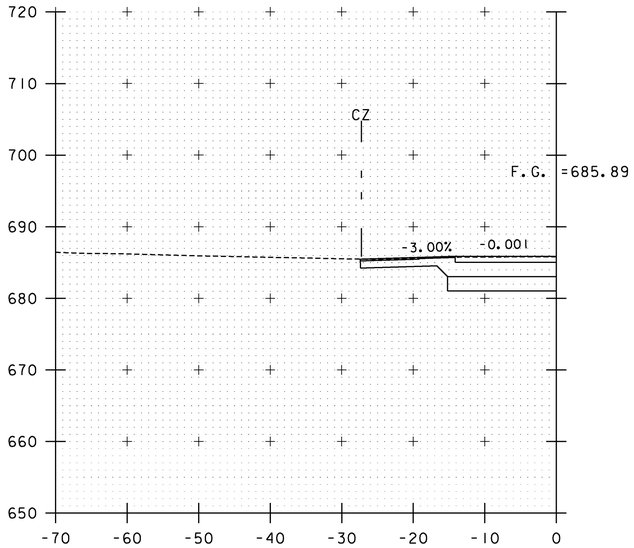

124+58
(DRIVE LEFT)

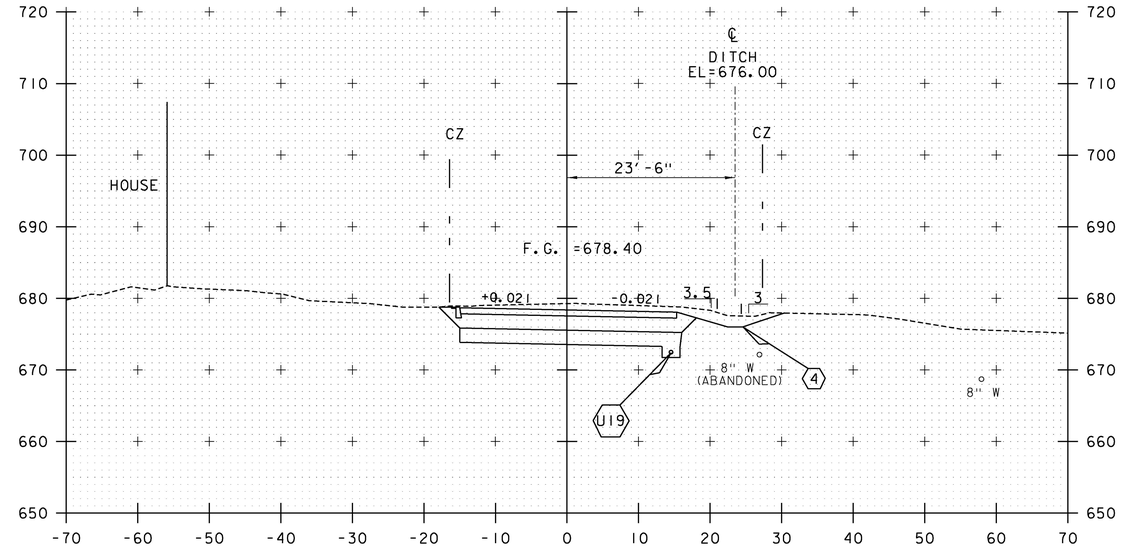

125+50

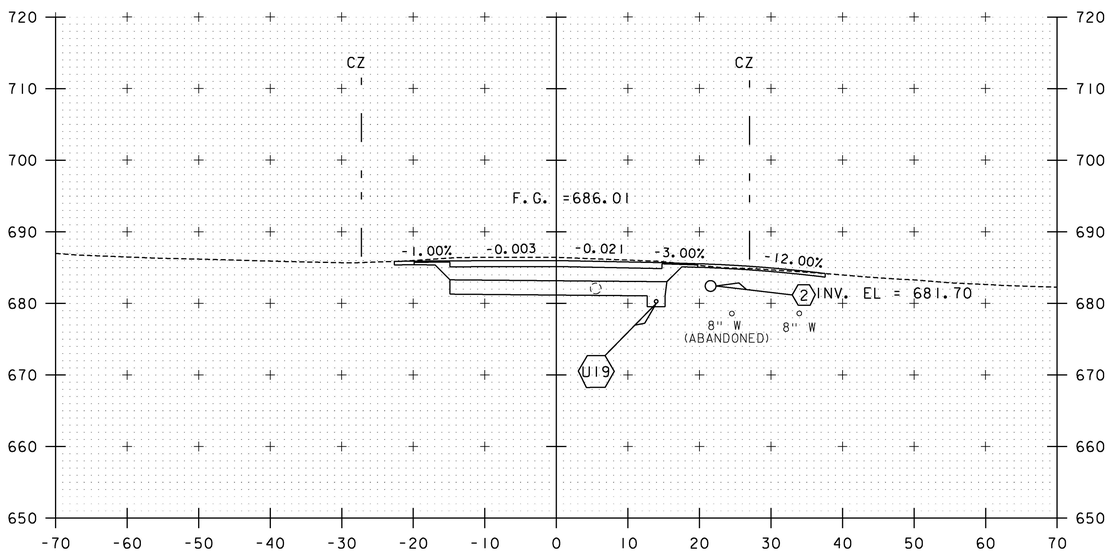

124+50
END APPROACH BEGIN PROJECT (DRIVE RIGHT)

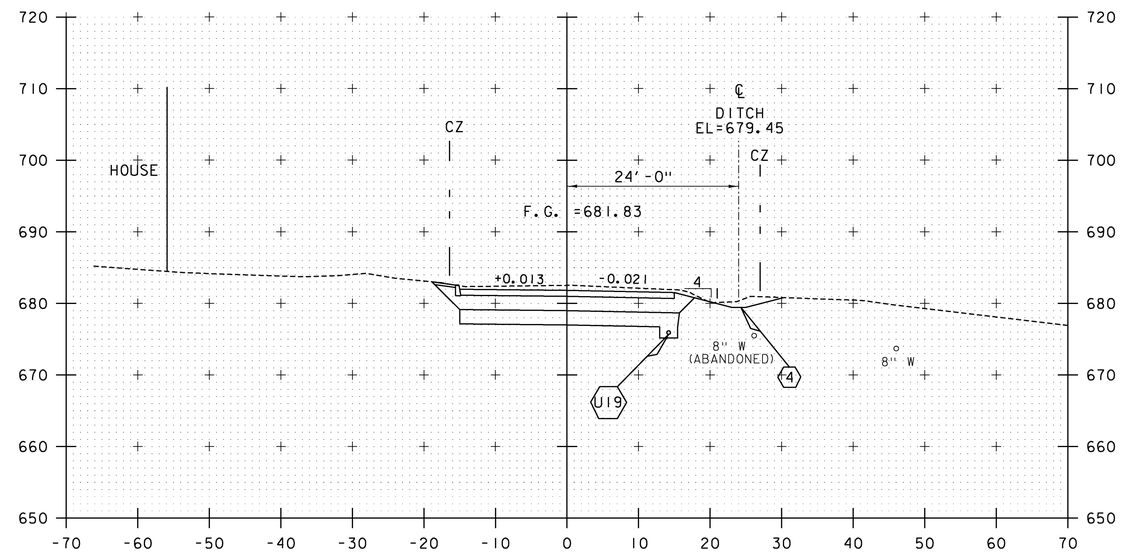

125+00

STA. 124+50 TO STA. 125+50

0 10 20
SCALE

Stantec

PROJECT NAME: EAST MONTPELIER	
PROJECT NUMBER: BRF 037-1(7)	
FILE NAME: 32_Cross Sections.dgn	PLOT DATE: 2/17/2017
PROJECT LEADER: T. KNIGHT	DRAWN BY: C. GENDRON
DESIGNED BY: C. GENDRON	CHECKED BY: K. RICHARDSON
VT RTE 14 CROSS SECTIONS VXS-2	SHEET 110 OF 158