Metric

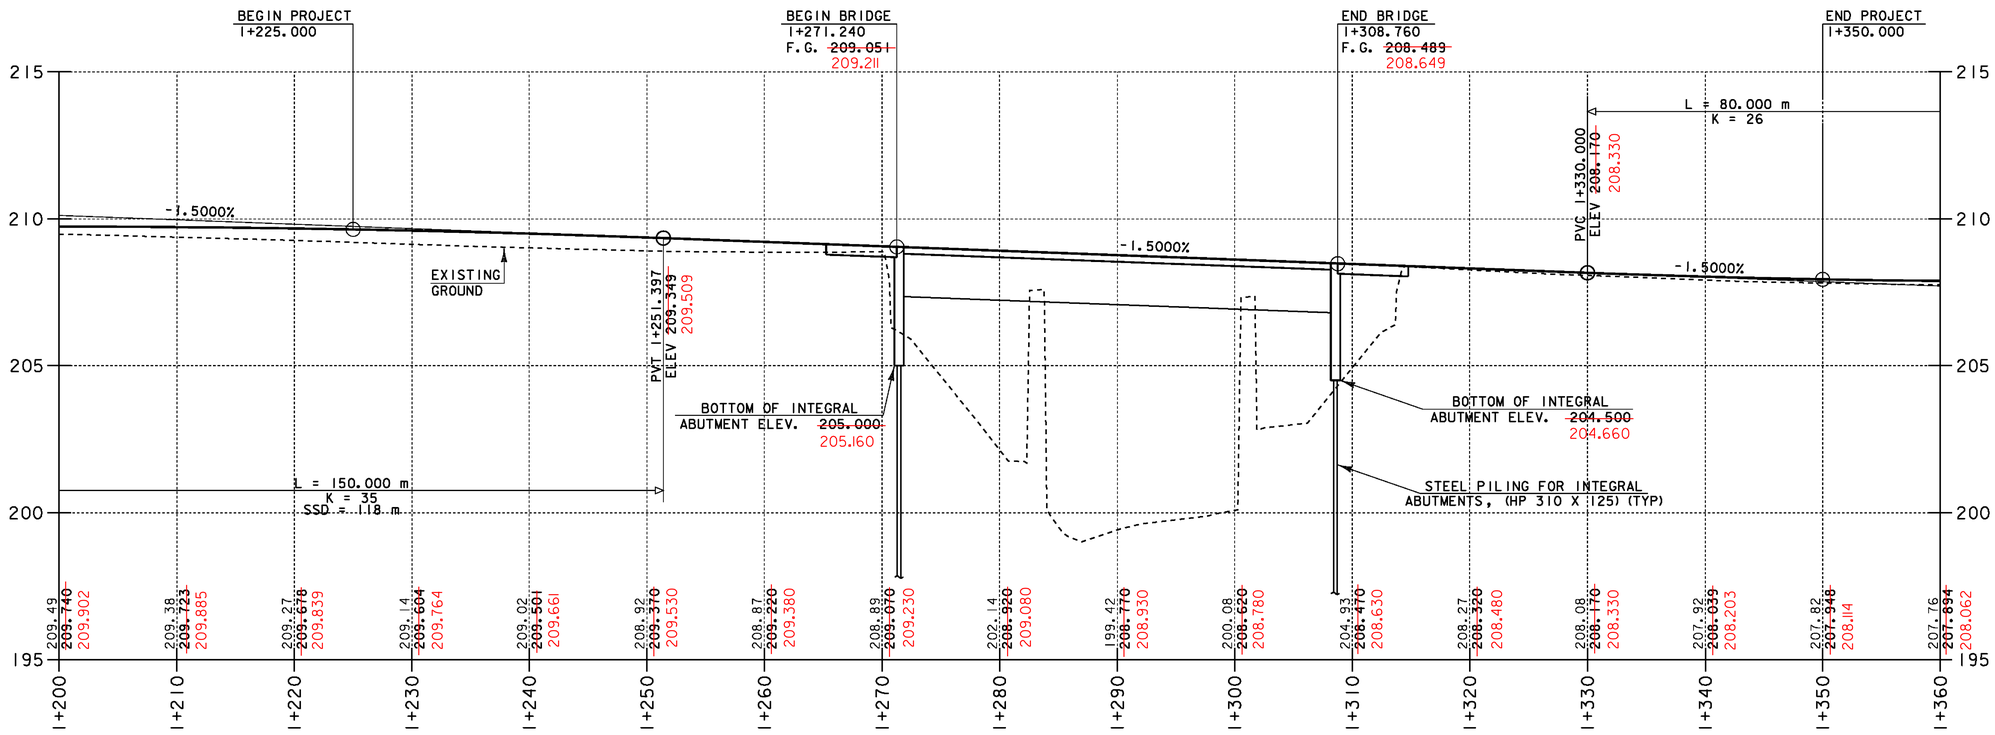

PROFILE US 2

THE GRADES SHOWN TO THE NEAREST HUNDREDTH ARE THE ORIGINAL GROUND ELEVATIONS ALONG THE PROPOSED ALIGNMENT. THE GRADES SHOWN TO THE NEAREST THOUSANDTH ARE THE FINISH GRADES ALONG THE PROPOSED ALIGNMENT.

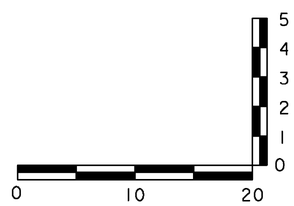

HORIZONTAL SCALE = 1 : 250
VERTICAL SCALE = 1 : 100

PROJECT: EAST MONTPELIER	PROJECT NO.: BRF 028-3(36)
DESIGN FILE NAME: /98b254/str/sb254xs.dgn	
IPARM FILE NAME: sb254pro2.I	PLOT DATE: 03-FEB-2009
DESIGNED BY: J. LACROIX	DRAWN BY: R. PELLETT
SQUAD LEADER: K. HIGGINS	CHECKED BY: J. LACROIX
PROFILE SHEET #2	SHEET: 13 OF 68