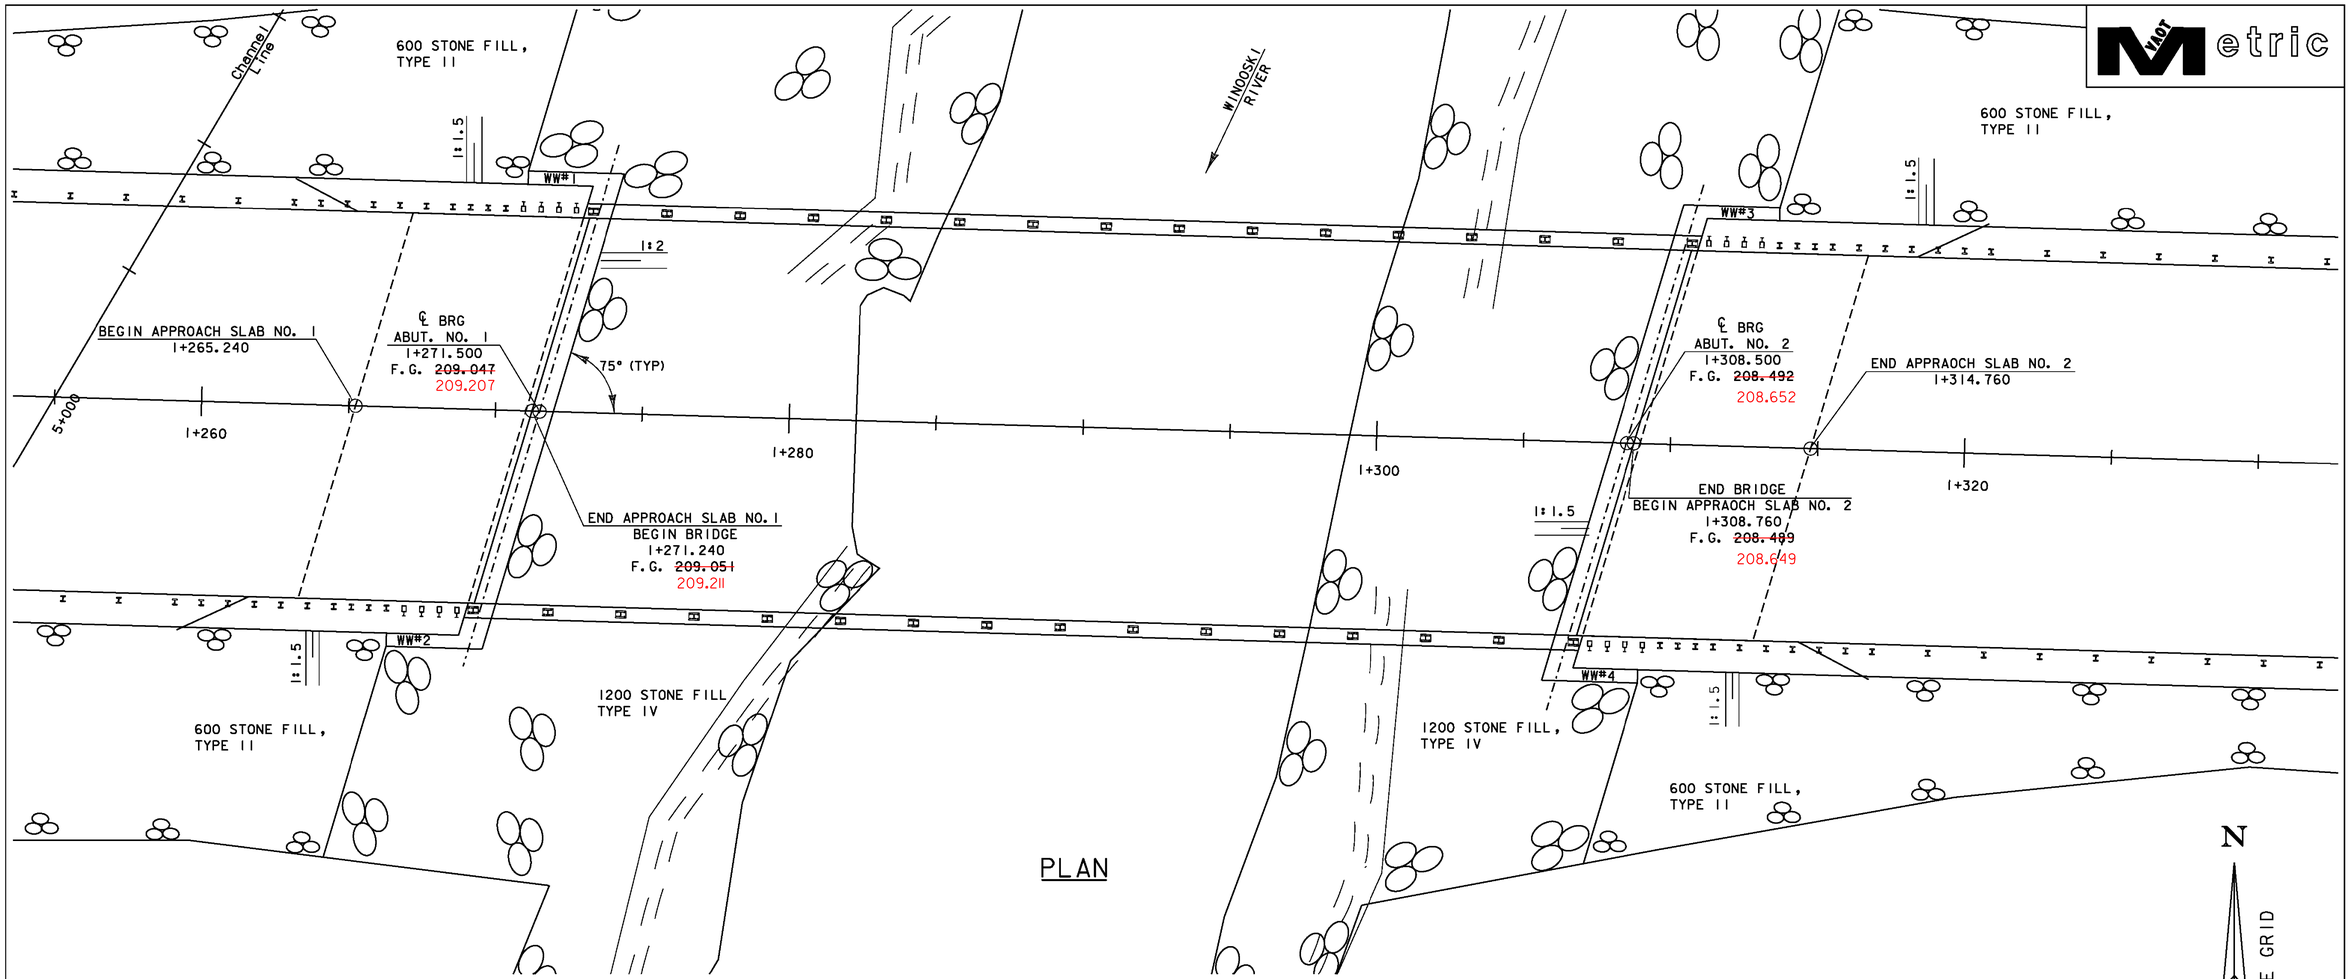

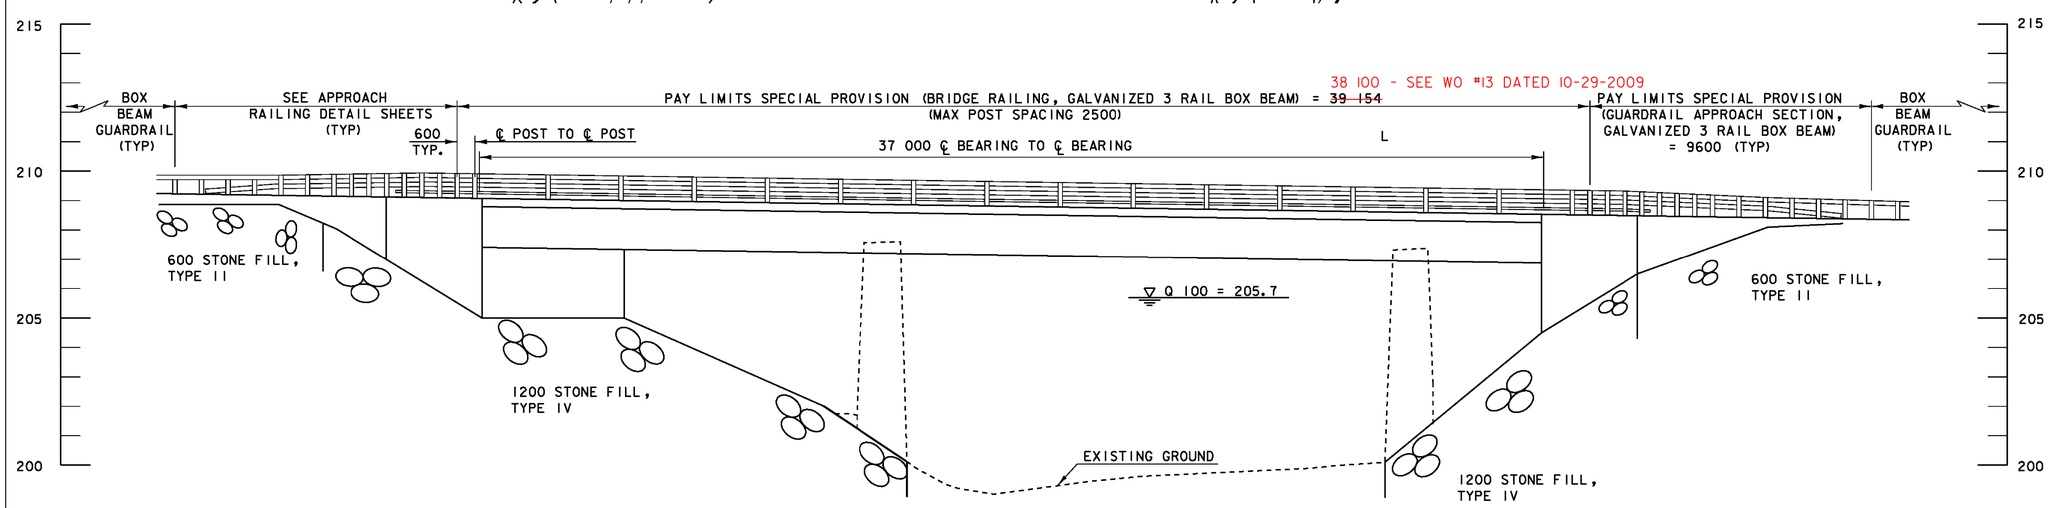

ELEVATION LOOKING UPSTREAM

0 2 4 6 8 10
SCALE 1 : 100

PROJECT: EAST MONTPELIER	PROJECT NO.: BRF 028-3(36)
DESIGN FILE NAME: /98b254/str/sb254pe.dgn	
IPARM FILE NAME: sb254pe.I	PLOT DATE: 03-FEB-2009
DESIGNED BY: J. LACROIX	DRAWN BY: R. PELLETT
SQUAD LEADER: K. HIGGINS	CHECKED BY: J. LACROIX
PLAN AND ELEVATION	SHEET: 26 OF 68