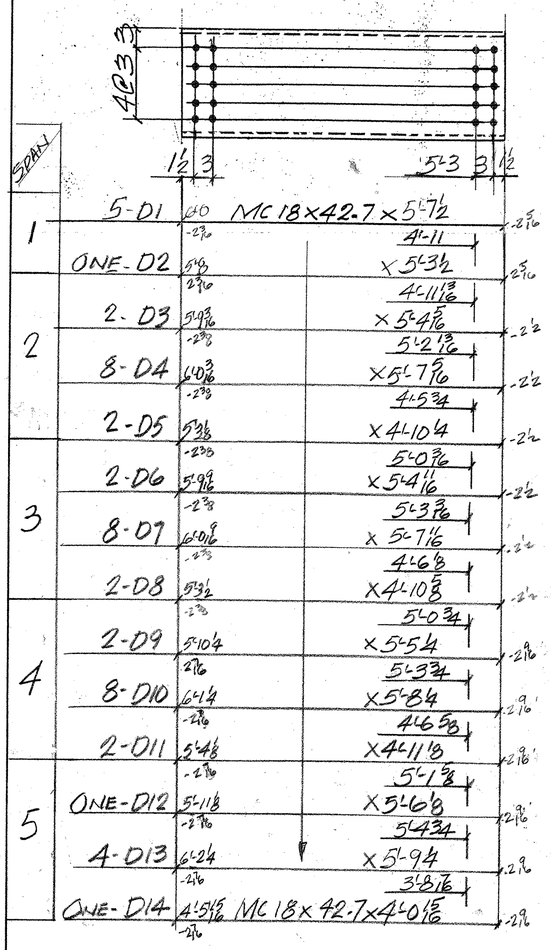

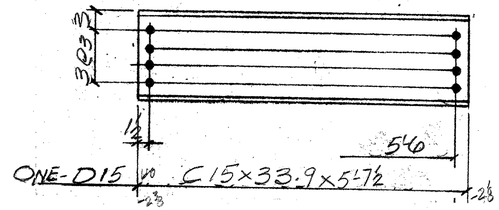

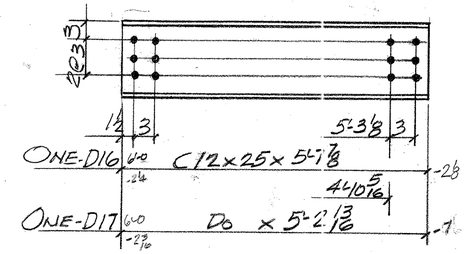

ABM INFO PAGE	LINE	NO.	DESCRIPTION	FT	IN	ASSEM. MARK	SHIPPING MARK	REMARKS	WEIGHT
		5	MC18x42.7	5	7½		D1		
		1		5	3½		D2		
		2		5	4 3/16		D3		
		8		5	7 5/16		D4		
		2		4	10¼		D5		
		2		5	4 1/16		D6		
		8		5	7 1/16		D7		
		2		4	10⅜		D8		
		2		5	5¼		D9		
		8		5	8¼		D10		
		2		4	11⅛		D11		
		1		5	6⅝		D12		
		4		5	9¼		D13		
		1	MC18x42.7	4	0 5/16		D14		
		1	C15x33.9	5	7½		D15		
		1	C12x25	5	7⅞		D16		
		1	Do	5	2 13/16		D17		
		43	PL ½x8	2	9⅝		B51		
		42	Do	2	9⅝		B52		
		5	Do	2	10¼		B53		
		6	Do	2	10¼		B54		
		1	PL ½x5	1	8		B55		
		1	Do	2	9⅝		B56		
		1	PL ½x8	1	8		B57		
		2	Do	1	3¼		B58		
		1	PL ½x12	2	4⅝		B59	BENT	
		992	⅞"ø BOLTS A325		2¼		FIELD	W/N & W.	
		992							

PAY ITEM 560.60

SHOP BILL

JOB NO. 313 DRG. NO. 51

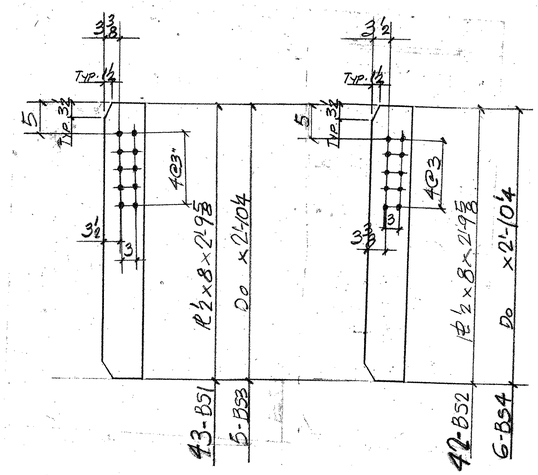

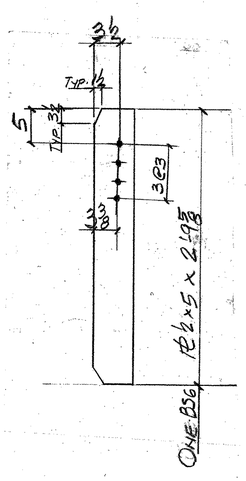

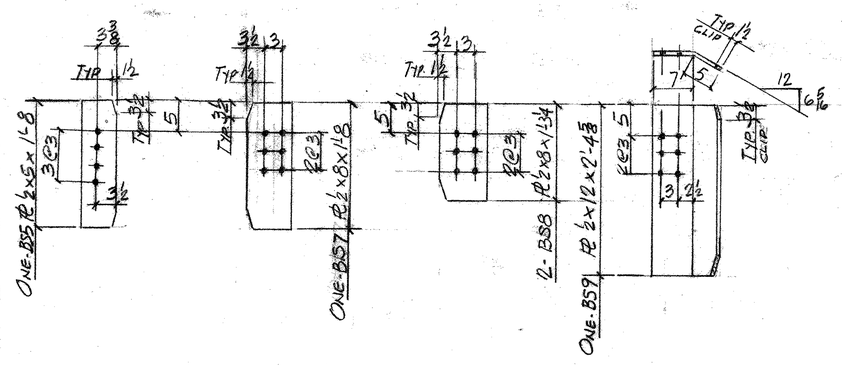

FIELD NOTE
4" HAS BEEN ADDED TO LENGTHS OF BEARING STIFF'S FOR FIELD FIT-UP.

{PLEASE ADVISE IF THIS IS SUFFICIENT

RECEIVED
CK'D BY DRP OK'D BY
FEB 21 2007
RESUBMIT ____ APPROVED ✓
BY DATE

OUT FOR APPROVAL	2-13-07									
OUT FOR APPROVAL										
ISSUED TO SHOP										
FIELD & OFFICE										
REV.	REMARKS	DATE	DWN	CHK	APP	Q.A.	NO.	DIA.	LGT	TYPE	WASHER

PROJECT NO. BHF-030-2(19)S STATE PROJECT NO. BRIDGE-20
MATERIAL AASHTO M270 Gr 36 ELECTRODES: SEE PROC. HOLES: 13/16" ø SHOP BOLTS: —
SURFACE PREP. & PAINT:

DESCRIPTION: DIAPHRAGM DETAILS
JOB: VERMONT 15 OVER LAMOILLE RIVER CAMBRIDGE, VT.
CUSTOMER: BECK & BELLUCCI

DRAWN BY	DATE
JPF	1-07
CHKD BY	
APPROV BY	
Q.A.	

CASCO BAY STEEL STRUCTURES, INC.
75 SPRING HILL ROAD SACO, MAINE 04072
PHONE (207) 282-7360 FAX. (207) 282-1179

JOB NO. 313 DRG. NO. 51 REV. △