VAOT Metric

TEMPORARY AND DURABLE 100 mm YELLOW LINE

STA 12+400 TO ~~12+456~~ SOLID LT & RT 12+474
12+474 STA ~~12+456~~ TO ~~12+682~~ SOLID LT, DASHED RT 12+700
12+700 STA ~~12+682~~ TO ~~12+835~~ DASHED 12+848
12+848 STA ~~12+835~~ TO ~~12+955~~ DASHED LT, SOLID RT 12+971
12+971 STA ~~12+955~~ TO 12+979 SOLID LT & RT
STA 12+991 DOUBLE SOLID LT (TH 64)
STA 12+991 TO 13+100 SOLID LT & RT

TEMPORARY AND DURABLE 100 mm WHITE LINE

STA 12+400 TO 12+976 SOLID LT
STA 12+400 TO 13+100 SOLID RT
STA 13+000 TO 13+100 SOLID LT

CHANGING ELEV. OF DI, CB OR MH
REHABILITATION OF DI, CB OR MH CLASS I

STA ~~12+910~~ LT 12+920
STA ~~12+960~~ LT 12+969

RELOCATING MAILBOX - SINGLE SUPPORT

~~STA 12+688 LT~~
~~STA 12+910 RT~~

TEMPORARY AND DURABLE LETTER OR SYMBOL

STA 12+991 LT "STOP" (TH 64)

TEMPORARY AND DURABLE 600 mm STOP BAR

STA 12+991 LT (TH 64)

REMOVING SIGNS

AS SHOWN - ~~8~~ 9

ERECTING SALVAGED SIGNS

AS SHOWN - 4

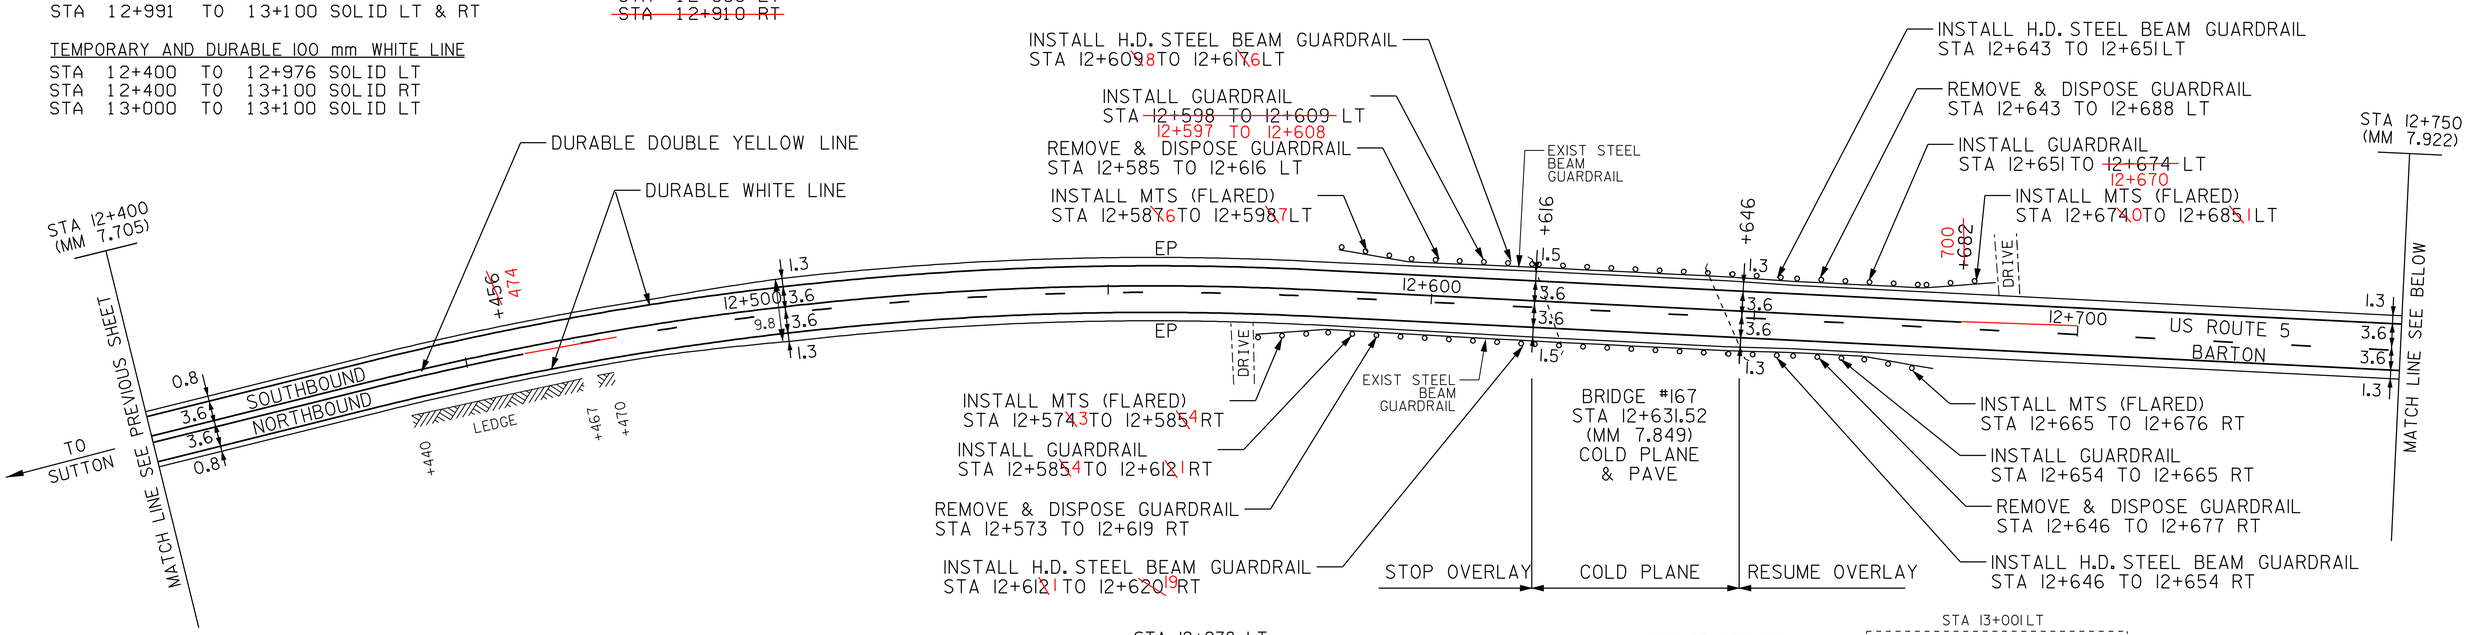

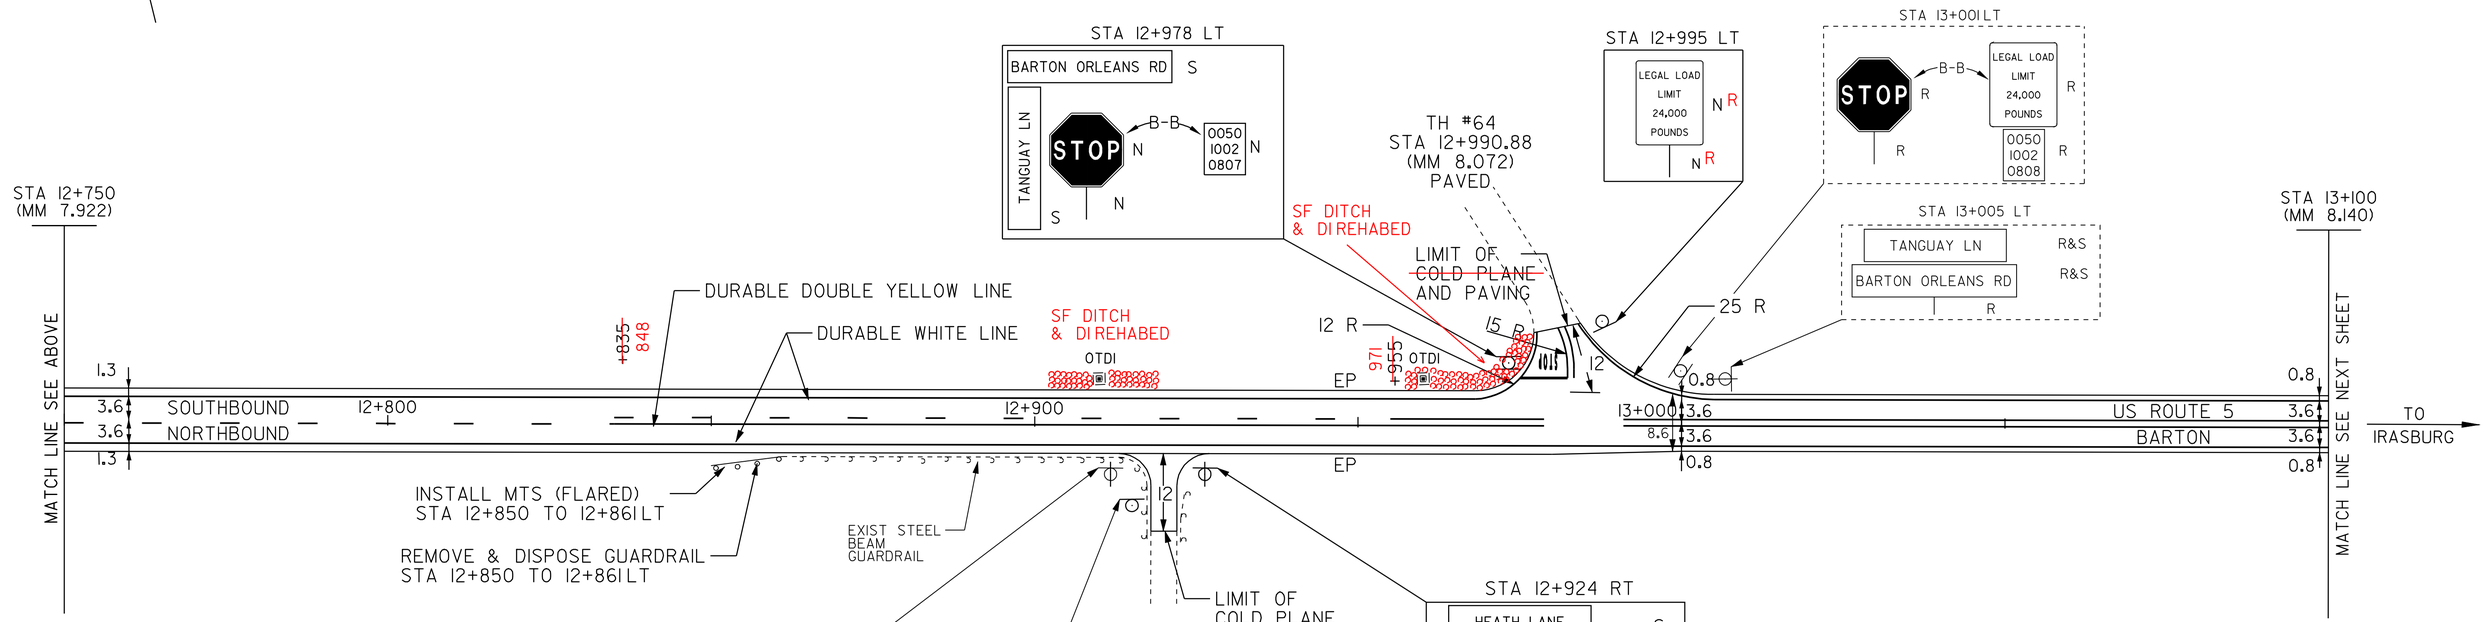

~~REMOVAL AND DISPOSAL OF GUIDE POSTS~~
~~STA 12+819 TO 12+849 LT (15)~~

STEEL BEAM GUARDRAIL

STA 12+585 ~~4~~ TO 12+612 ~~1~~ RT
STA 12+598 ~~7~~ TO 12+609 ~~8~~ LT
STA 12+651 TO 12+674 ~~0~~ LT
STA 12+654 TO 12+665 RT

REMOVE AND DISP GUARDRAIL

STA 12+573 ~ 12+619 RT
STA 12+585 ~ 12+616 LT
STA 12+643 ~ 12+688 LT
STA 12+646 ~ 12+677 RT
STA 12+850 ~ 12+861 LT

MANUFACTURED TERMINAL SECTION (FLARED)

STA 12+585 ~~4~~ RT - 12+611
12+586 - STA 12+598 ~~7~~ LT
STA 12+674 ~~0~~ LT - 12+681
STA 12+665 RT - 12+676
STA 12+850 LT - 12+861

HEAVY DUTY STEEL BEAM GUARDRAIL

STA 12+609 ~~8~~ TO 12+617 ~~6~~ LT
STA 12+612 ~~1~~ TO ~~12+620~~ RT 12+619
STA 12+643 TO 12+651 LT
STA 12+646 TO 12+654 RT

NOT TO SCALE

LEGEND

R	=	REMOVE EXISTING
S	=	SALVAGE
R&S	=	REMOVE AND SALVAGE
N	=	NEW
RET	=	RETAIN
B-B	=	BACK TO BACK
	=	NEW RAIL
	=	EXISTING RAIL
⊗	=	BORING LOCATION

NOTE: ALL DIMENSIONS IN METERS EXCEPT AS INDICATED

DATUM
VERTICAL N/A
HORIZONTAL N/A

PAVING PROJECT LAYOUT #7

PROJECT: BARTON-IRASBURG
PROJECT NO.: STP 2107(I)S

DESIGN FILE NAME: pave/98c096/pc096.dgn
IPARM FILE NAME: pc096107.i PLOT DATE: 21-MAY-2007
SURVEYED BY: CLD ENGINEERS INC SURVEY DATE: 6/99
SQUAD LEADER: WRH DRAWN BY: NLL
SHEET: 18 OF 49