STATE OF VERMONT
AGENCY OF TRANSPORTATION

TRAFFIC SIGN SUMMARY SHEET 6

VAOT Metric

KILOMETER MARKER, STATION, OR SIGN NUMBER	SIGN LEGEND	SIGN DIMENSIONS EA	WIDTH (mm)	HEIGHT (mm)	NEW & SALVAGED SIGNS "A"	"B"	SALV SIGN	SALV TIS	EXIST POST RETAIN	EXIST POST SALVAGE	NEW SIGN POSTS NO. OF POSTS	FLANGED CHANNEL kg/m 1.7	3.0	4.5	SQUARE STEEL (mm) kg/m 44 3.4	50 3.9	63 5.0	ANCHOR	SLEEVE	TUBULAR ALUMINUM Ø (mm) kg/m 75 1.9	100 2.5	100 MOD 2.5	TUBULAR STEEL Ø (mm) FOUNDATION	kg/m 75 11.3	89 13.4	100 16.1	125 21.7	W-SHAPE STEEL FTG. SIZE 600 mm	750 mm	WEIGHT	POST SIZE	SIGN FRAME REQUIRED	REMARKS	SIGN DETAIL DETAIL ON SHEET NUMBER	STD. SHEET NUMBER
												OPTION ITEMS																									
STA 0+324 LT		1	750	750	0.56						1			X 14′			X																		E-143M
STA 0+335 CL (2)		1 1	600 750	750 750	0.45 0.56						1			X 14′			X																		E-144M E-144M
	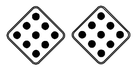	2	450	450	0.40																														E-144M
																																		SIGN HIT BY A TRUCK NEW SIGN ON EXISTING POST		
STA 0+339 RT		1	600	750	0.45						1			X 14′			X																		E-141M
0+339 RT		1	600	750	0.45																														
STA 0+350 RT		1	750	750	0.56						1			X 14′			X																		E-143M
STA 0+350 CL		1 1	600 750	750 750	0.45 0.56						1			X 14′			X																		E-144M E-144M
	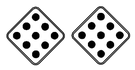	2	450	450	0.40																														E-144M
STA 0+405 LT		1	900	750	0.68						1			X 14′			X																		E-145AM
STA 0+435 CL		1	600	750	0.45						1			X 14′			X																		E-144M
		1	450	450	0.40																														E-144M
												m	m	m	m	m	m		EA	kg	kg	kg		kg	kg	kg	kg							
												98′ = 29.87																							
SHEET TOTALS		m² 6.37 ~~5.92~~		m²	EA.	m²						m ~~32.2~~ 29.87			m 32.2					kg			EA.	kg				EA.	EA.	kg					

FINAL POST LENGTHS ARE TO BE DETERMINED IN THE FIELD. POST SIZES ARE COMPUTED BASED ON INFORMATION FURNISHED ON THE STANDARD SHEETS AND THE TRAFFIC & SAFETY DIVISION'S "SIGN POST DESIGN GUIDELINE."

PROJECT :	PROJECT NO. :
BARTON-IRASBURG	STP 2107(I)S

DESIGN FILE NAME: pave/98c096/pc096.dgn
IPARM FILE NAME: pc096ts06.i PLOT DATE: 21-MAY-2007 13
SURVEYED BY: JLR SURVEY DATE: 6/04
SQUAD LEADER: MW DRAWN BY: JLR
SHEET: 42 OF 49