TEMPORARY AND DURABLE 100 mm YELLOW LINE
STA 7+050 TO 7+650 SOLID LT & RT

TEMPORARY AND DURABLE 100 mm WHITE LINE
STA 7+050 TO 7+650 SOLID LT & RT

CHANGING ELEV. OF DI, CB OR MH
REHABILITATION OF DI, CB OR MH
STA 7+061 RT OTDI
STA 7+161 RT OTDI

SHOULDER BERM REMOVAL
STA 7+100 TO 7+650 LT

MANUFACTURED TERMINAL SECTION (FLARED)
STA 7+089 TO 7+100 LT

REMOVE & DISPOSE GUARDRAIL
STA 7+089 TO 7+100 LT

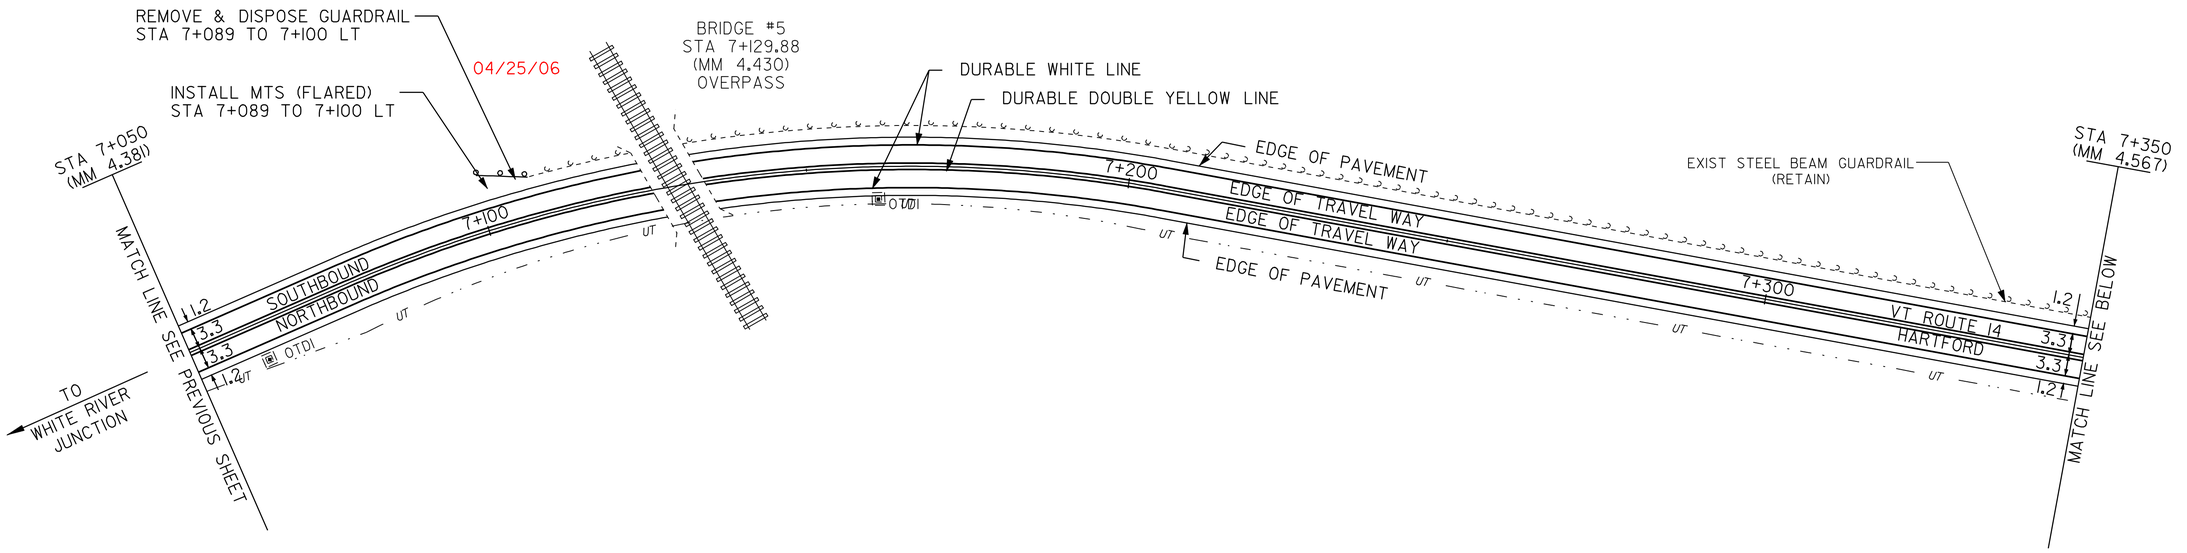

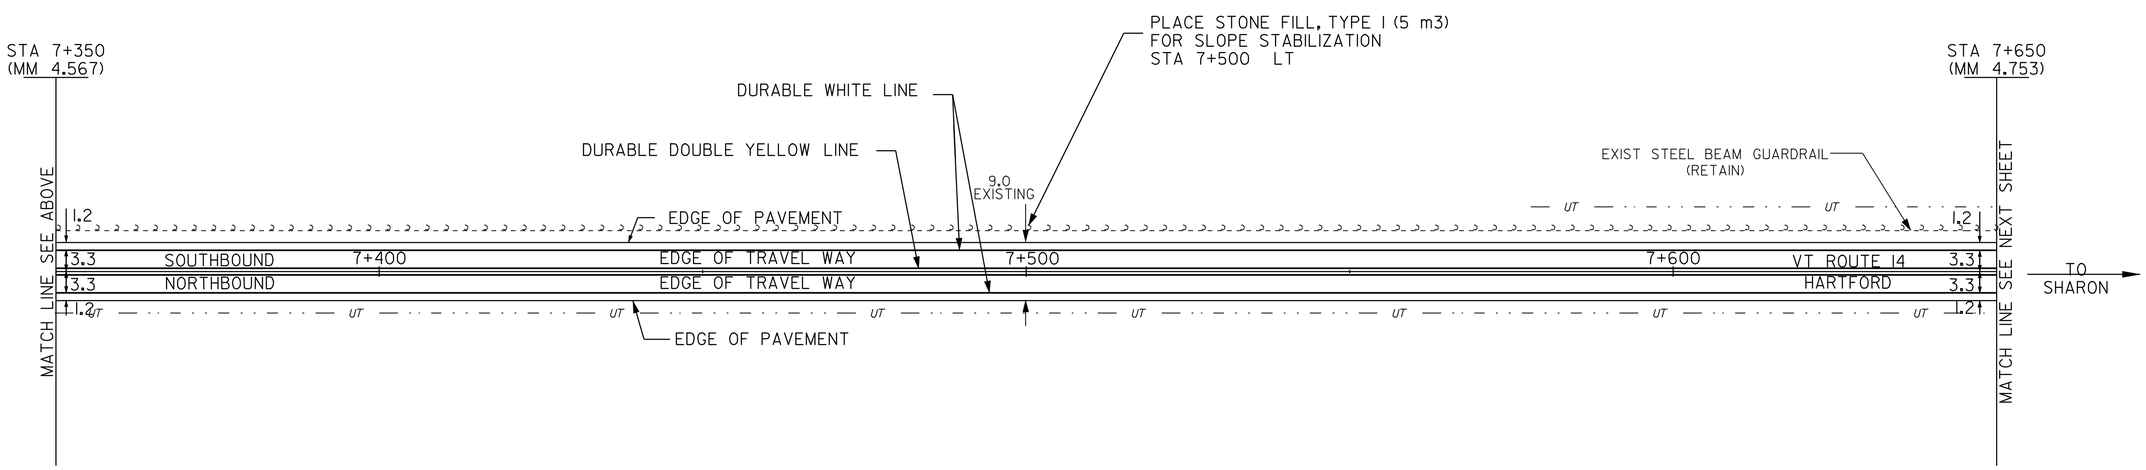

LEGEND

R	=	REMOVE EXISTING
S	=	SALVAGE
R&S	=	REMOVE AND SALVAGE
N	=	NEW
RET	=	RETAIN
B-B	=	BACK TO BACK
	=	NEW RAIL
	=	EXISTING RAIL
⊗	=	BORING LOCATION

NOTE: ALL DIMENSIONS IN METERS EXCEPT AS INDICATED

NOT TO SCALE

DATUM
VERTICAL N/A
HORIZONTAL N/A

PAVING PROJECT LAYOUT #9

PROJECT: HARTFORD - ROYALTON
PROJECT NO.: STP 2121(1)S
DESIGN FILE NAME: /pave/98c174/pc174.dgn
IPARM FILE NAME: pc174109.i
PLOT DATE: 21-MAR-2007
SURVEYED BY: CLD ENGINEERS INC
SURVEY DATE: 8/99
SQUAD LEADER: WRH
DRAWN BY: REB
SHEET: 19 OF 64