DITCHING LOCATIONS (REFER TO SHEET 10 FOR DETAILS)

STA ~~465+75 TO 483+50 RT~~ 464+48 TO 468+97 RT
STA ~~484+60 TO 502+00 RT~~ 476+66 TO 482+50 RT
492+00 TO 496+00 RT

TEMPORARY AND DURABLE 4in YELLOW LINE

STA 456+00 TO 502+00 SOLID LT&RT
STA 481+00 DOUBLE SOLID LT
(WITH CENTERLINE BREAKS FOR TOWN HIGHWAYS)

TEMPORARY AND DURABLE 4in WHITE LINE

STA 456+00 TO 502+00 SOLID LT&RT
(WITH EDGELINE BREAKS FOR TOWN HIGHWAYS)

YIELDING MARKER POST

~~STA 469+76 LT~~
~~STA 471+63 LT~~

TEMPORARY AND DURABLE 24in STOP BAR

STA 481+00 LT HILL WEST RD

TEMPORARY AND DURABLE LETTER OR SYMBOL

STA 481+00 LT "STOP"

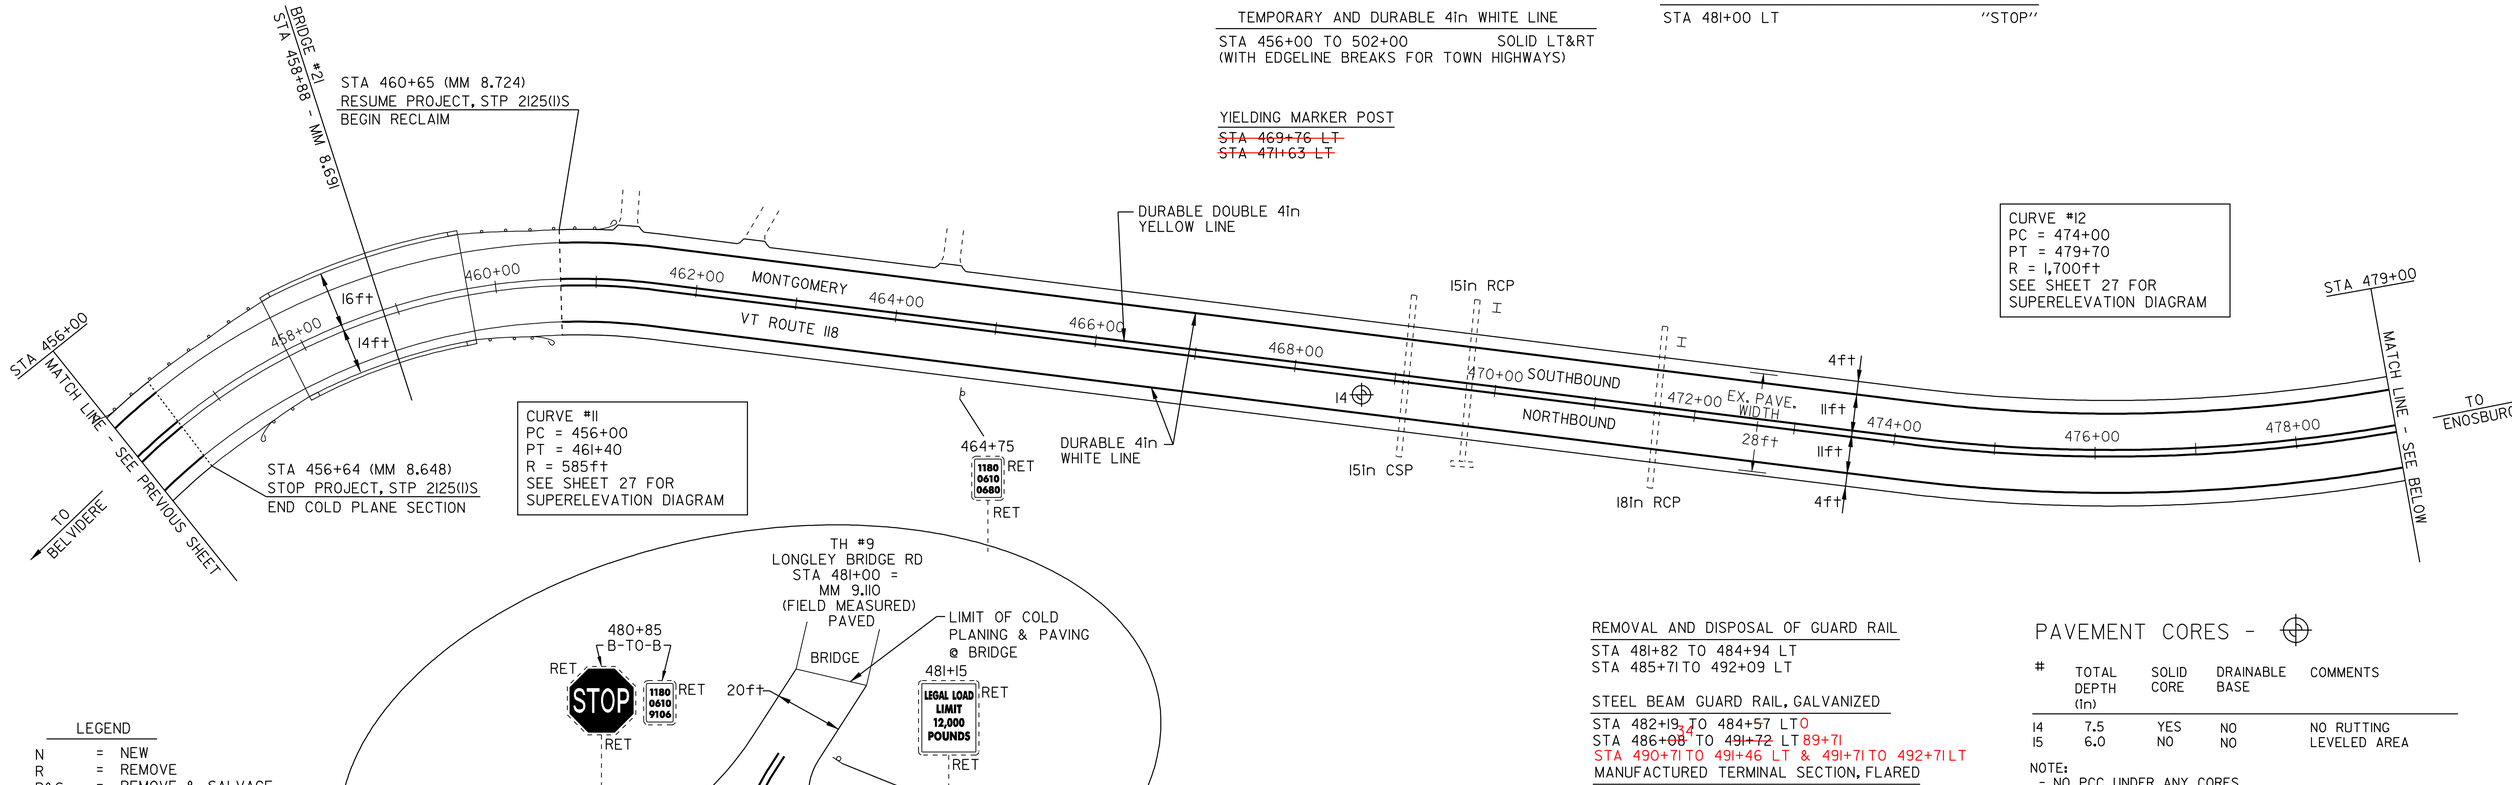

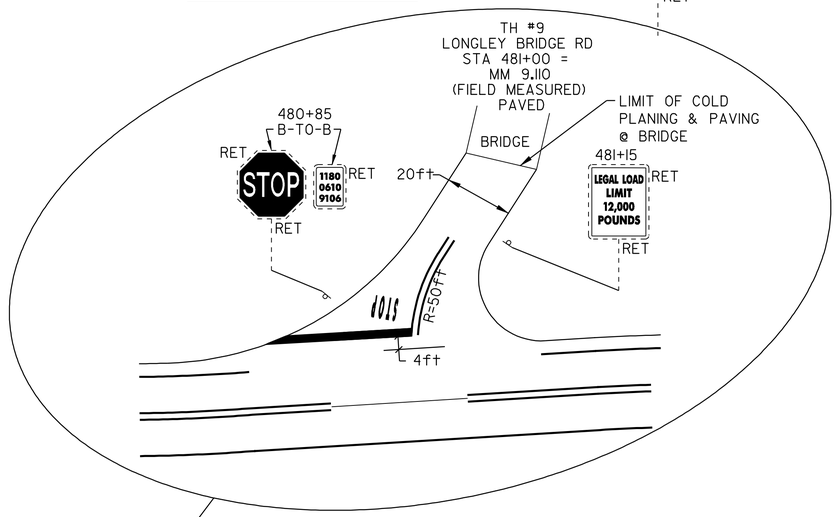

LEGEND

N	=	NEW
R	=	REMOVE
R&S	=	REMOVE & SALVAGE
S	=	SALVAGE
RET	=	RETAIN
B-TO-B	=	BACK TO BACK
		CATCH BASIN/DI
		EXISTING THROAT DI
		MARKER POST
		UTILITY POLE
UE/T		UTIL. POLE W/UNDERGROUND UTIL.
		DRIVE

REMOVAL AND DISPOSAL OF GUARD RAIL

STA 481+82 TO 484+94 LT
STA 485+71 TO 492+09 LT

STEEL BEAM GUARD RAIL, GALVANIZED

STA 482+19 TO 484+57 LT
STA 486+~~08~~ 34 TO ~~491+72~~ LT 89+71
STA 490+71 TO 491+46 LT & 491+71 TO 492+71 LT

MANUFACTURED TERMINAL SECTION, FLARED

STA 481+82 TO 482+19 LT
STA 484+57 TO 484+94 LT
STA 485+71 TO 486+08 LT
STA ~~491~~ 2 +72 TO ~~492~~ 3 +09 LT

STEEL BEAM GUARD RAIL W/ 8' POSTS

STA 484+07 TO 484+57 LT
STA 486+08 TO 486+34 LT
STA 489+71 TO 490+71 LT
STA 491+46 TO 491+72 LT

PAVEMENT CORES -

#	TOTAL DEPTH (in)	SOLID CORE	DRAINABLE BASE	COMMENTS
I4	7.5	YES	NO	NO RUTTING
I5	6.0	NO	NO	LEVELED AREA

NOTE:
- NO PCC UNDER ANY CORES
- NO CORES OVER ASPHALTED
- NO SHOULDER CORES

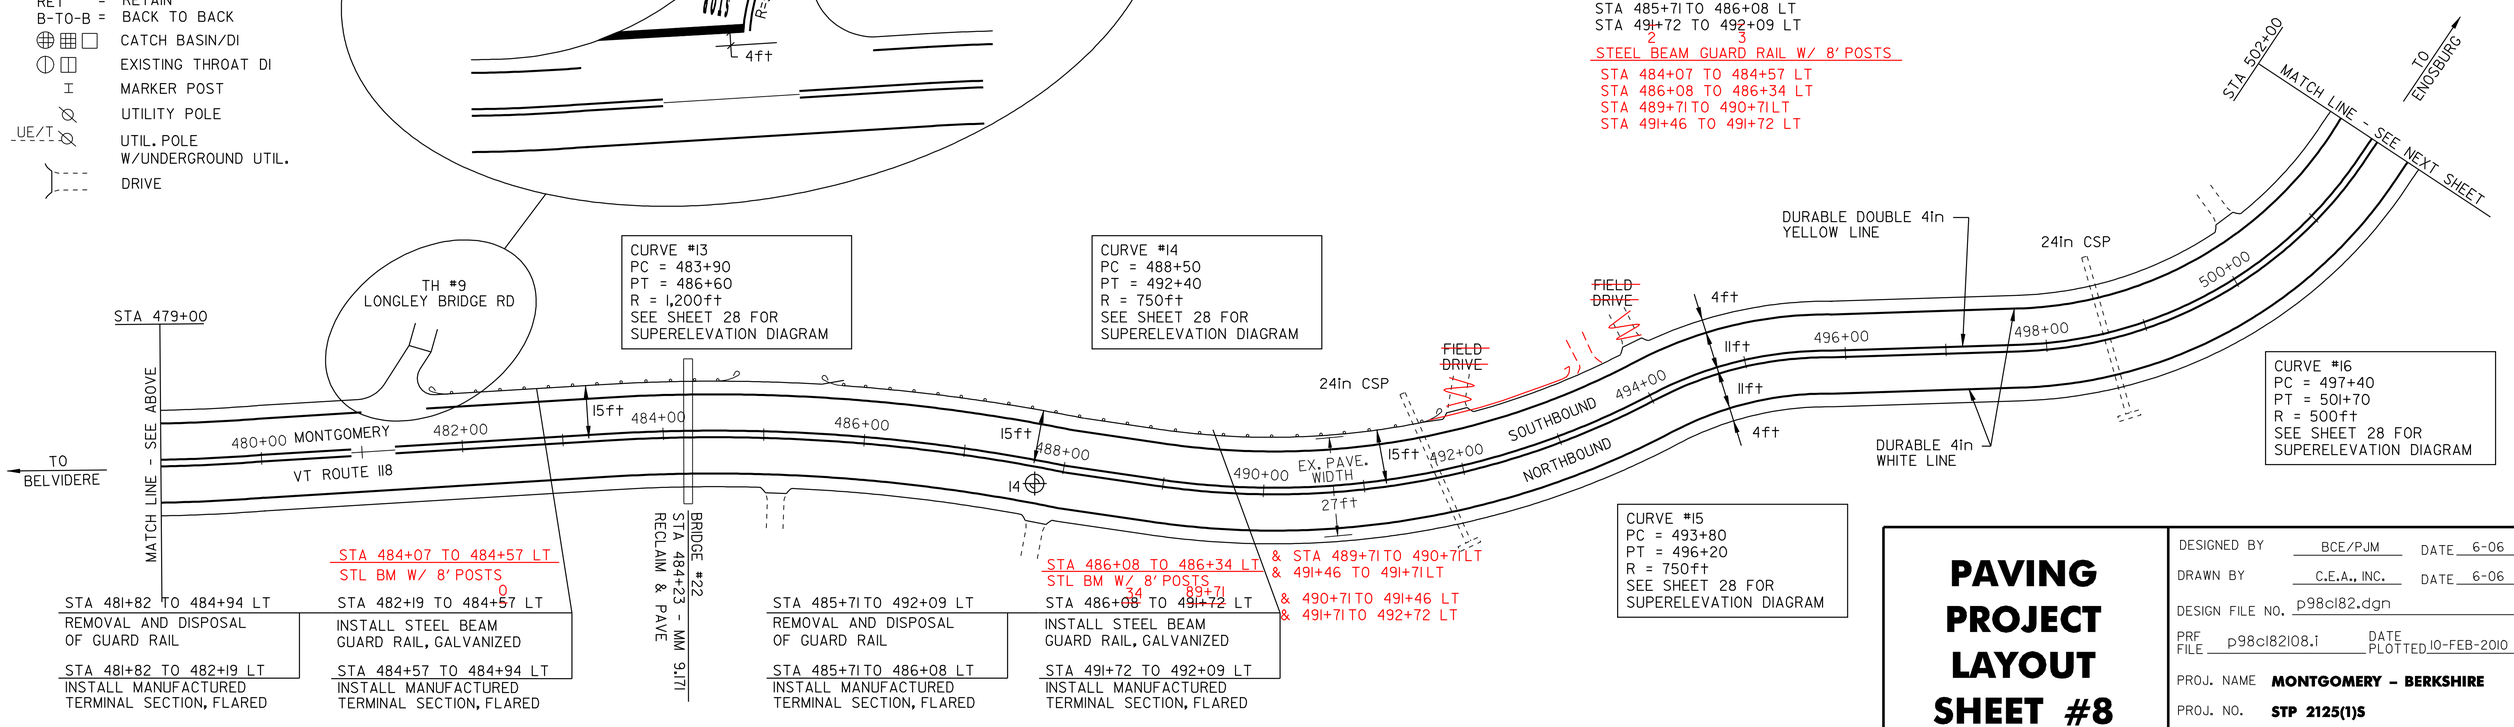

STA 481+82 TO 484+94 LT
REMOVAL AND DISPOSAL OF GUARD RAIL

STA 481+82 TO 482+19 LT
INSTALL MANUFACTURED TERMINAL SECTION, FLARED

STA 482+19 TO 484+57 LT
INSTALL STEEL BEAM GUARD RAIL, GALVANIZED

STA 484+57 TO 484+94 LT
INSTALL MANUFACTURED TERMINAL SECTION, FLARED

STA 485+71 TO 492+09 LT
REMOVAL AND DISPOSAL OF GUARD RAIL

STA 485+71 TO 486+08 LT
INSTALL MANUFACTURED TERMINAL SECTION, FLARED

STA 486+~~08~~ 34 TO ~~491+72~~ LT 89+71
INSTALL STEEL BEAM GUARD RAIL, GALVANIZED

STA 491+72 TO 492+09 LT
INSTALL MANUFACTURED TERMINAL SECTION, FLARED

STA 484+07 TO 484+57 LT
STL BM W/ 8' POSTS
0

STA 486+08 TO 486+34 LT
STL BM W/ 8' POSTS
34 89+71

& STA 489+71 TO 490+71 LT
& 491+46 TO 491+71 LT
& 490+71 TO 491+46 LT
& 491+71 TO 492+72 LT

PAVING PROJECT LAYOUT SHEET #8

DESIGNED BY BCE/PJM DATE 6-06
DRAWN BY C.E.A., INC. DATE 6-06
DESIGN FILE NO. p98cl82.dgn
PRF FILE p98cl82108.i DATE PLOTTED 10-FEB-2010 14:
PROJ. NAME **MONTGOMERY - BERKSHIRE**
PROJ. NO. **STP 2125(1)S**
SHEET **18** OF **41** SHEETS