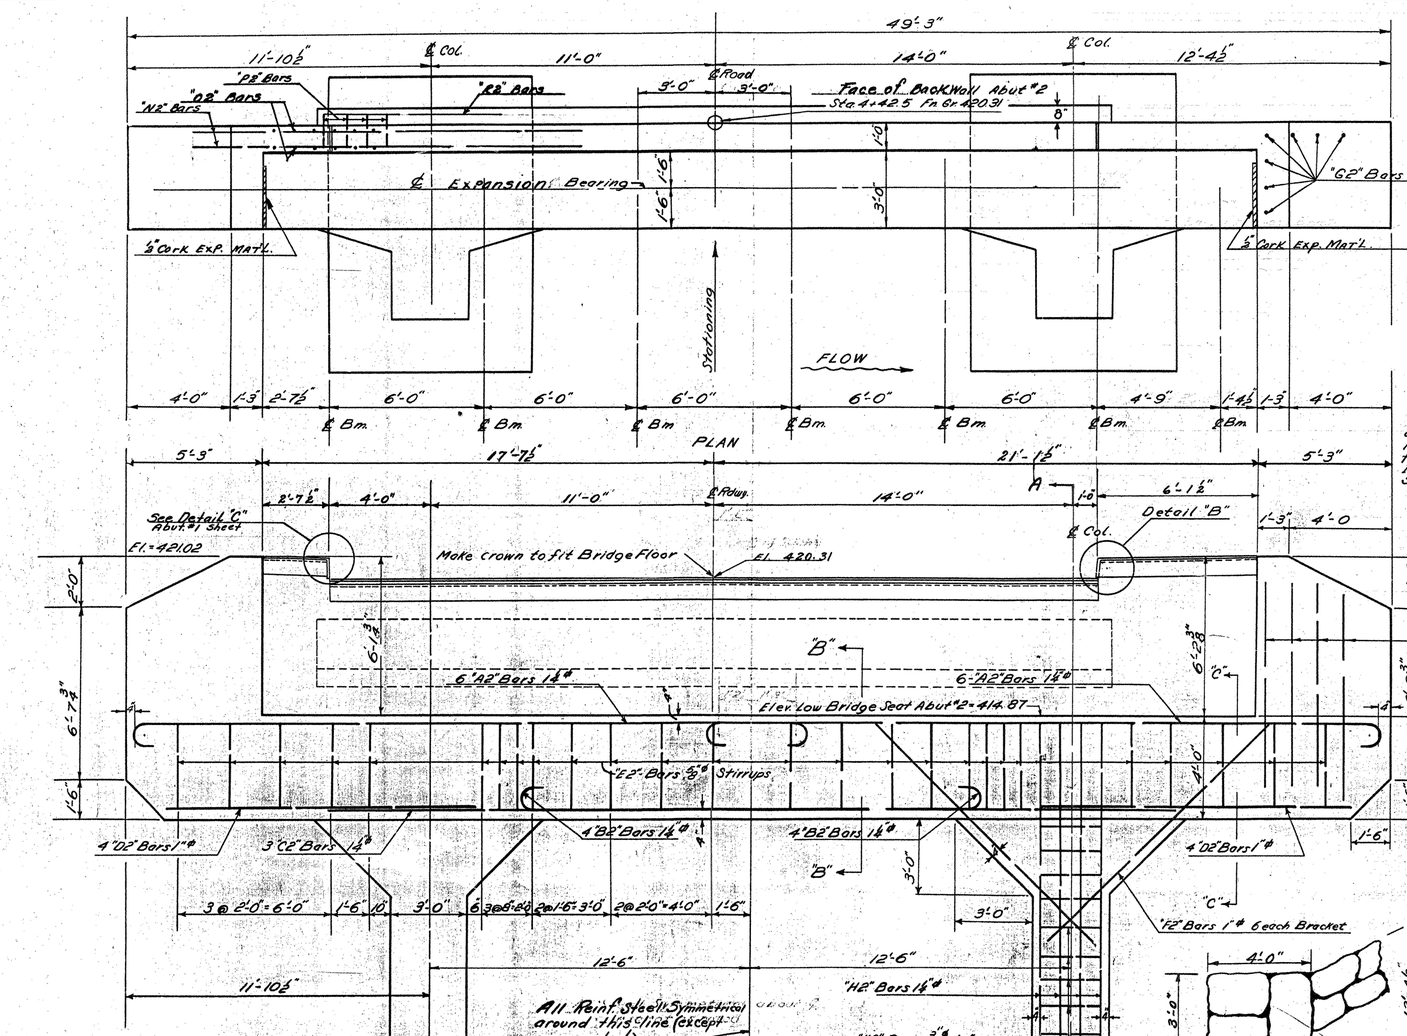

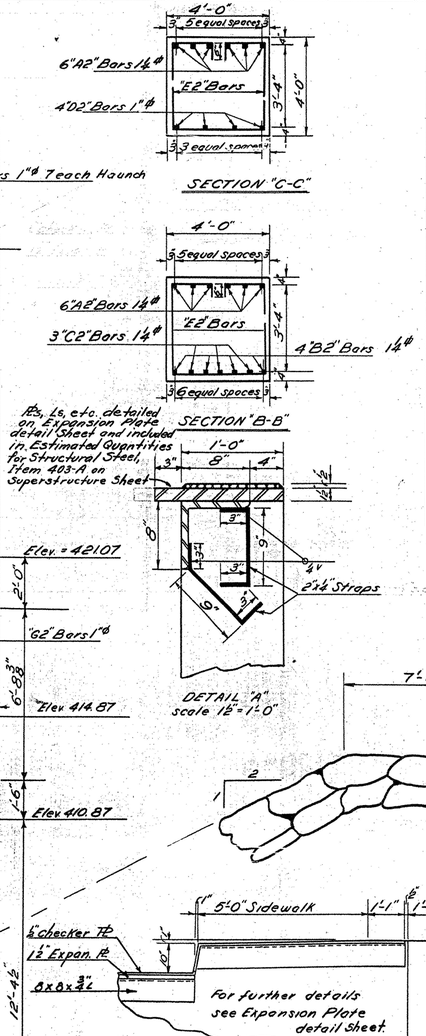

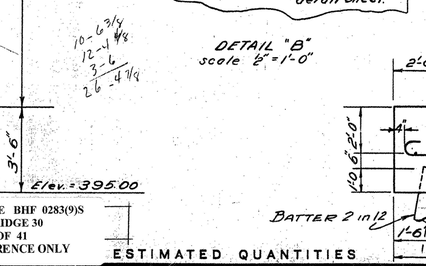

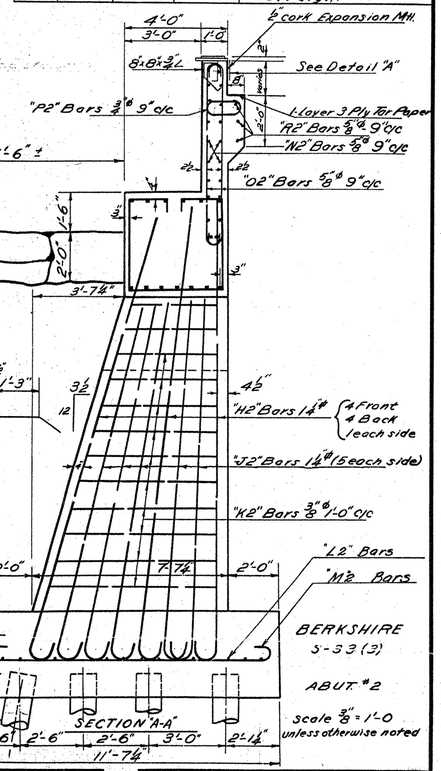
4'-0"
3'-0"
1'-0"
½" cork Expansion MH.
8"x8"x¾ L
See Detail "A"
"P2" Bars ¾ϕ 9" c/c
1 layer 3 Ply Tar Paper
"R2" Bars ⅝ϕ 9" c/c
"N2" Bars ⅝ϕ 9" c/c
"O2" Bars ⅝ϕ 9" c/c
7'-6" ±
1'-6"
2'-0"
3'-7¼"
1'-6"
1'-6"
1'-6