FED.ROAD DIV.NO.	STATE	FED.AID PROJ.NO.
	VT	

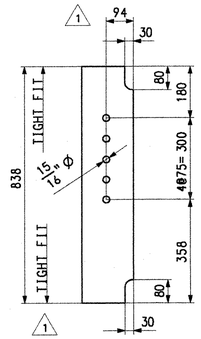

CONN. PLATE MK. x1a

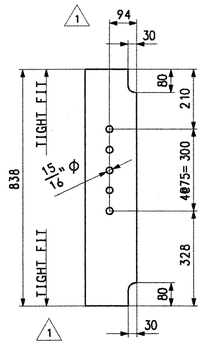

CONN. PLATE MK. x1b

BILL OF MATERIAL

SHIP.	QTY. EA.	MARK	COMM.	DESCRIPTION					LENGTH	SPEC	GRADE	TEST	REMARKS	GRP.	ITEM	SHIP WEIGHT EA. (KG)
1	16	x1a	PL	13	x	178			838	M270M	345W			7	1	15.22
1	8	x1b	PL	13	x	178			838	M270M	345W			7	1	15.22

RECEIVED
CK'D BY MGK CK'D BY
APR 27 2006
RESUBMIT APPROVED ✓
BY DATE 5/2/06

NO.	REVISION	BY	DATE
1	ADDED TIGHT FIT AT BOTTOM AND REVISED DIMENSION FROM STIFF. EDGE AS PER APPROVAL	WBW	4/19/06

HIGH STEEL STRUCTURES, INC.

1770 Hempstead Road
Lancaster, PA 17605-0008
Phone 717/298-5211
A Division of High Industries, Inc.

GIRDER JOB STANDARDS
RTE. NO. TH 35 (BRIDGE NO. 24) OVER PACIFIC BROOK
RTE. NO. TH 35 STA. 1+085.800 TO STA. 1+112.300
TOWN OF MONTGOMERY
FRANKLIN COUNTY, VERMONT
STATE OF VERMONT, AGENCY OF TRANSPORTATION

STATE CONTRACT OR REF. NO. PROJECT NO. BRO 1448 (20)
CONTRACTOR A.L. ST. ONGE CONTRACTOR, INC.
IN CHARGE: BRITIGAN (IH) MADE BY: RC CHK'D. BY: MGK DATE: 3/2/06
CONTRACT NUMBER: VT-06001-1 DRAWING NUMBER: X1 OF X2

NOTES:

HOLES: AS NOTED
BOLTS: NONE
PAINT: NONE
FOR GENERAL SHOP NOTES, SEE DWG. GN1.

CODE: 30

PLOTTED: DATE567890.1234567 BY: USERNAME

06001 X2 4/21/06 Final Approval and Distribution TO:A.L. St. Onge Contractor,

~~06533~~ 05833