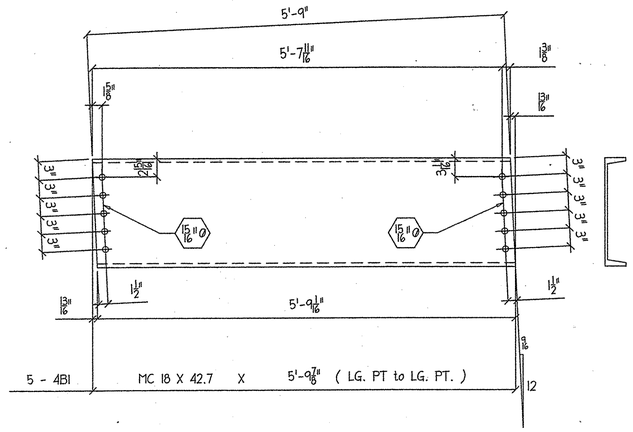

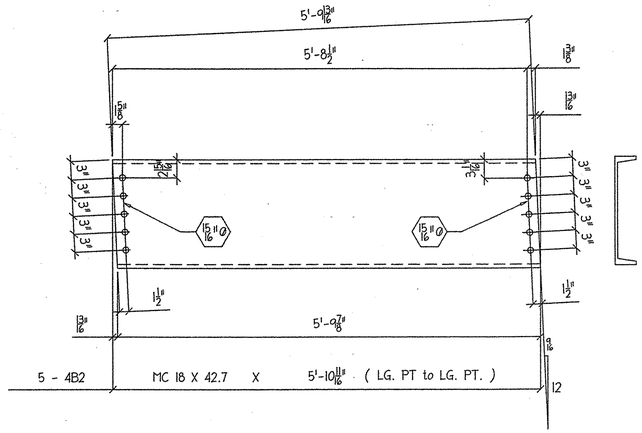

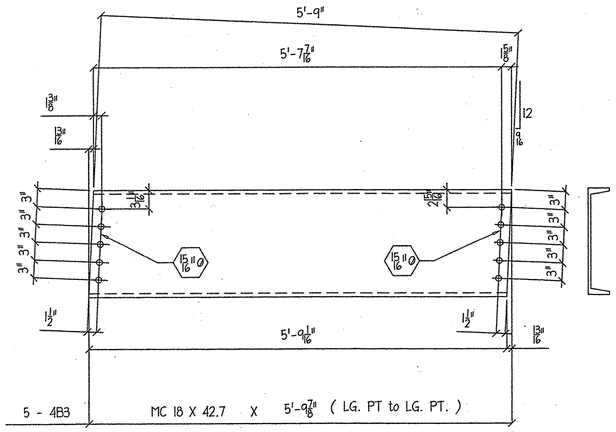

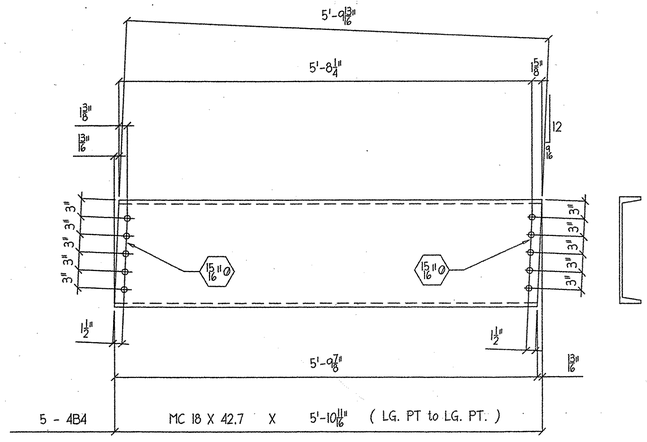

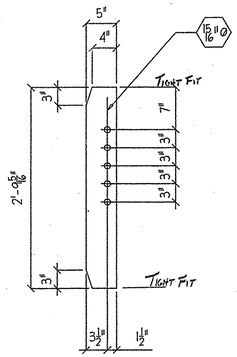

20 REQ - 4P1

PL 1/2" X 5" X 2-9 5/16

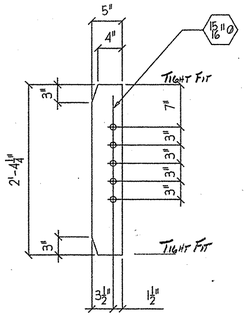

20 REQ - 4P2

PL 1/2" X 5" X 2-4 1/4

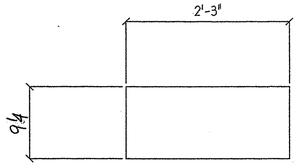

6 REQ - 4P3

PL 1/4" X 9 1/4" X 2-3

@ SHOE ABUT. #1

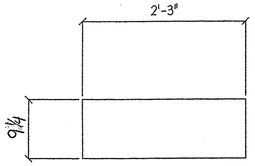

6 REQ - 4P4

PL 1/4" X 9 1/4" X 2-3

@ SHOE ABUT. #2

BILL OF MATERIAL

QTY	MARK	SHAPE	LENGTH		REMARKS
5	4B1	MC 18 X 42.7	5	9 7/8	GALV.
5	4B2	MC 18 X 42.7	5	10 11/16	
5	4B3	MC 18 X 42.7	5	9 7/8	
5	4B4	MC 18 X 42.7	5	10 11/16	
20	4P1	PL 1/2" X 5"	2	9 5/16	
20	4P2	PL 1/2" X 5"	2	4 1/4	
6	4P3	PL 1/4" X 9 1/4"	2	3	
6	4P4	PL 1/4" X 9 1/4"	2	3	

RECEIVED
OK'D BY OK'D BY
MAY 31 2006
RESUBMIT APPROVED
BY DATE 6/1/06

REV. NO.	DATE	DESCRIPTION
1	5/3	PER ENG.

HOLES: 13/16"ø (U.N.O.) DATE: 3-16-06
PAINT: GALVANIZED

BMS. 4B1 to 4B4
PL. 4P1 & 4P2

DATE SUB.	PROJECT	MONTGOMERY VT. BRIDGE VT. ROUTE 118 , BRIDGE #21
	LOCATION	MONTGOMERY, VT.
	ARCHITECT	
DATE APP.	ENGINEER	STATE OF VERMONT , AGENCY OF TRANSPROTATION
DATE DIST.	CUSTOMER	A.L. ST. ONGE CONST.

MERRIMACK
MISCELLANEOUS IRON STRUCTURAL STEEL FABRICATORS
MERRIMACK SHEET METAL
119 HALL ST.
CONCORD, N.H., 03301
TEL. (603) 224-7766
FAX. (603) 224-7925

DR BY KJM
REV BY
JOB NO. 0770
DWG NO. F4

072-85