621.81 REMOVAL AND DISPOSAL OF GUARDRAIL

BARRE CITY:
STA. 5+300.0 - STA. 5+478.0 RT (122.0 m)

621.20 STEEL BEAM GUARDRAIL WITH 2.4 m POSTS (MOD.)

BARRE CITY:
STA. 5+300.0 - STA. 5+478.9 RT (178.9 m)

621.60 ANCHOR FOR STEEL BEAM GUARD RAIL

BARRE CITY:
STA. 5+478.9 RT

646.40 DURABLE 100 mm WHITE LINE
(ALL LINES WILL INCLUDE EDGE LINE BREAKS AND RADIUS FOR TOWN HIGHWAYS)

BARRE CITY:
STA. 5+300.0 - STA. 5+421.880 LT & RT

646.60 TEMPORARY 100 mm WHITE LINE
(ALL LINES WILL INCLUDE EDGE LINE BREAKS AND RADIUS FOR TOWN HIGHWAYS)

BARRE CITY:
STA. 5+300.0 - STA. 5+421.880 LT & RT

646.41 DURABLE 100 mm YELLOW LINE
(ALL LINES WILL INCLUDE C/L BREAKS FOR TOWN HIGHWAYS) S=SOLID, D=DASHED

BARRE CITY:	LT	℄	RT
STA. 5+300.0 - STA. 5+421.880	S	-	S

646.61 TEMPORARY 100 mm YELLOW LINE
(ALL LINES WILL INCLUDE C/L BREAKS FOR TOWN HIGHWAYS) S=SOLID, D=DASHED

BARRE CITY:	LT	℄	RT
STA. 5+300.0 - STA. 5+421.880	S	-	S

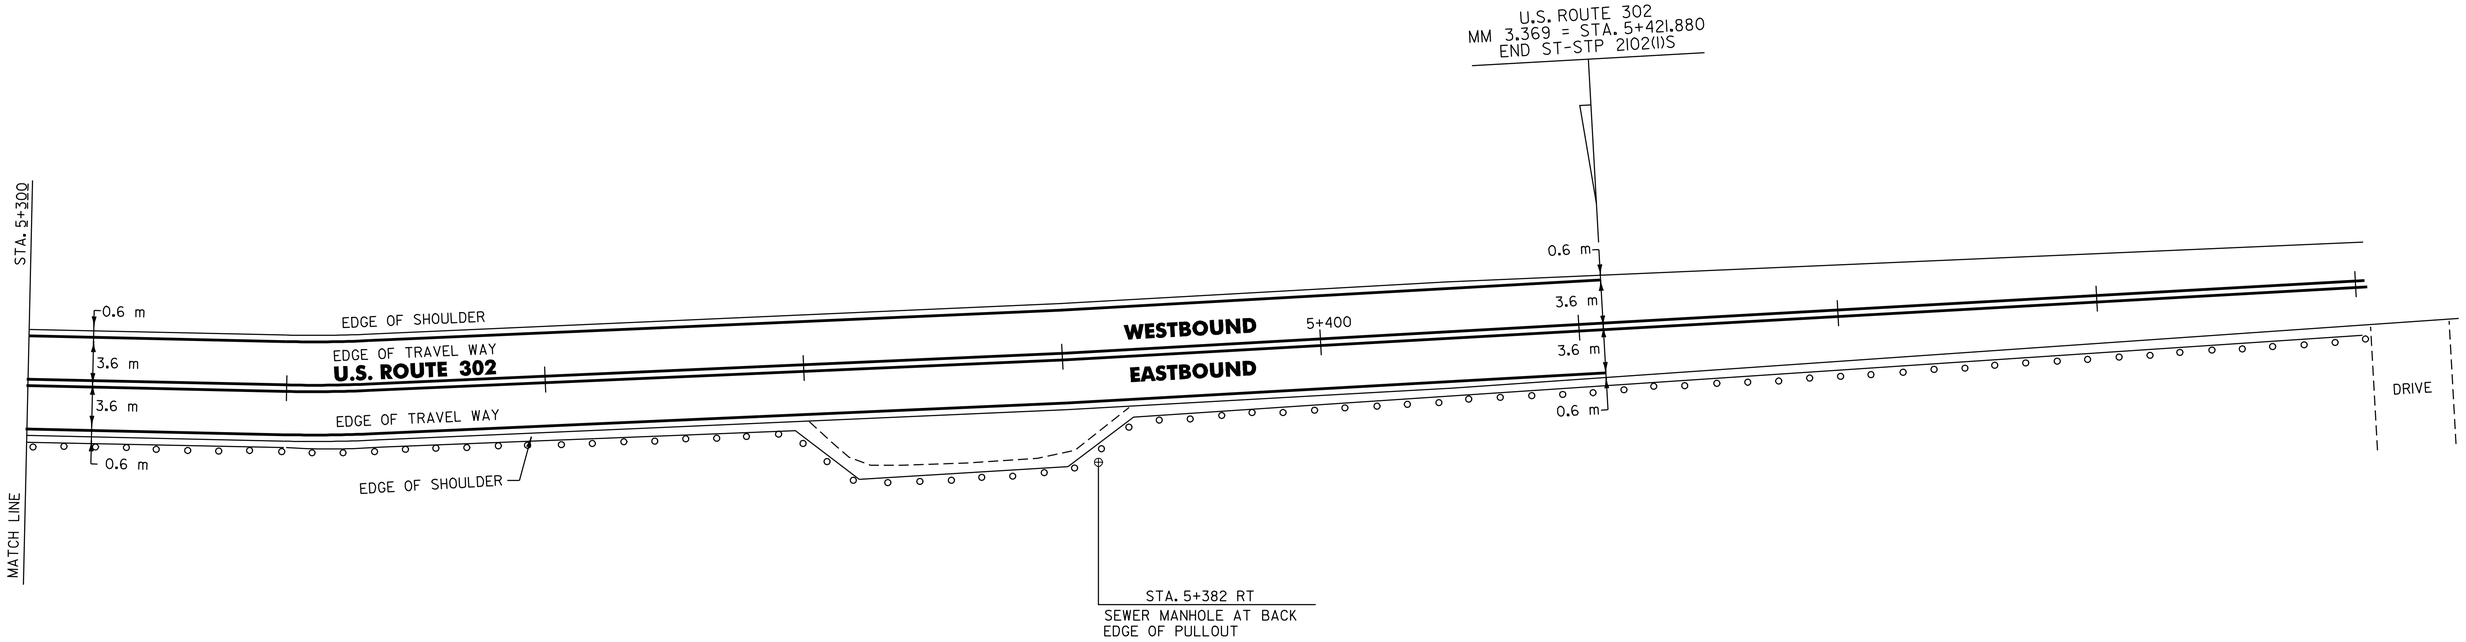

DATUM
VERTICAL N/A
HORIZONTAL N/A

PAVING PROJECT LAYOUT # 12

SURVEYED BY N/A DATE N/A
DRAWN BY C.A.K. DATE 2/02
SQUAD LEADER D.E.G.
DESIGN FILE NO. /pave/98d086/zd086.dgn
IPARM FILE zd086pl2.i DATE PLOTTED 25-APR-2006 14:
PROJ. NAME BARRE CITY
PROJ. NO. ST-STP 2102(1)S
SHEET 21 OF 32 SHEETS