STATE OF VERMONT
AGENCY OF TRANSPORTATION

TRAFFIC SIGN SUMMARY SHEET 19

MILEMARKER, STATION, OR SIGN NUMBER	SIGN LEGEND	SIGN DIMENSIONS EA	WIDTH (in)	HEIGHT (in)	NEW & SALVAGED SIGNS "A"	"B"	SALV SIGN	SALV TIS	EXIST POST RETAIN	EXIST POST SALVAGE	NEW SIGN POSTS NO. OF POSTS	FLANGED CHANNEL lb/ft 1.12	2.0	3.0	SQUARE STEEL (in) lb/ft 1.75 1.88	2.0 2.16	2.5 3.35	ANCHOR	SLEEVE	TUBULAR ALUMINUM Ø (in) lb/ft 3.0 1.3	4.0 1.7	4.0 MOD 1.7	TUBULAR STEEL Ø (in) FOUND-ATION	lb/ft 3.0 7.6	3.5 9.0	4.0 10.8	5.0 14.6	W-SHAPE STEEL FTG. SIZE 24"	24"	WEIGHT	POST SIZE	SIGN FRAME REQUIRED	REMARKS	SIGN DETAIL DETAIL ON DWG. NUMBER	STD. SHEET NUMBER
												OPTION ITEMS ( )																									
CLARENDON: 265+77.0, RT		1	36	36	9.00						2			X 39.16																			SIGN ID CODE W3-3		E-152
		1	36	36	9.00																												SIGN ID CODE W11-8	78	
270+50.0, RT		1 1	48 36	24 36	10.00 9.00						2			X 28.75																			BACK TO BACK SIGN ID CODE VR-934 SIGN ID CODE R5-1		E-145B E-143
273+00.0, LT		1 1	30 36	30 48	6.25 12.00						2			X 29																			BACK TO BACK SIGN ID CODE R3-7L SIGN ID CODE R4-7		E-140 E-144
		1	18	18	2.25																												SIGN ID CODE OM1-1		E-150
273+49.0, RT	NORTH SHREWSBURY →						1				~~2~~ 1		X 11.50			X		X															SALVAGED SIGN SHALL BE MOUNTED ON NEW POST.	-	-
273+49.0, RT	LEGAL LOAD LIMIT 24,000 POUNDS	1	24	30	5.00						1			X 13	X			X															SIGN ID CODE VR-017		E-141
274+12.0, RT	ONE WAY	1 1	36 36	12 12	3.00 3.00						1			X 13		X		X															BACK TO BACK SIGN ID CODE R6-1R SIGN ID CODE R6-1L		E-142 E-142
	DIVIDED HIGHWAY 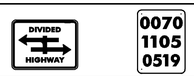 0070 1105 0519	1 1	24 6	18 10	3.00 0.42																												BACK TO BACK SIGN ID CODE R6-3 SIGN ID CODE VD-700	78	E-138
					FT	FT - (28.0)	FT 84 (28.0)		FT - (14.0)	FT - (42.0)	FT		EA	LB	LB	LB		LB	LB	LB	LB													
					134.41																															
TOTALS		SF 71.92	SF	EA. 1	SF		FT 84 (56.0)		FT - (56.0)				LB				EA.	LB				EA.	EA.	LB											

FINAL POST LENGTHS ARE TO BE DETERMINED IN THE FIELD. POST SIZES ARE COMPUTED BASED ON INFORMATION FURNISHED ON THE STANDARD SHEETS AND THE TRAFFIC OPERATIONS SECTION "SIGN POST DESIGN GUIDELINE."

PROJECT NAME: WALLINGFORD - RUTLAND TOWN
PROJECT NUMBER: AC NH 2207(1)S

FILE NAME: p99b166.dgn
PROJECT LEADER: D.E.G.
DESIGNED BY: D.W.E.
DRAWN BY: M.L.M.
CHECKED BY: D.E.G.
PLOT DATE: 12-MAR-2007 11:32
SHEET 64 OF 95